WEST

EAST

2600'

No 1 ADIT 2488'

No 1 LEVEL 2428'

No 1A LEVEL 2410'

No 2 LEVEL 2378'

No 3 LEVEL 2354'

No 4 LEVEL 2315'

No 5 LEVEL 2281'

No 6 LEVEL 2266'

No 6A LEVEL 2234'

No 7 LEVEL 2216'

No 7A LEVEL 2192'

No 7B LEVEL 2180'
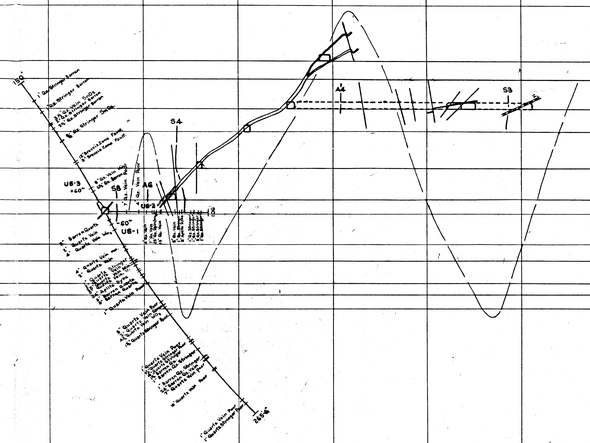
No 8 LEVEL 2168'