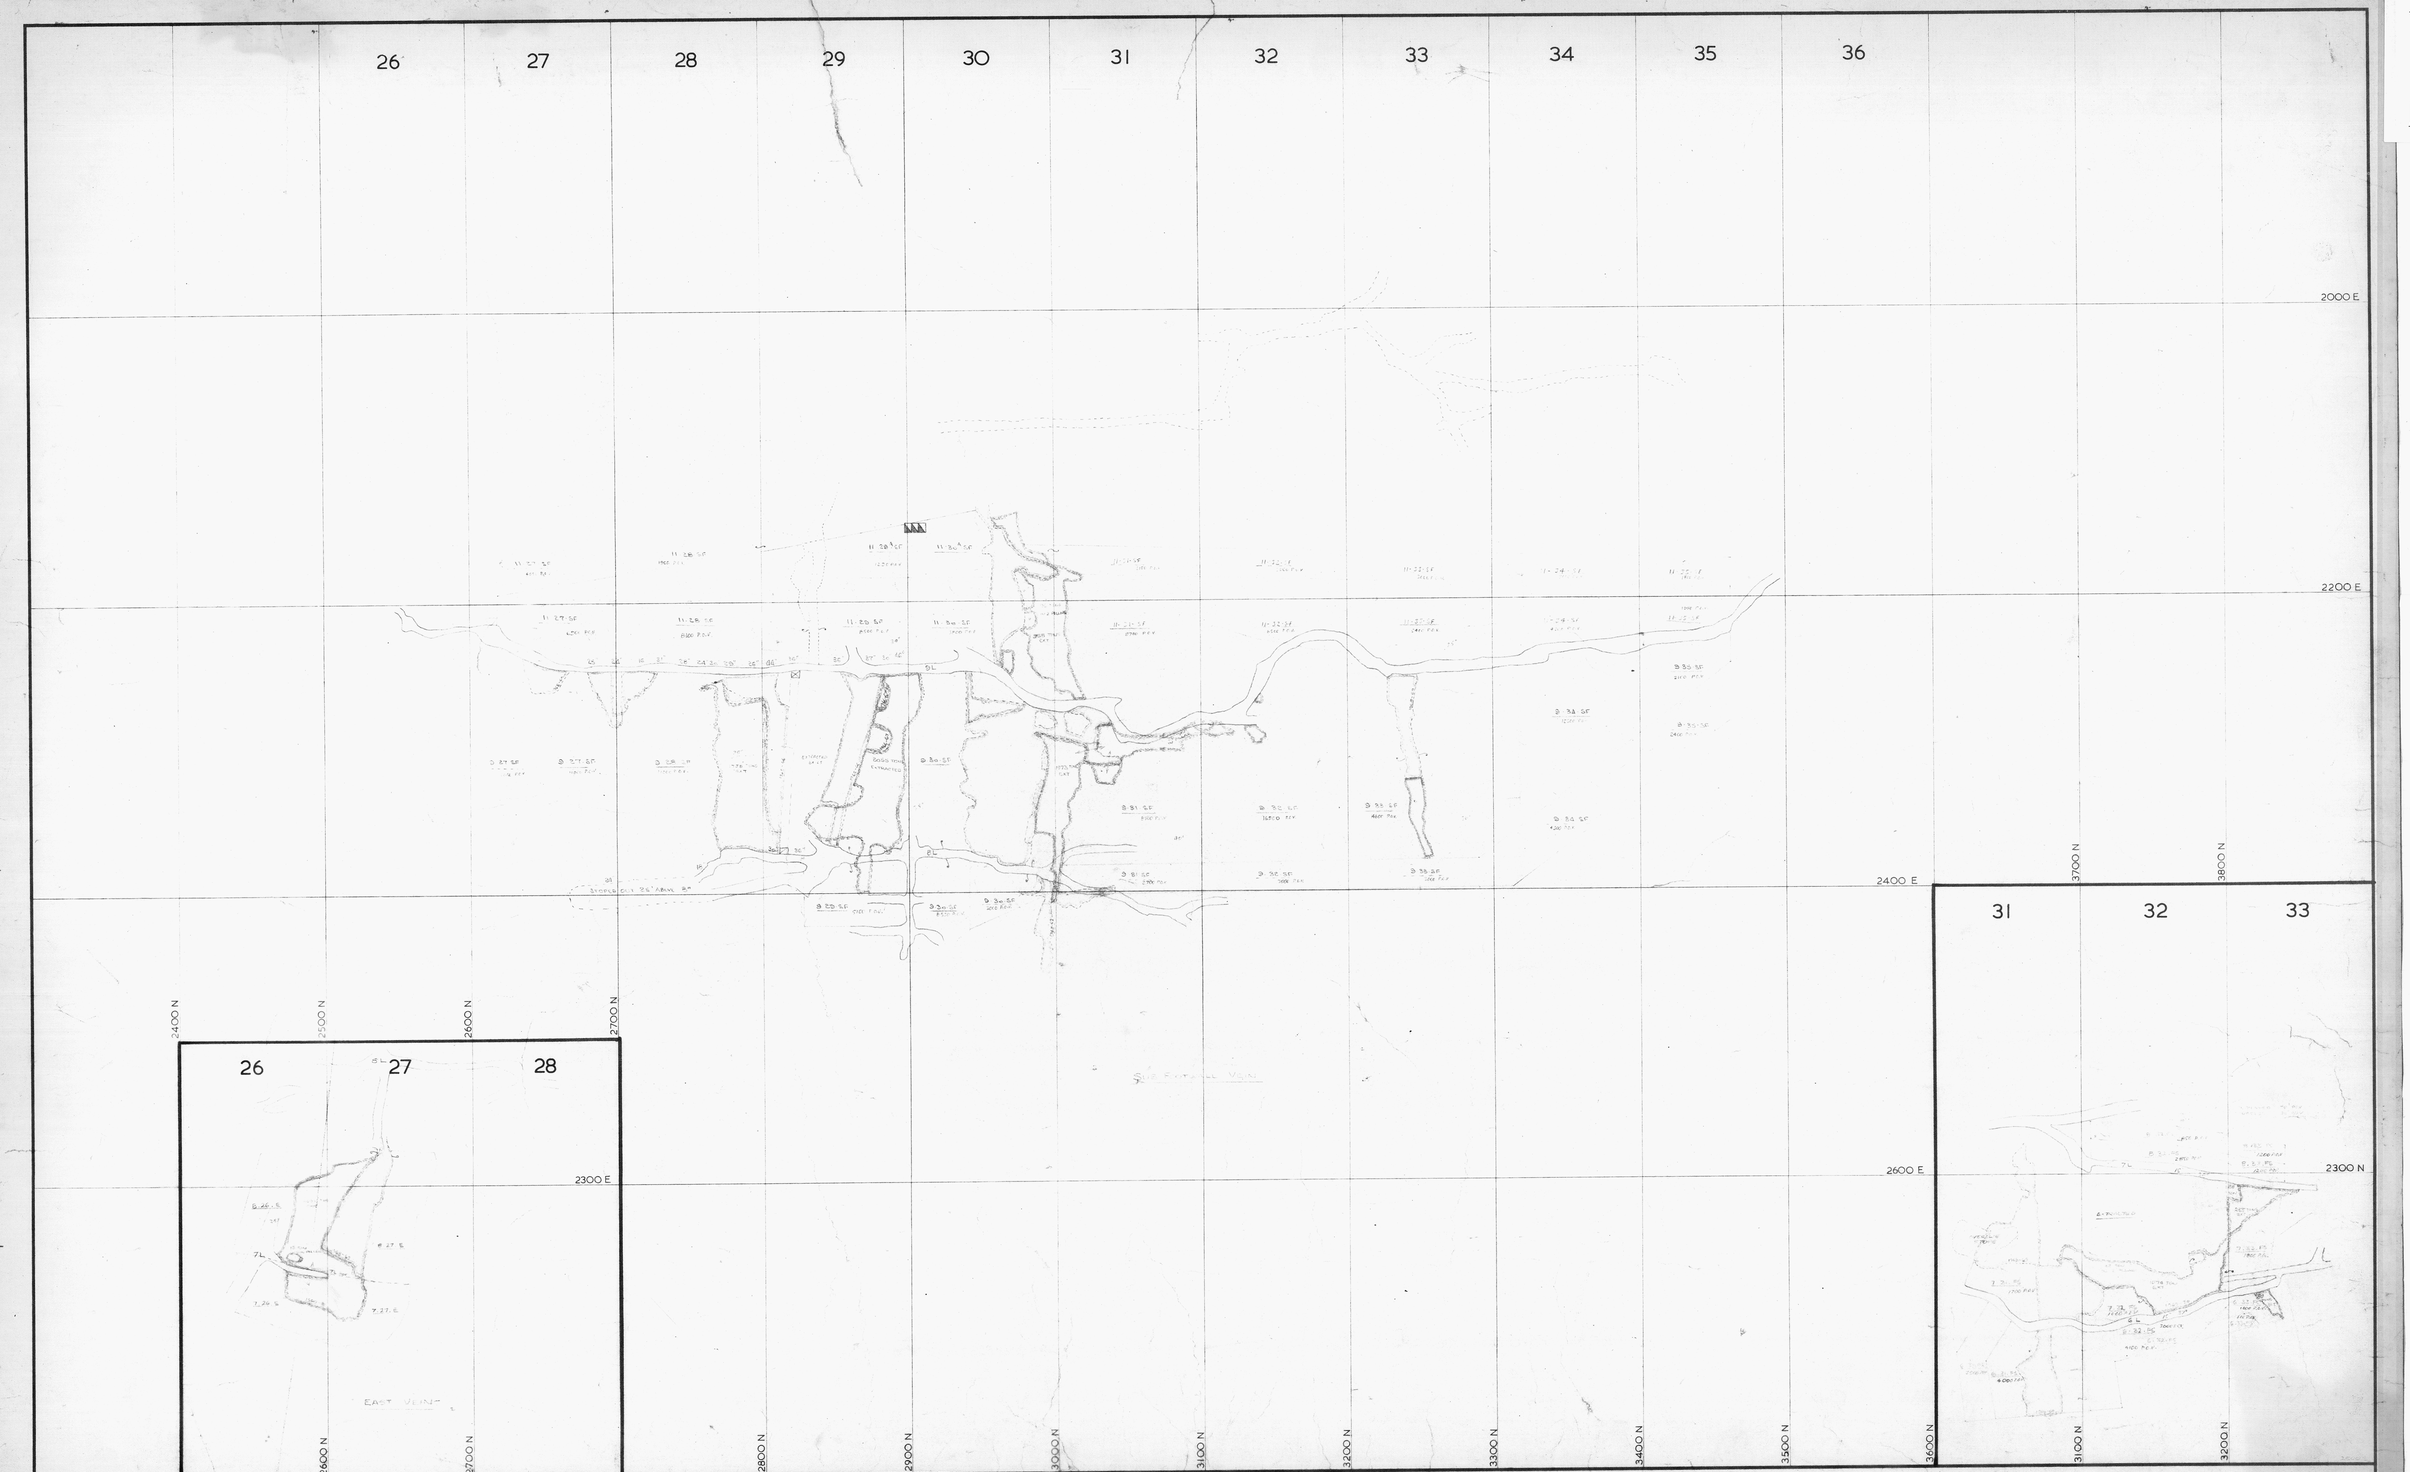

40 0 40 80
SCALE OF FEET

ORE RESERVE PLAN

SURVEY – – / /
GEOLOGY – – / /
ENGINEERING – – / /
DRAWN – B.R.J – / 6 / 79
TRACED – – / /
REFERENCE –
PRINT No. –

DRAWING No.- SC-OR-01

DRAWER :

SC.02.01

104