


5 cm

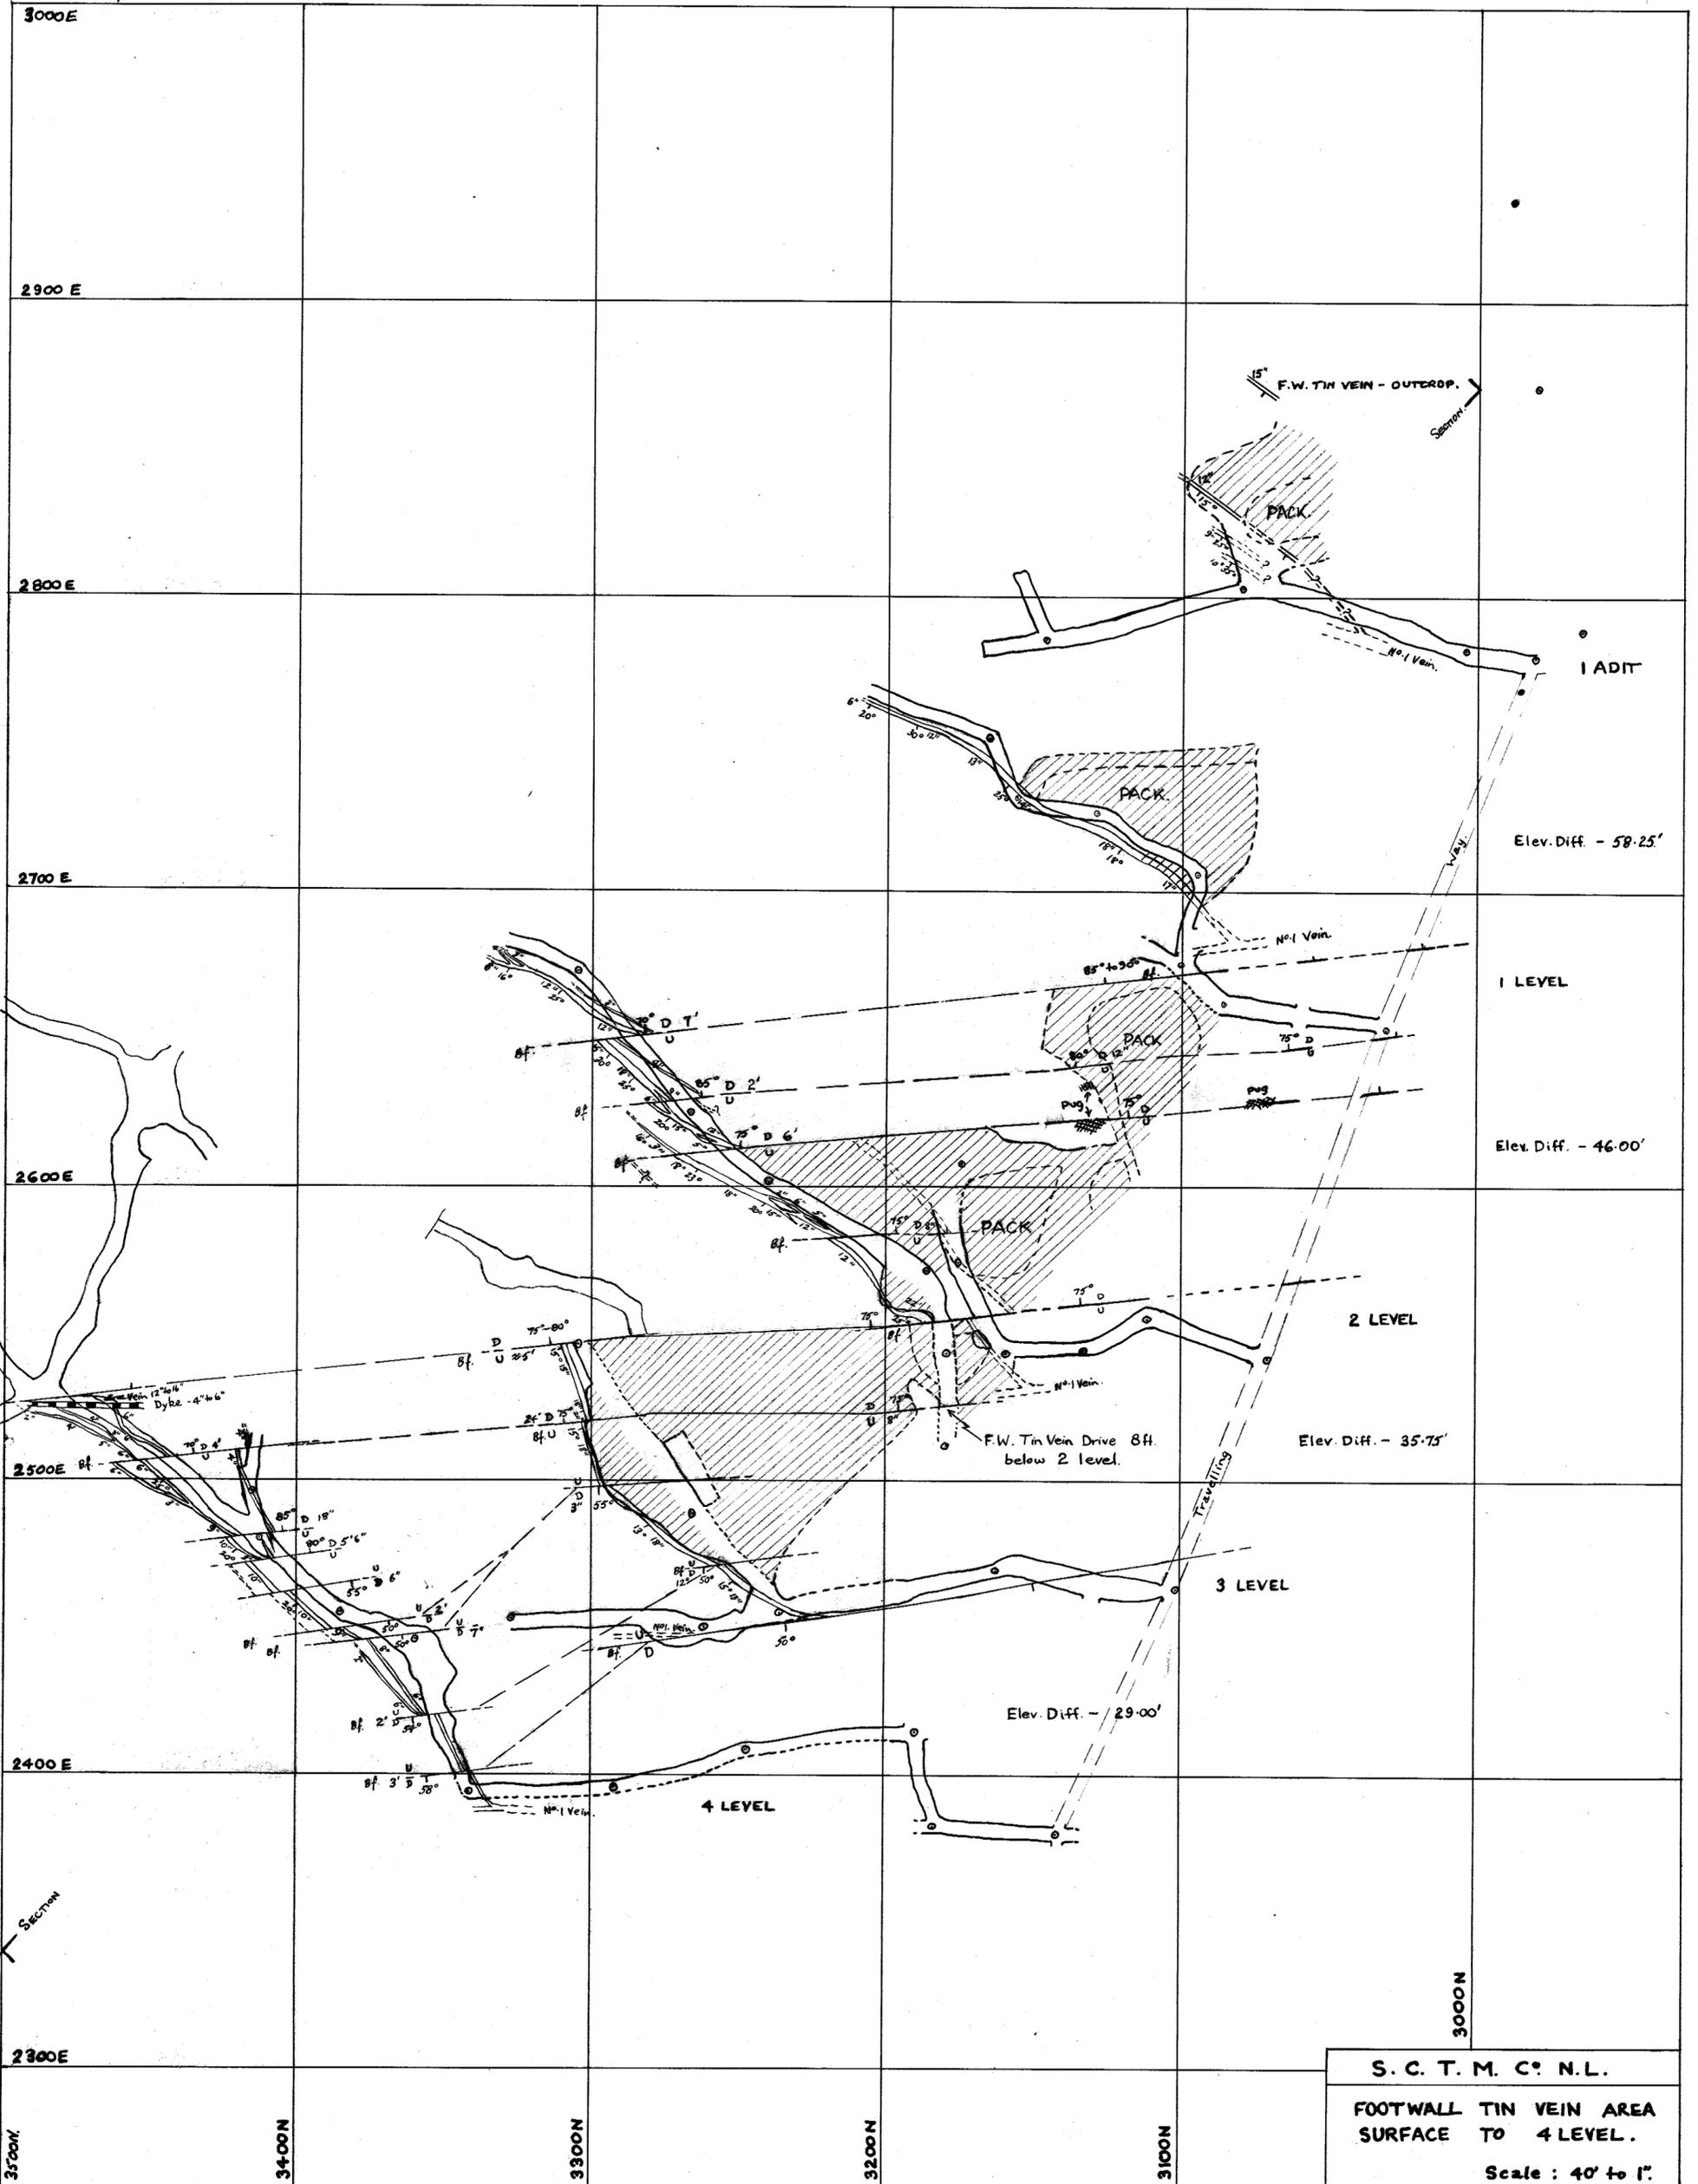

S. C. T. M. C. N.L.  
 FOOTWALL TIN VEIN AREA  
 SURFACE TO 4 LEVEL.  
 Scale : 40' to 1"