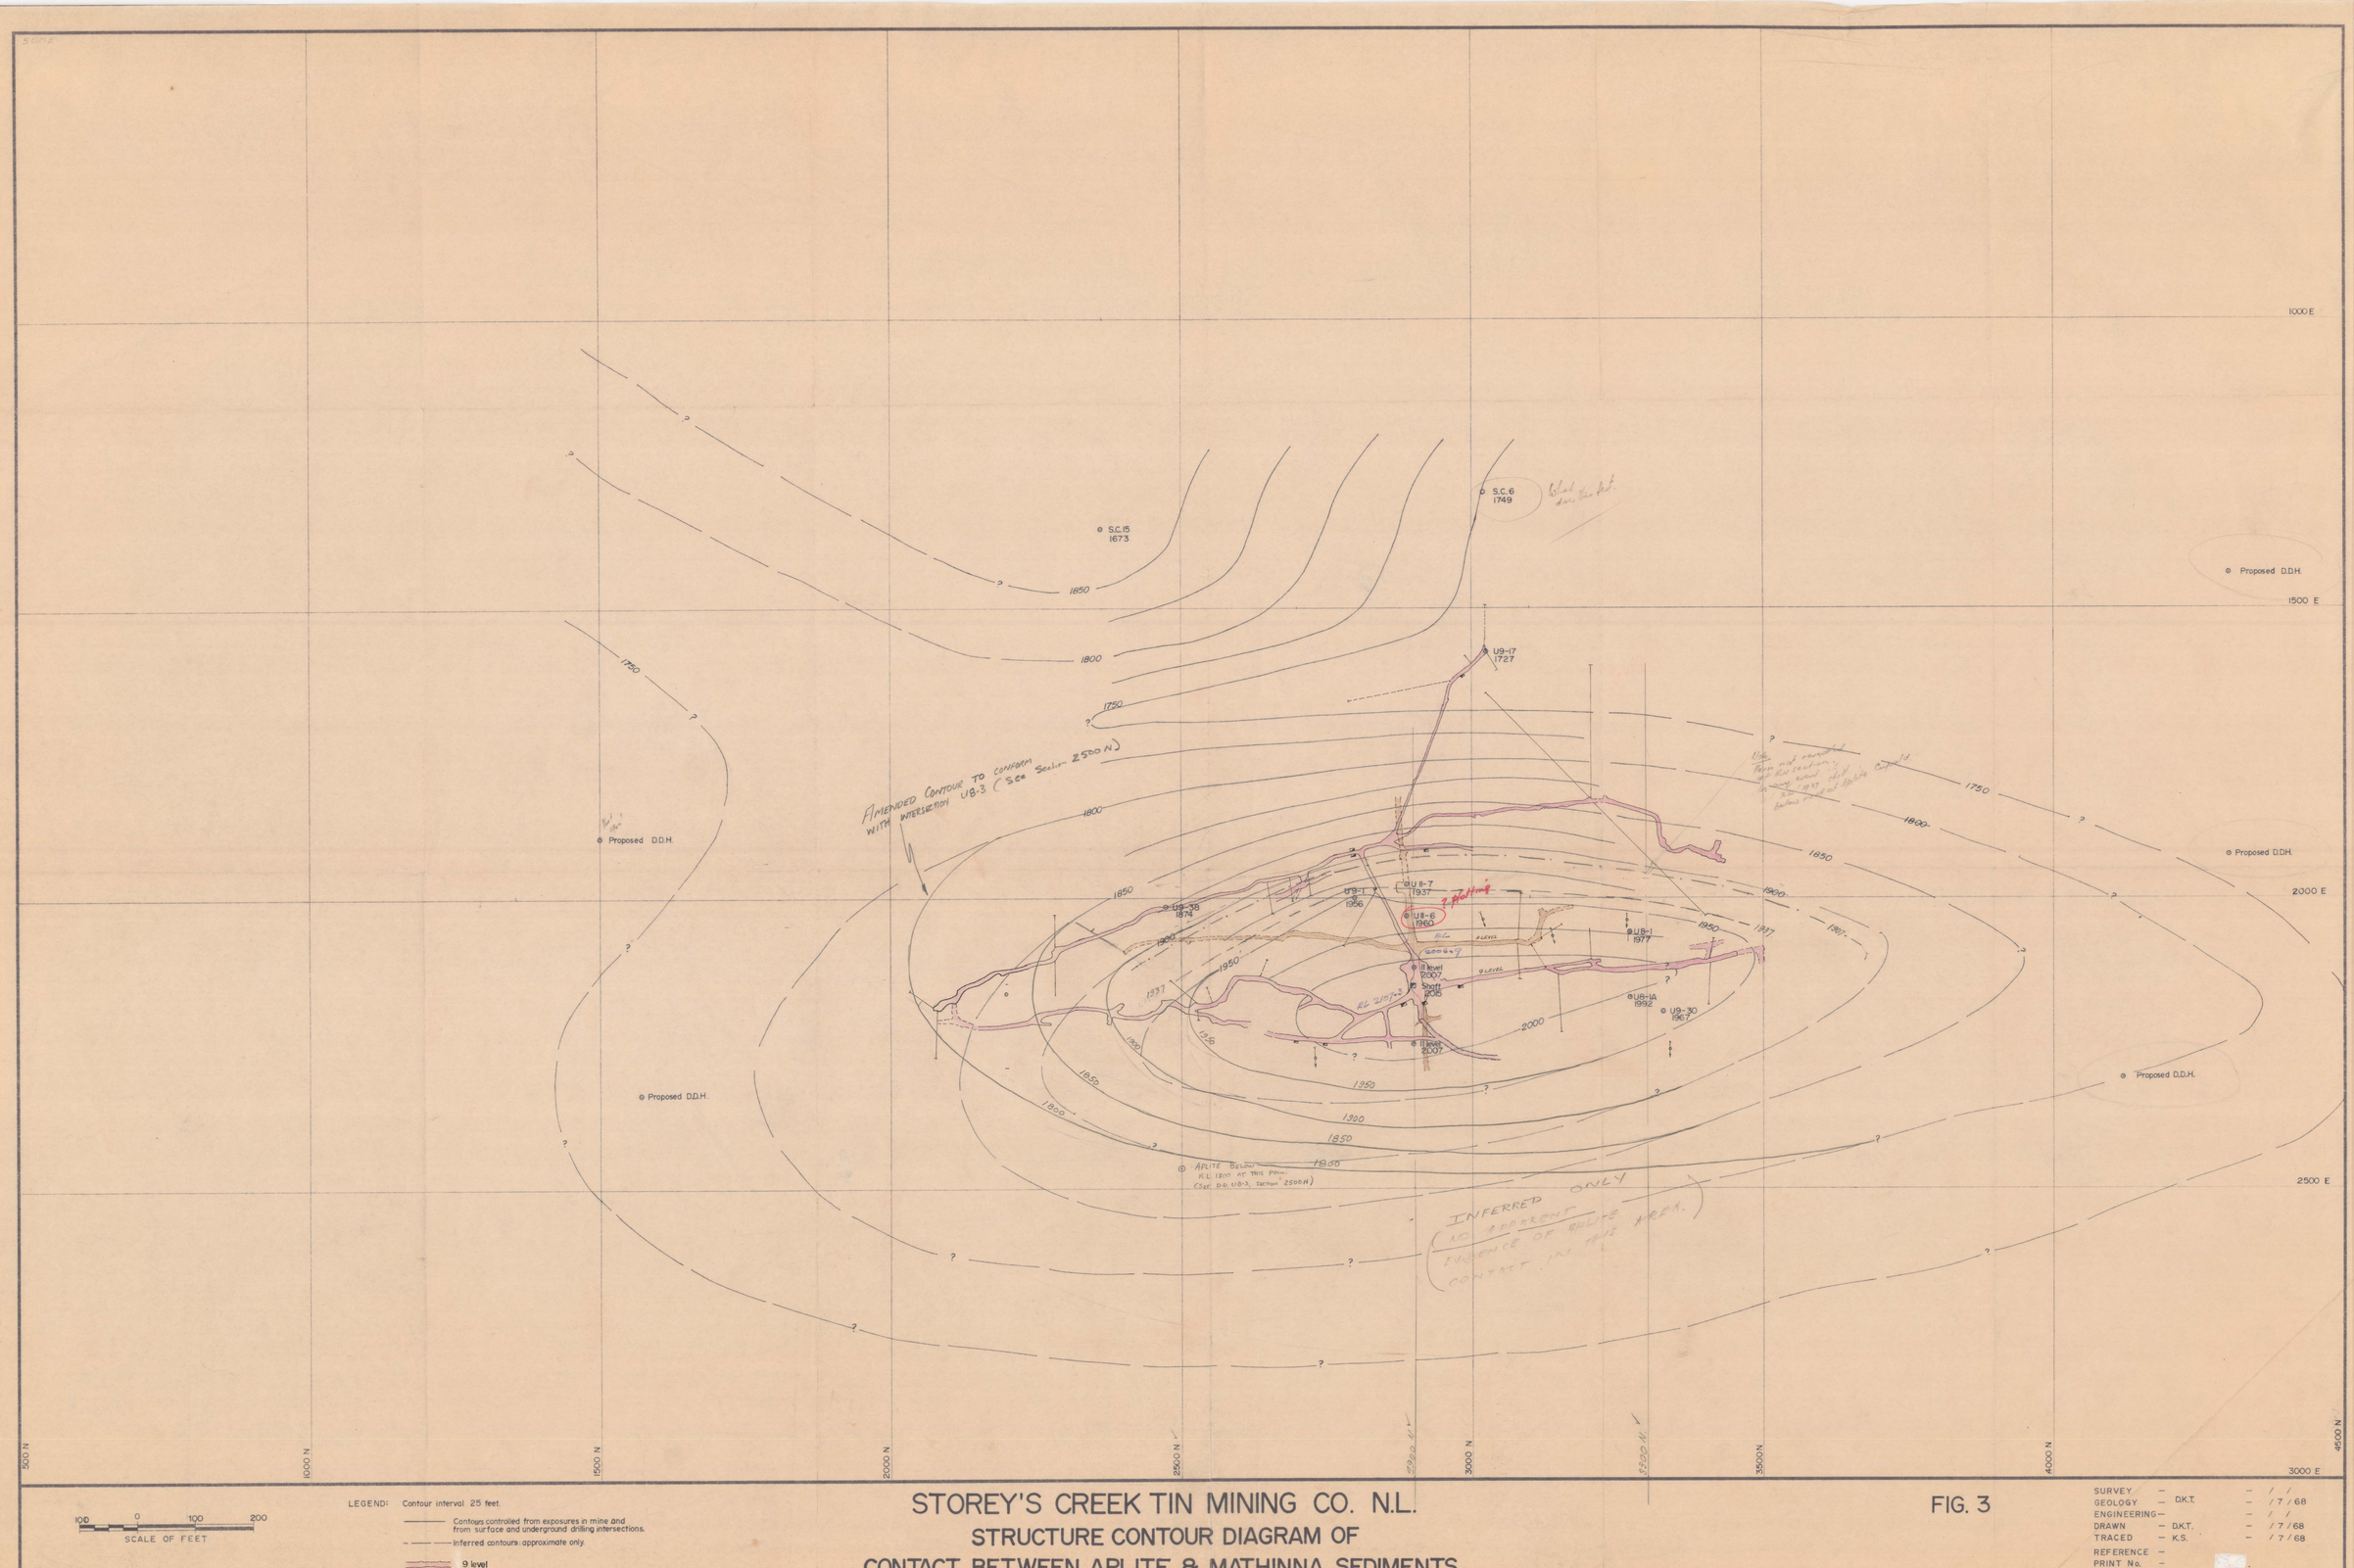

100 0 100 200
SCALE OF FEET

LEGEND: Contour interval 25 feet.

Contours controlled from exposures in mine and from surface and underground drilling intersections.

Inferred contours: approximate only.

9 level

11 level

STOREY'S CREEK TIN MINING CO. N.L.

STRUCTURE CONTOUR DIAGRAM OF CONTACT BETWEEN APLITE & MATHINNA SEDIMENTS

FIG. 3

SURVEY	–		– / /
GEOLOGY	–	D.K.T.	– / 7 / 68
ENGINEERING	–		– / /
DRAWN	–	D.K.T.	– / 7 / 68
TRACED	–	K.S.	– / 7 / 68
REFERENCE	–		
PRINT No.	–		

DRAWING No. – SC – 115 – G

DRAWER:

ABERF_148
148
COLOUR