Reduce to $6\frac{3}{4}''$

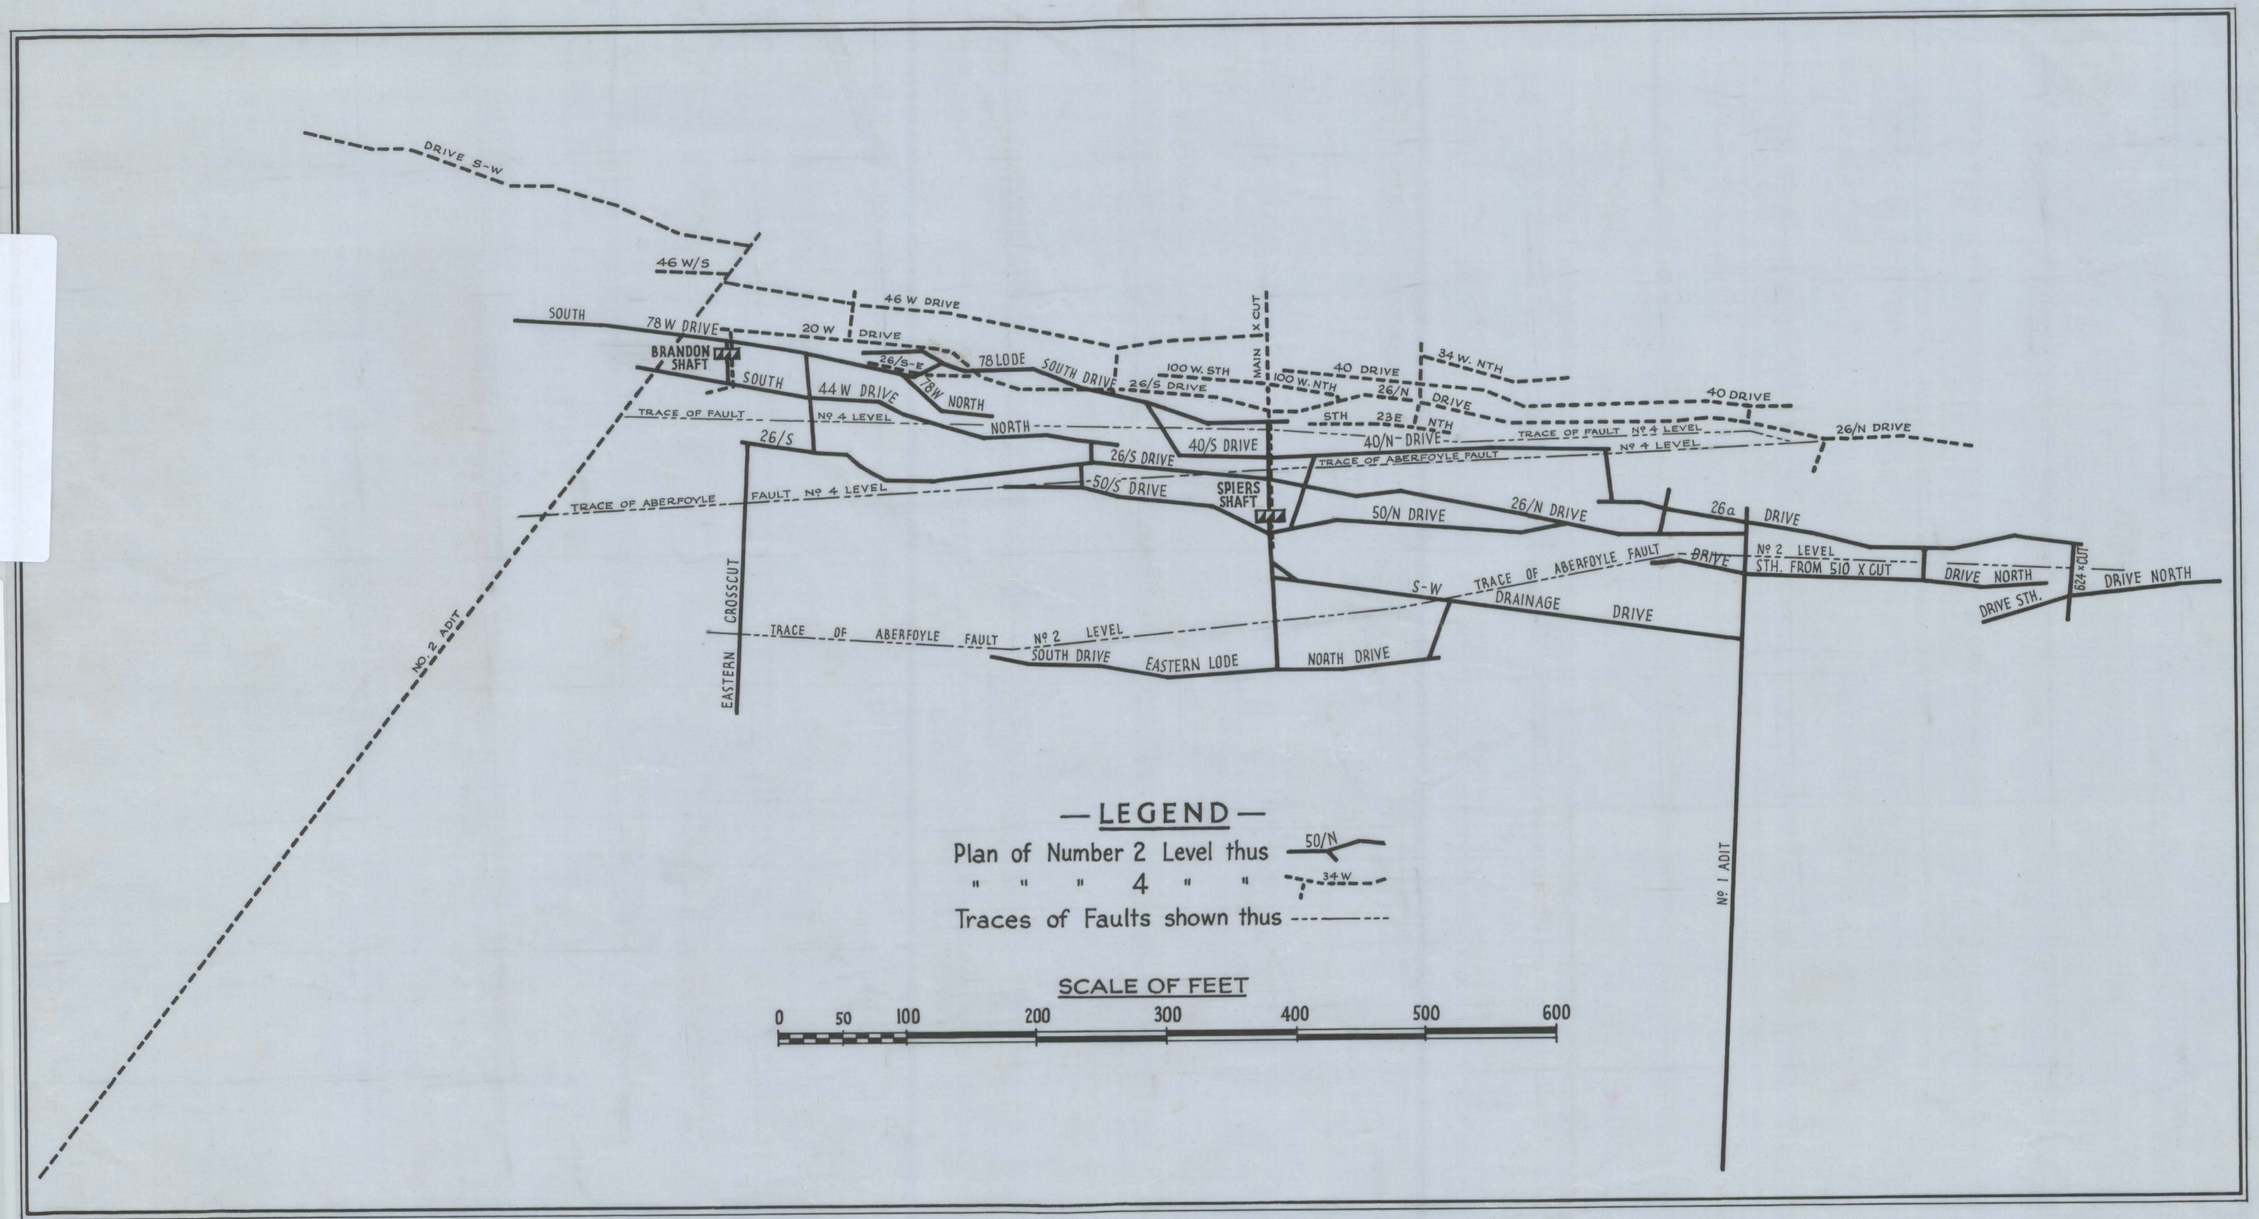

Plans Nº 2, 4 Levels.

164
ABERF_164
5 cm