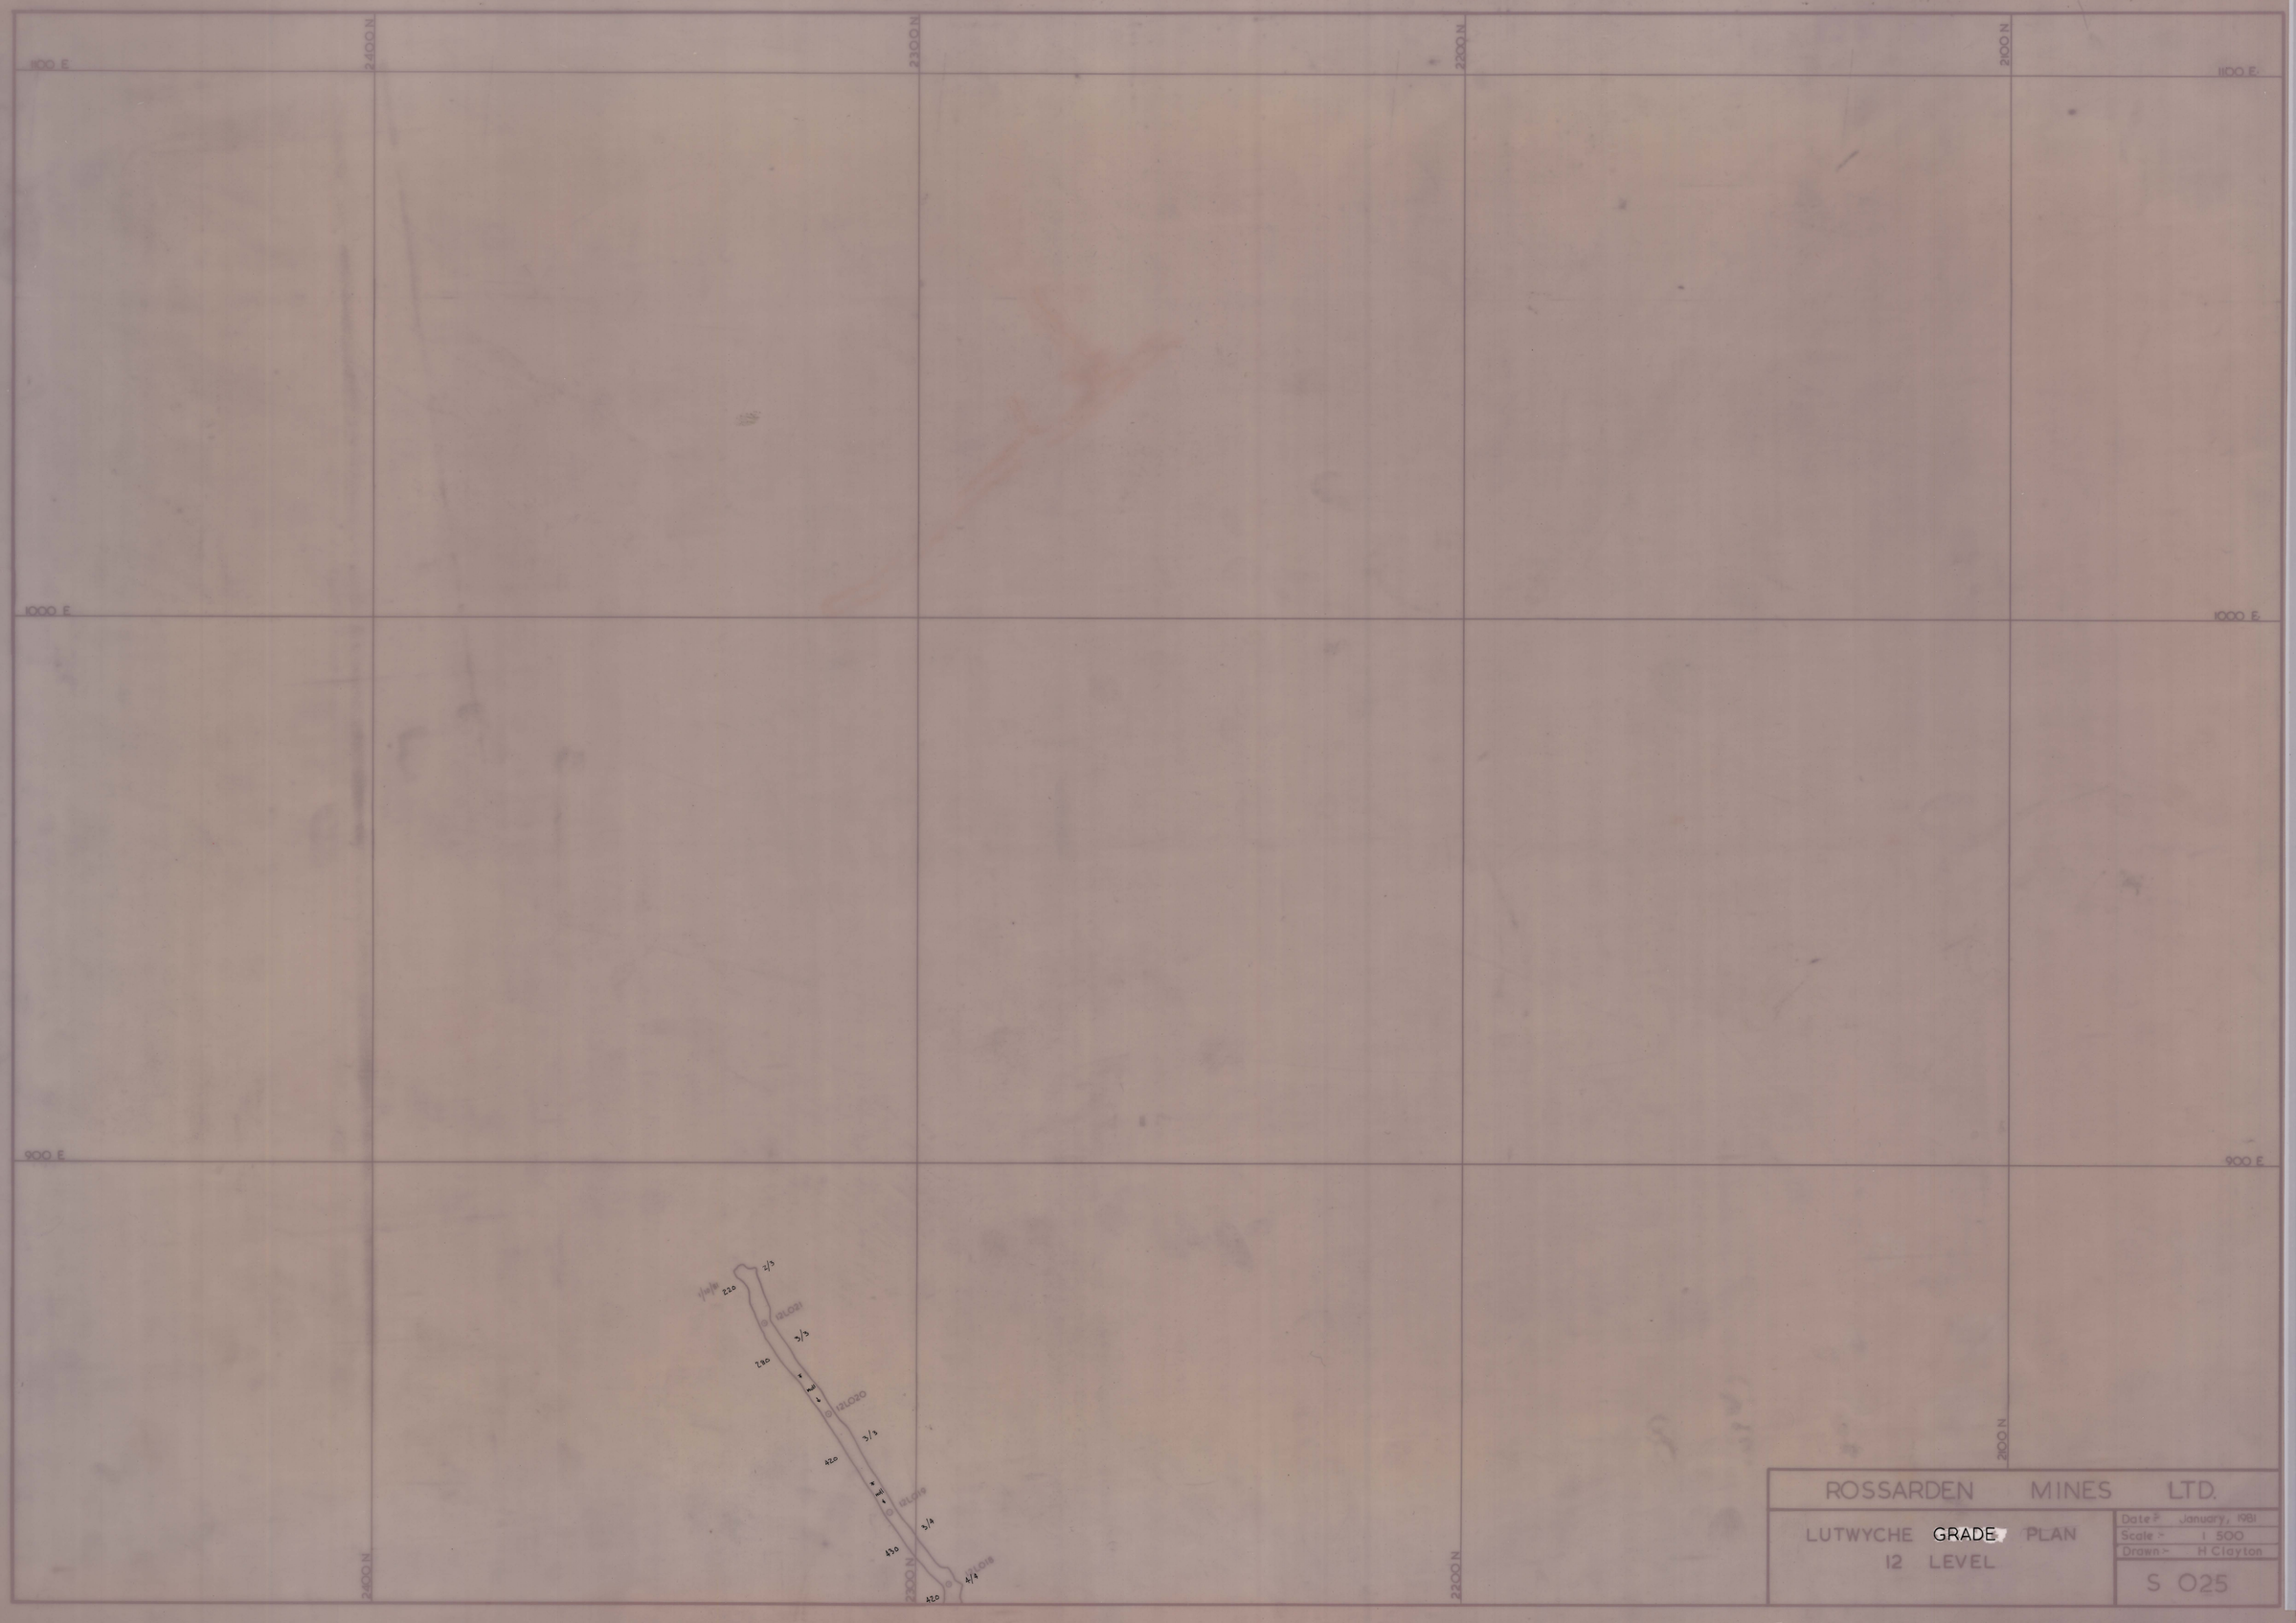

ABERF_471
471