482

ABERF_482

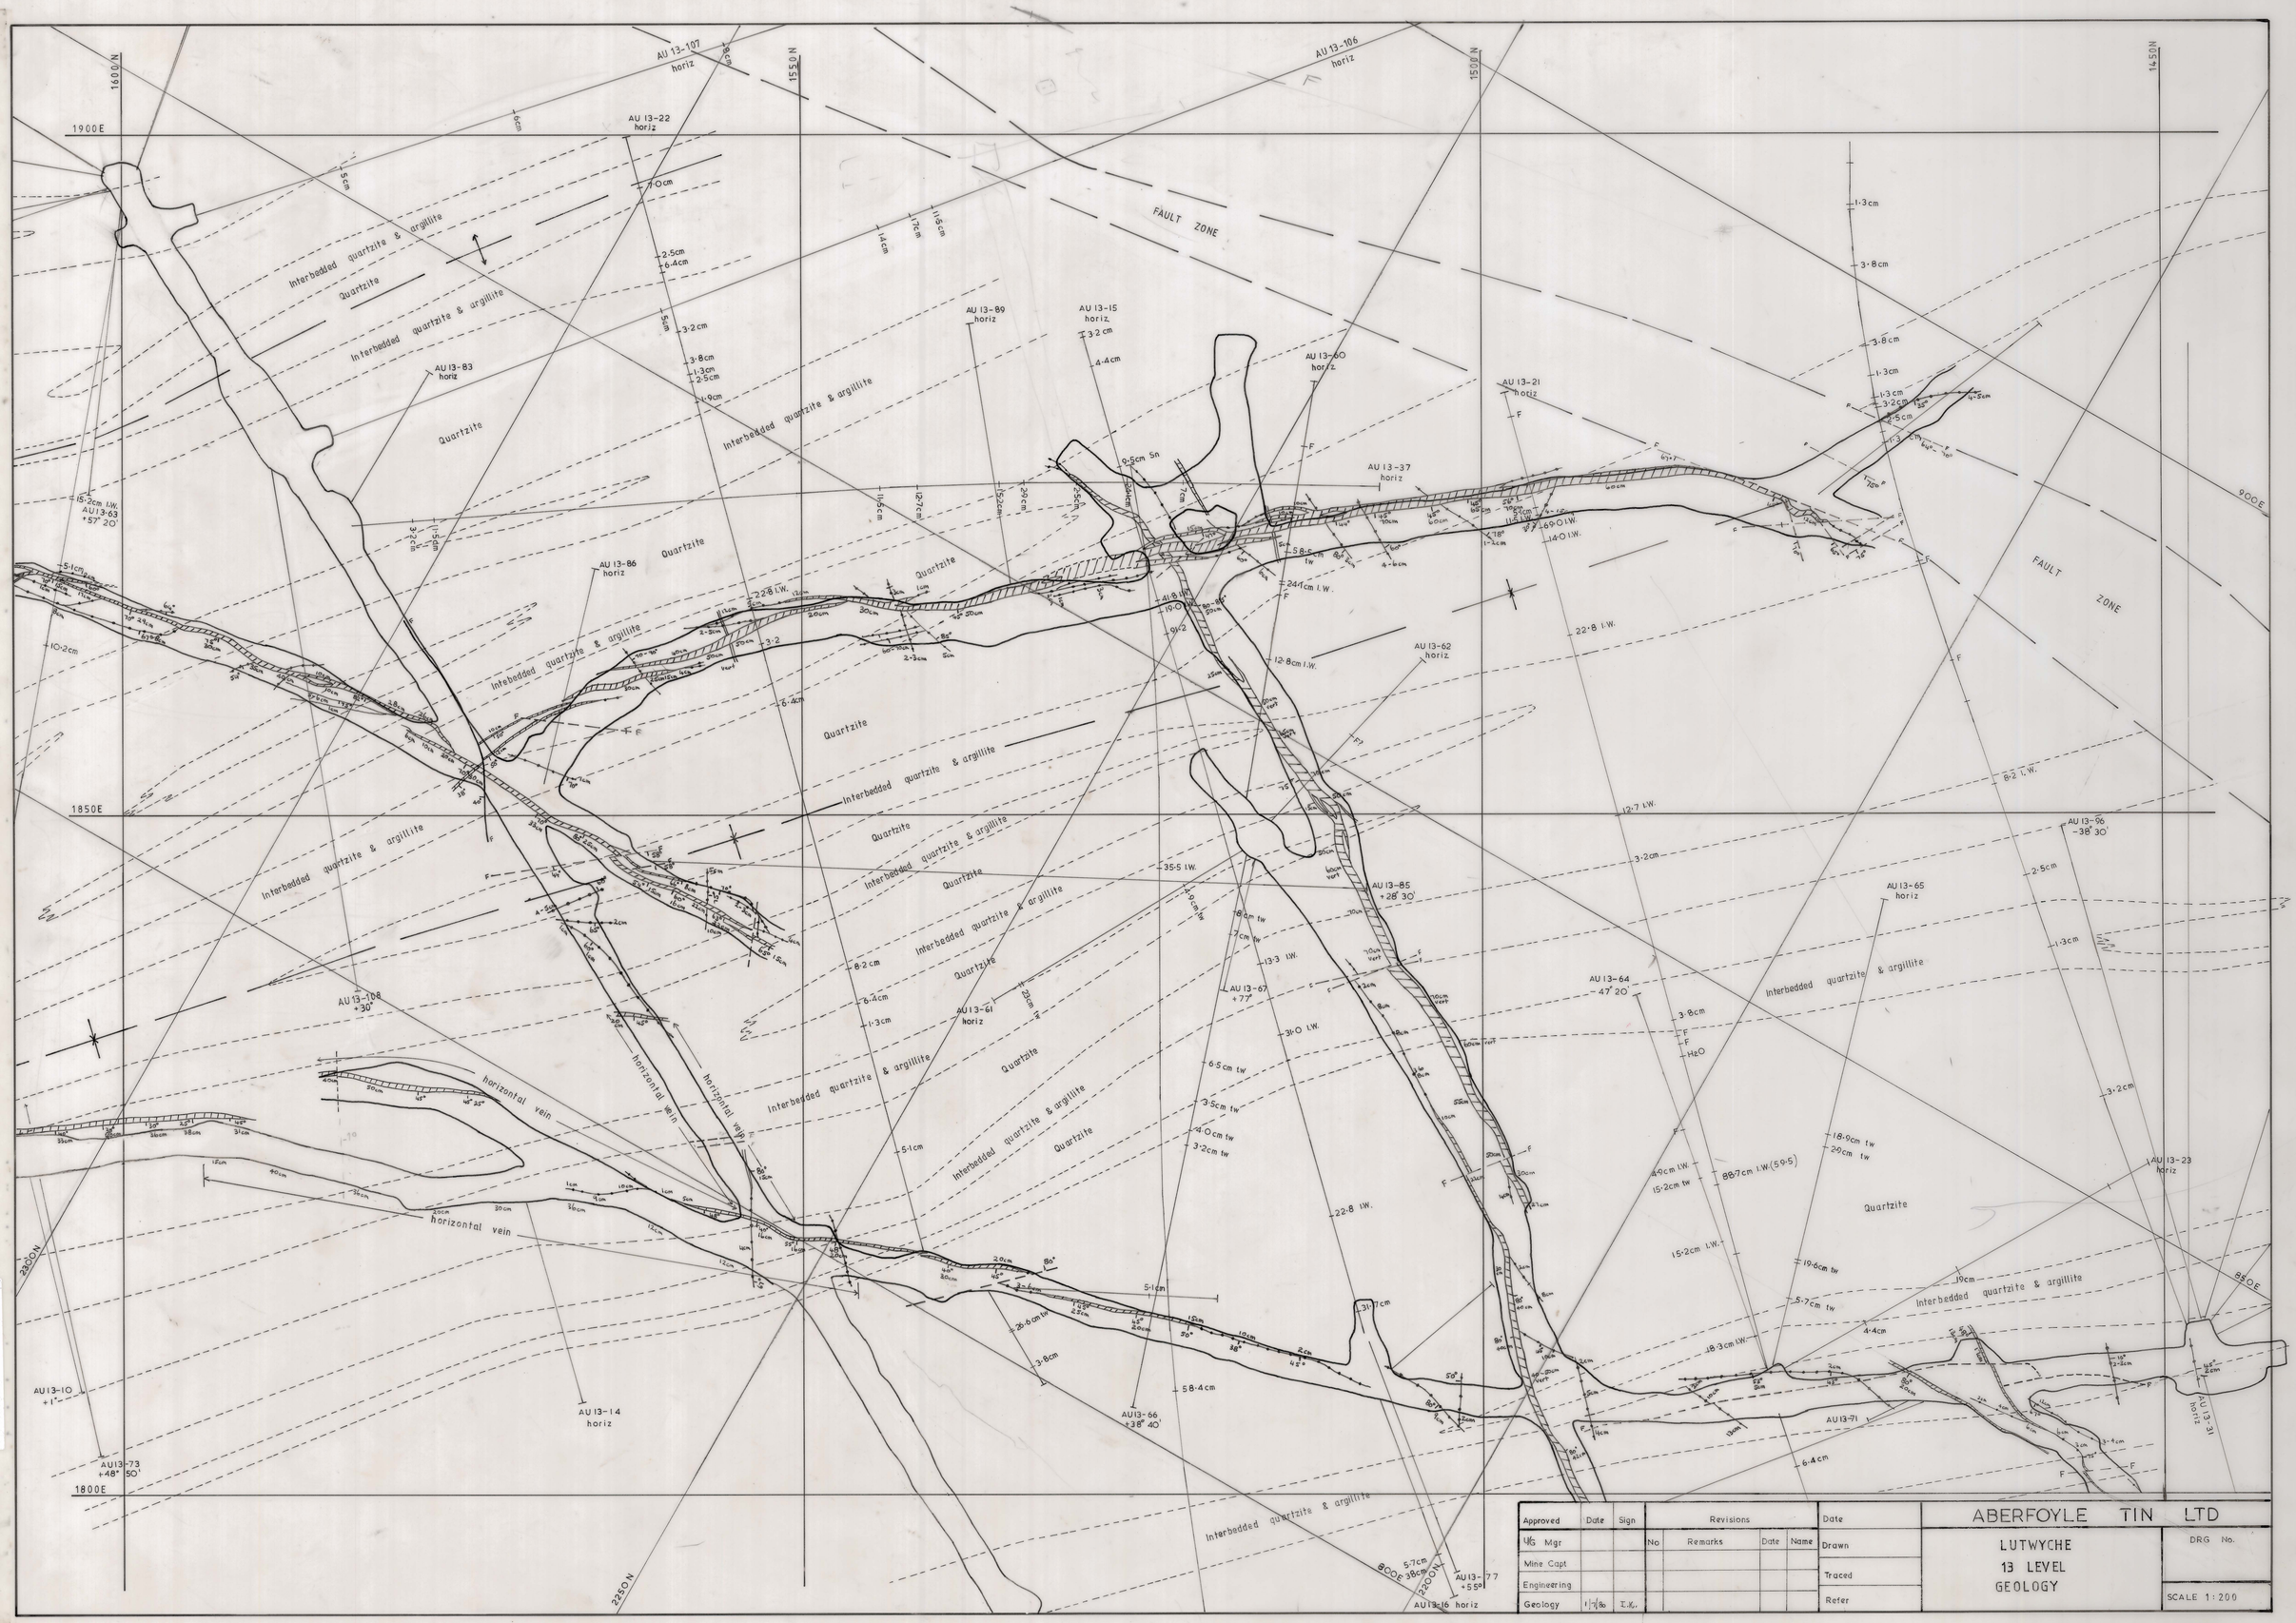

Approved	Date	Sign	Revisions				Date	ABERFOYLE TIN LTD
U/G Mgr			No	Remarks	Date	Name	Drawn	LUTWYCHE 13 LEVEL GEOLOGY
Mine Capt							Traced	DRG No.
Engineering							Refer	
Geology	1/7/80	I.M.						SCALE 1:200