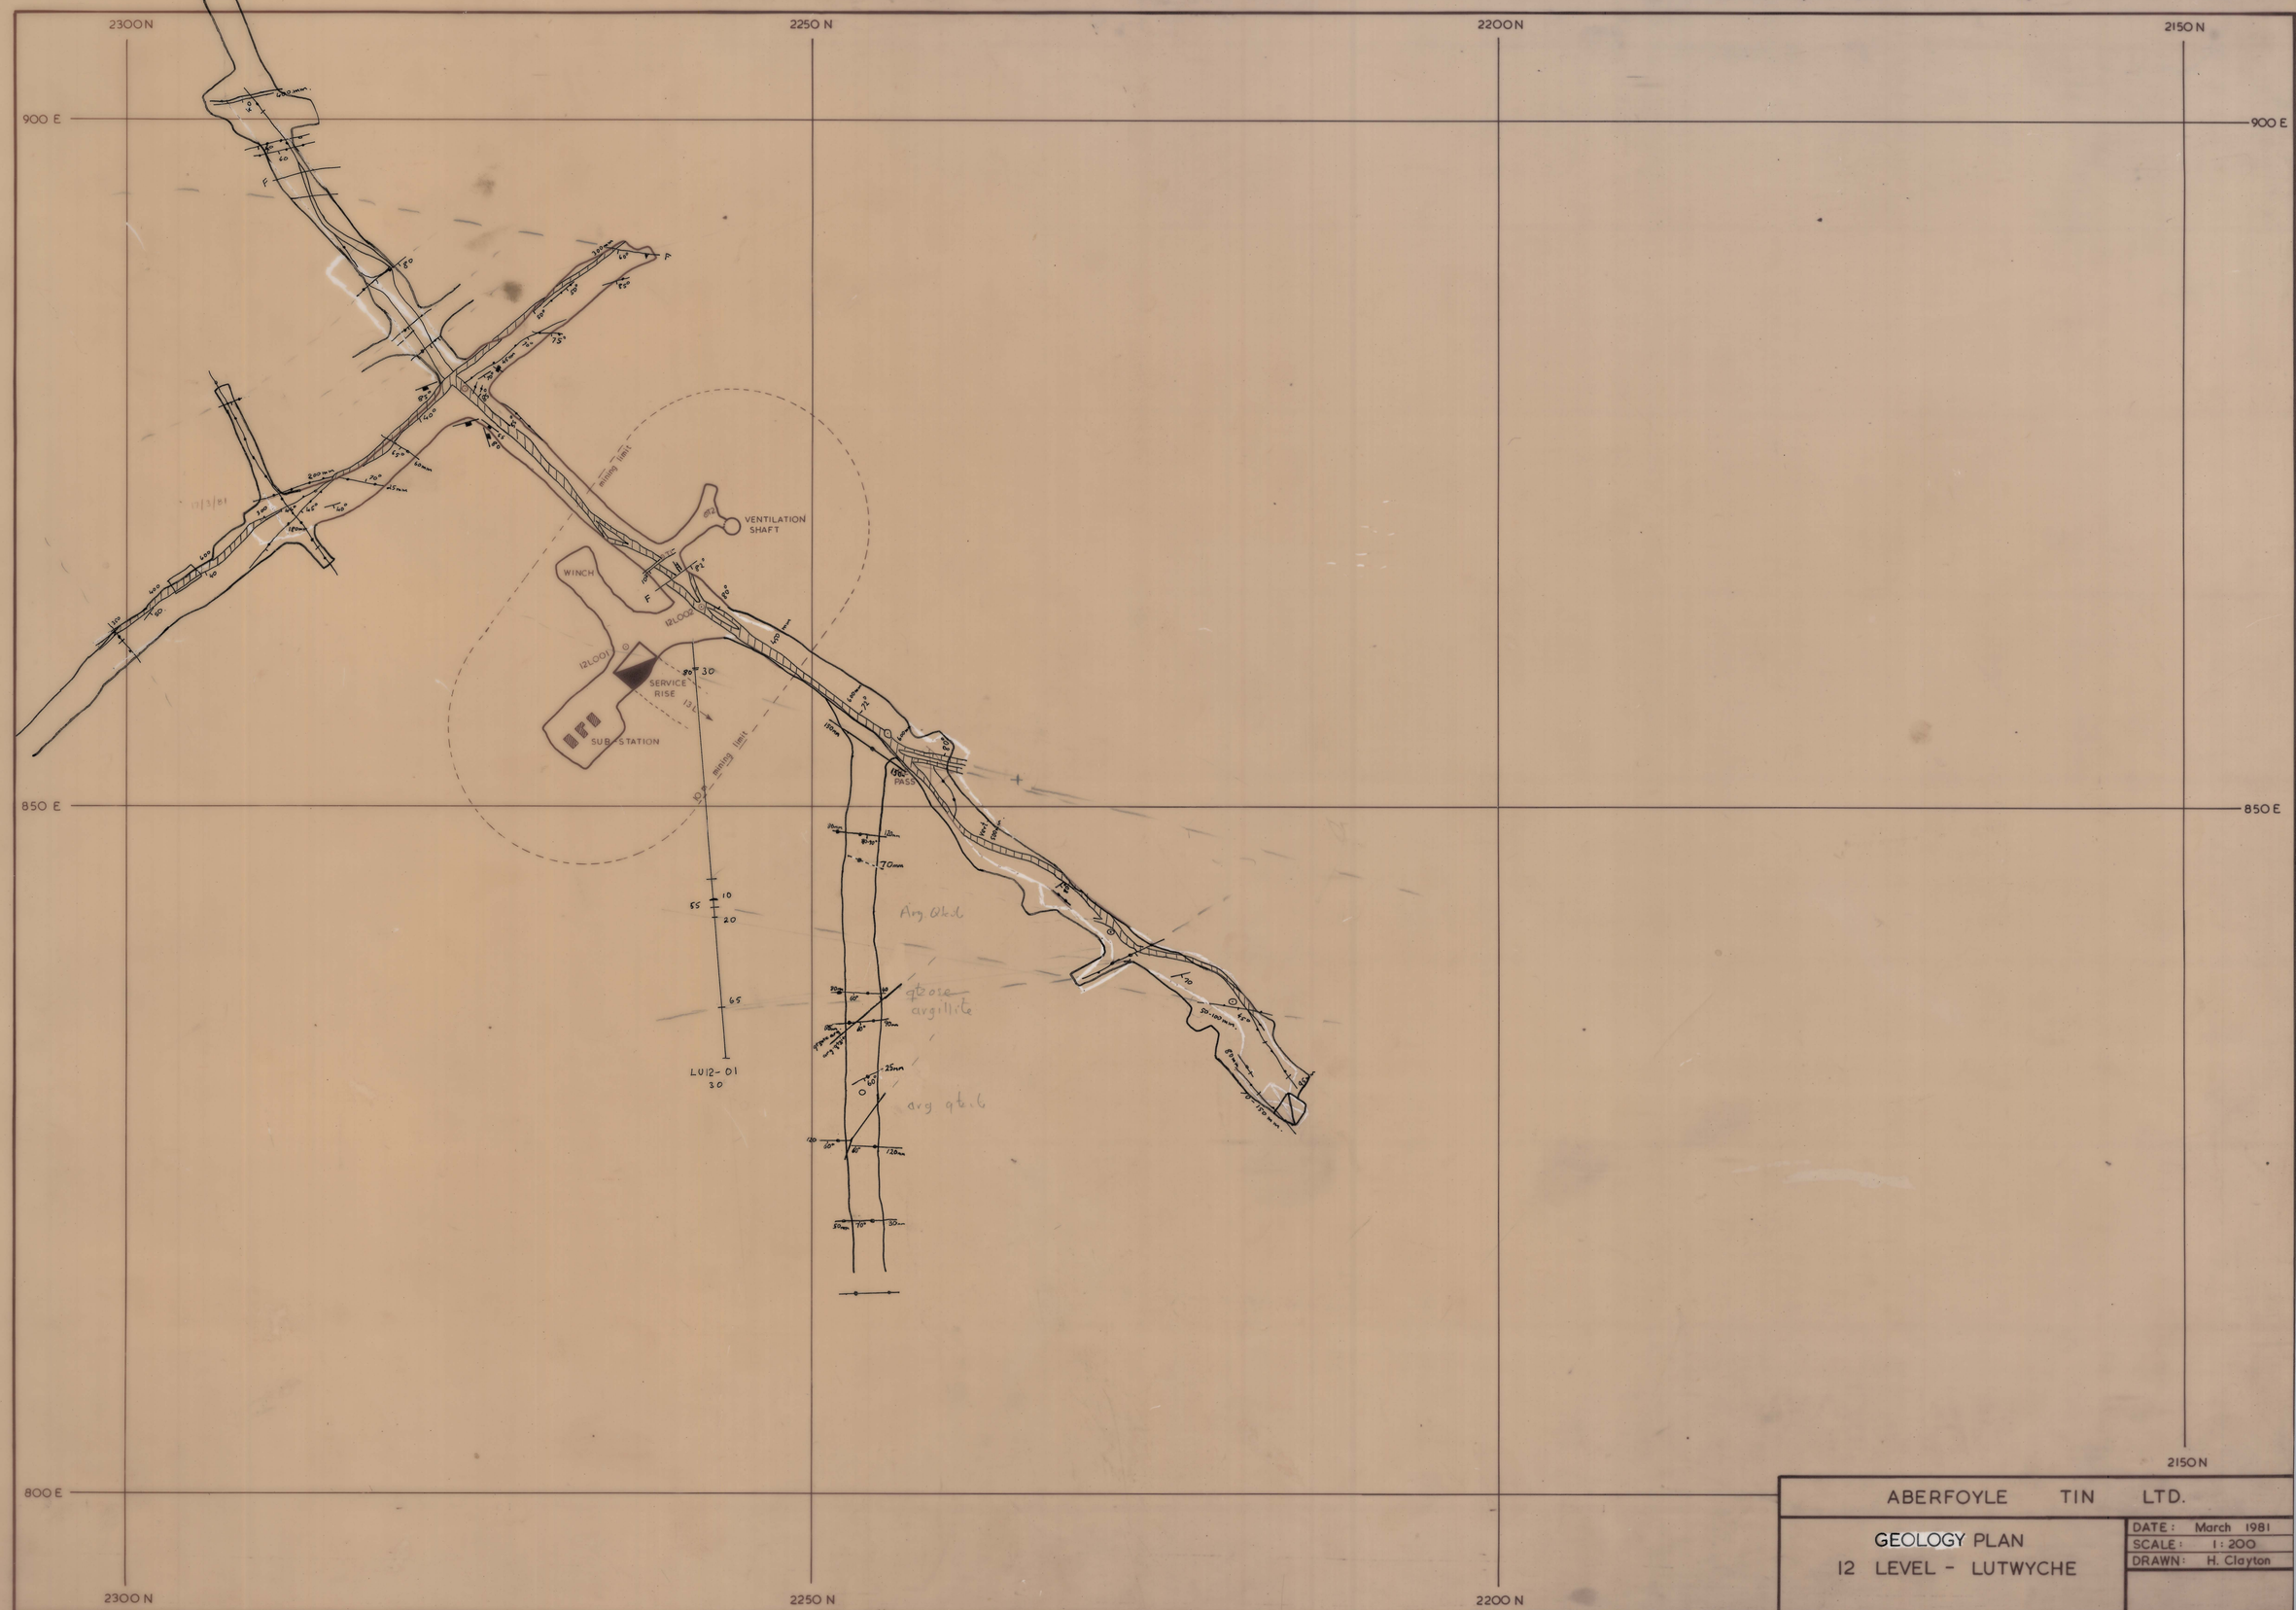

ABERF_488
488