



512

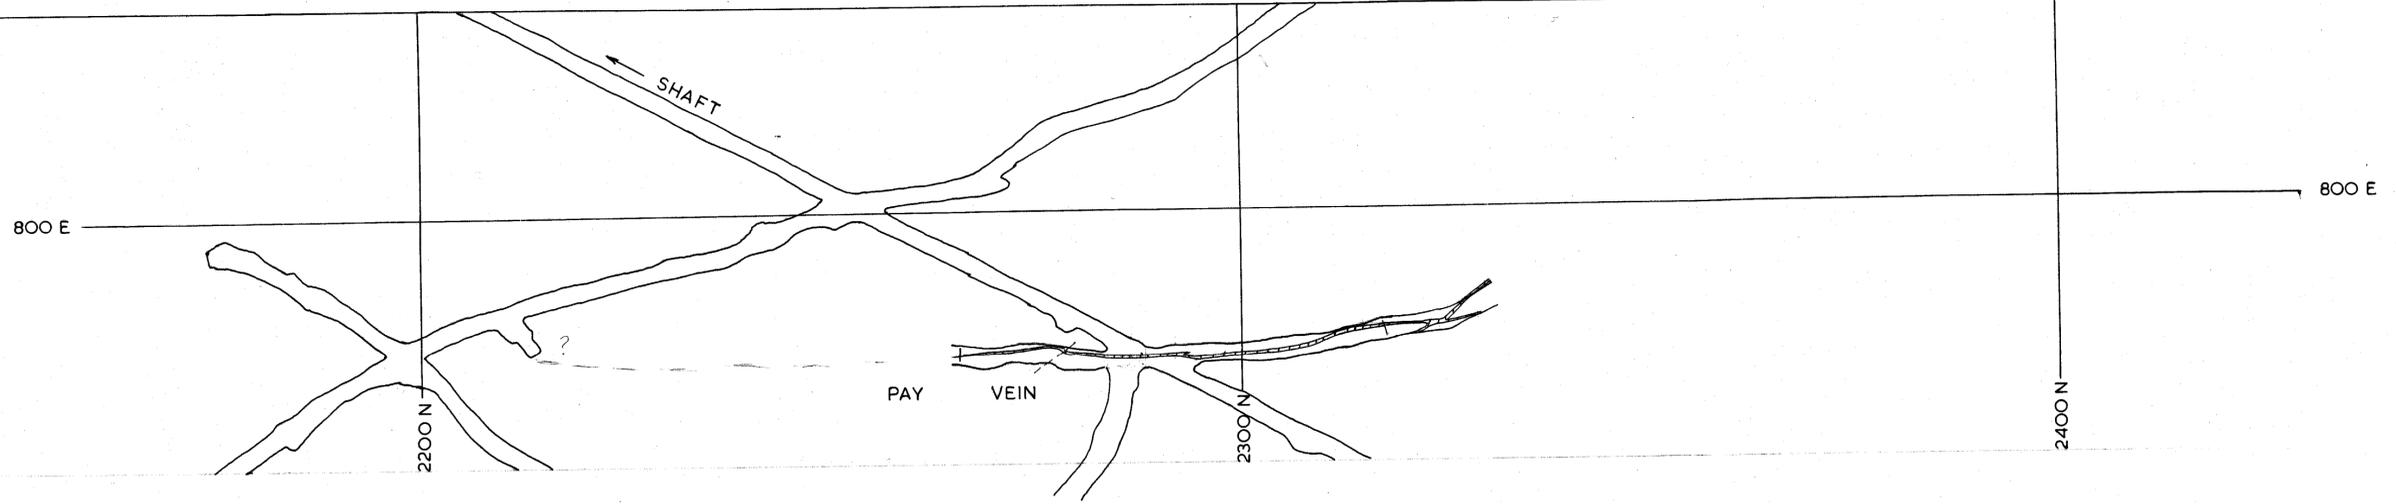

5 cm

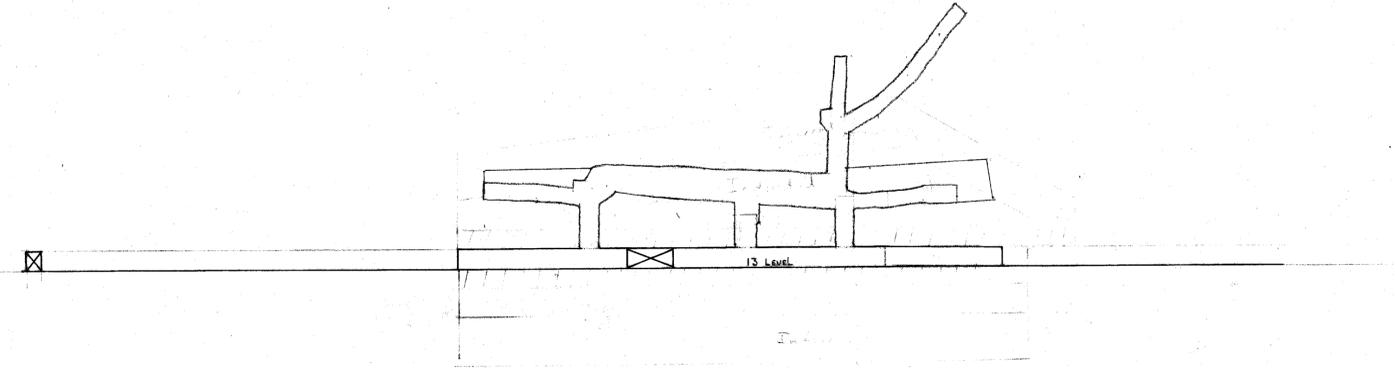

ABERFOYLE TIN LTD.
PAY VEIN
SCALE 1 : 500
PROJECTION — PLANE OF VEIN

J.H.C.