



513

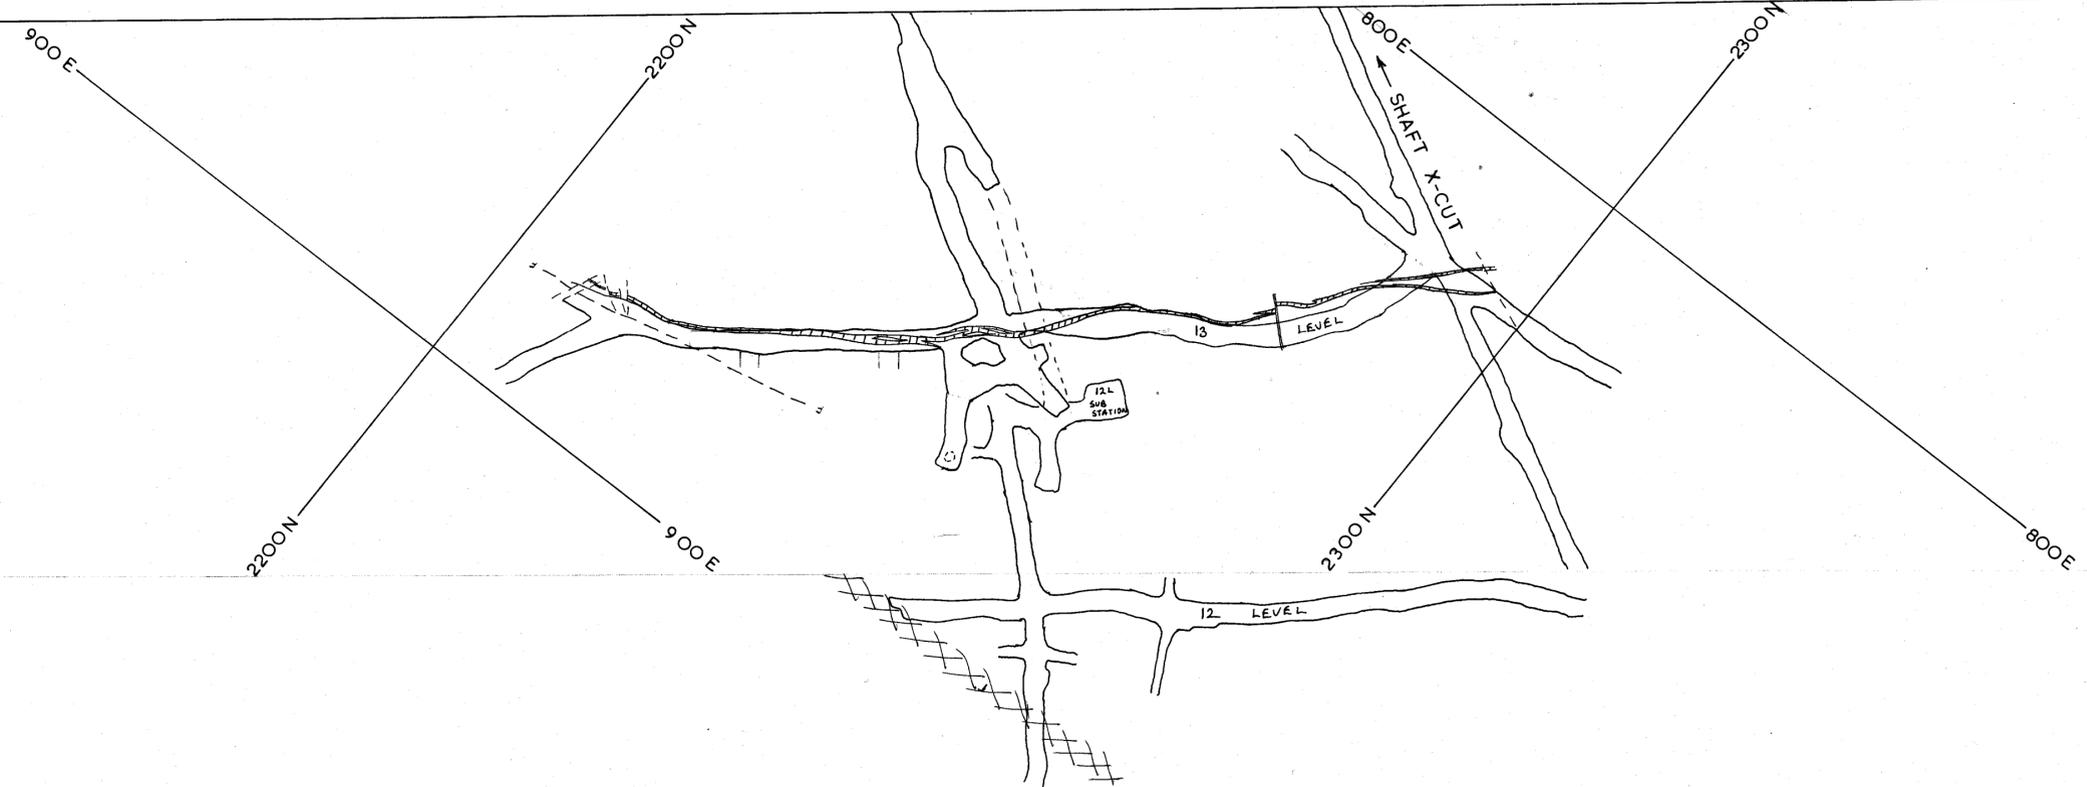

5 cm

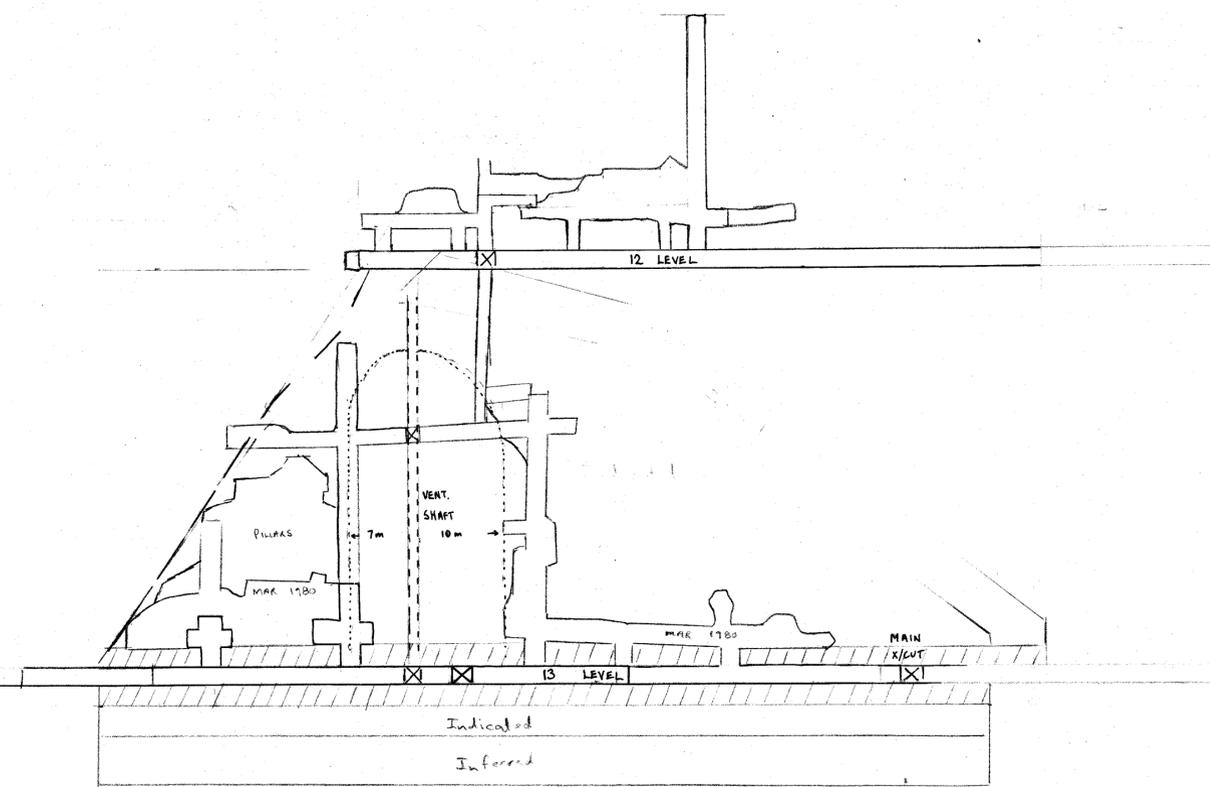

ABERFOYLE TIN LTD.
13 - -
FOOT WALL VEIN
SCALE 1: 500
PROJECTION - PLANE OF VEIN
J.H.C.