



514

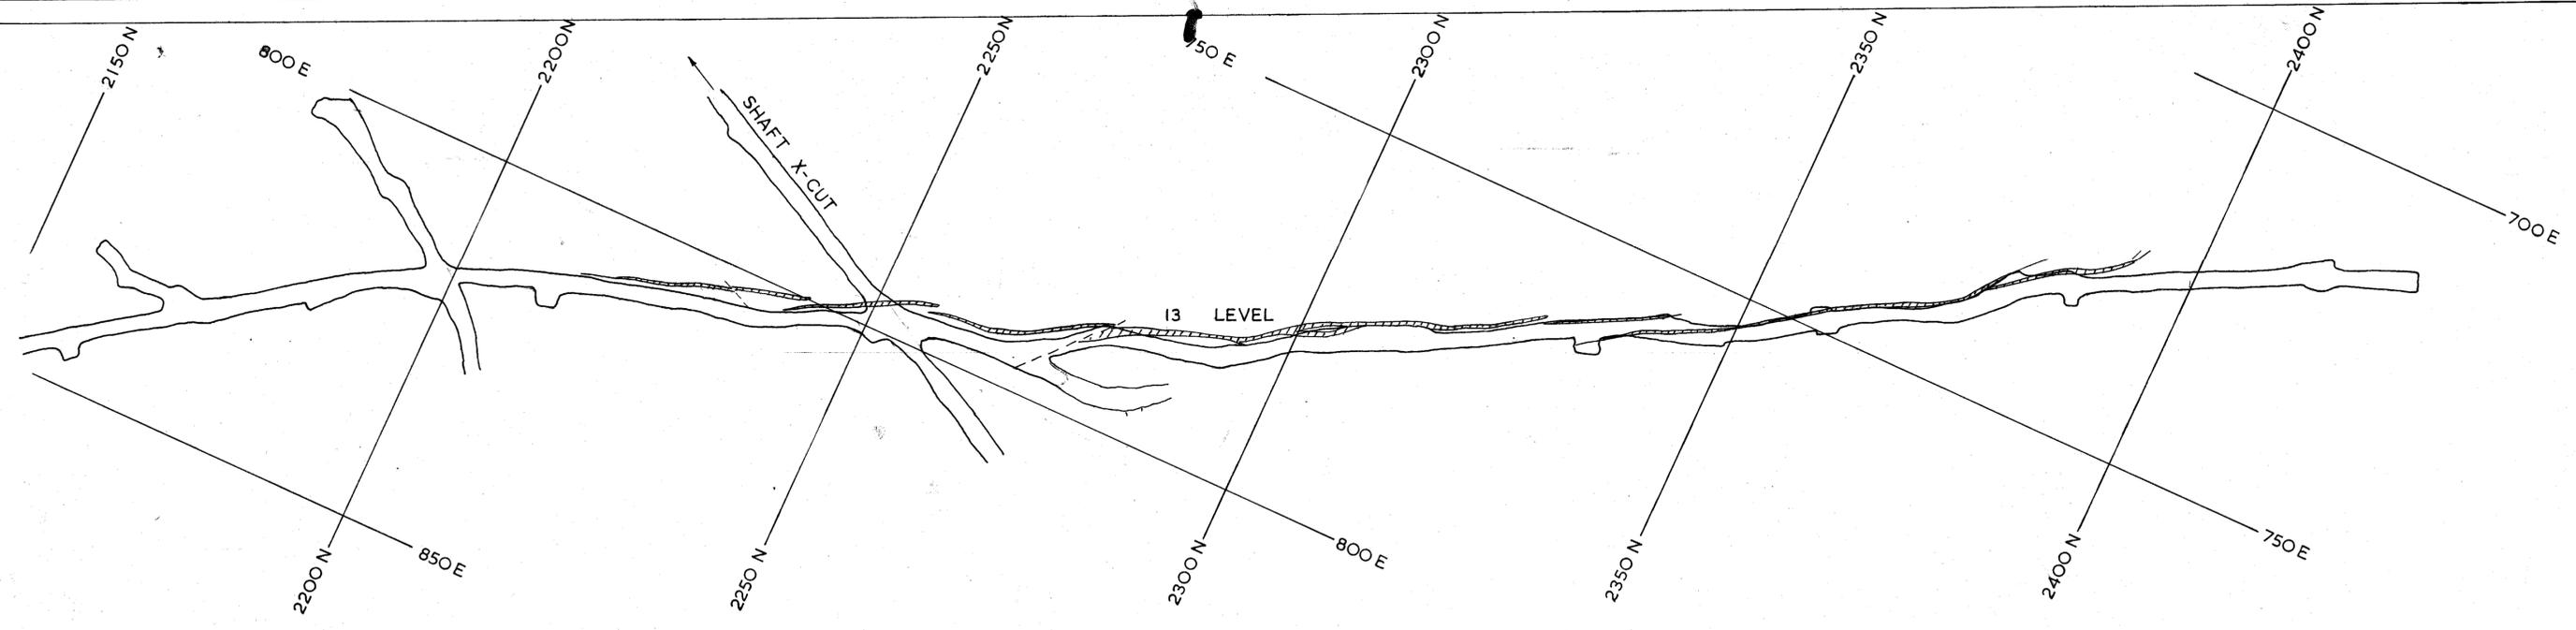

5 cm

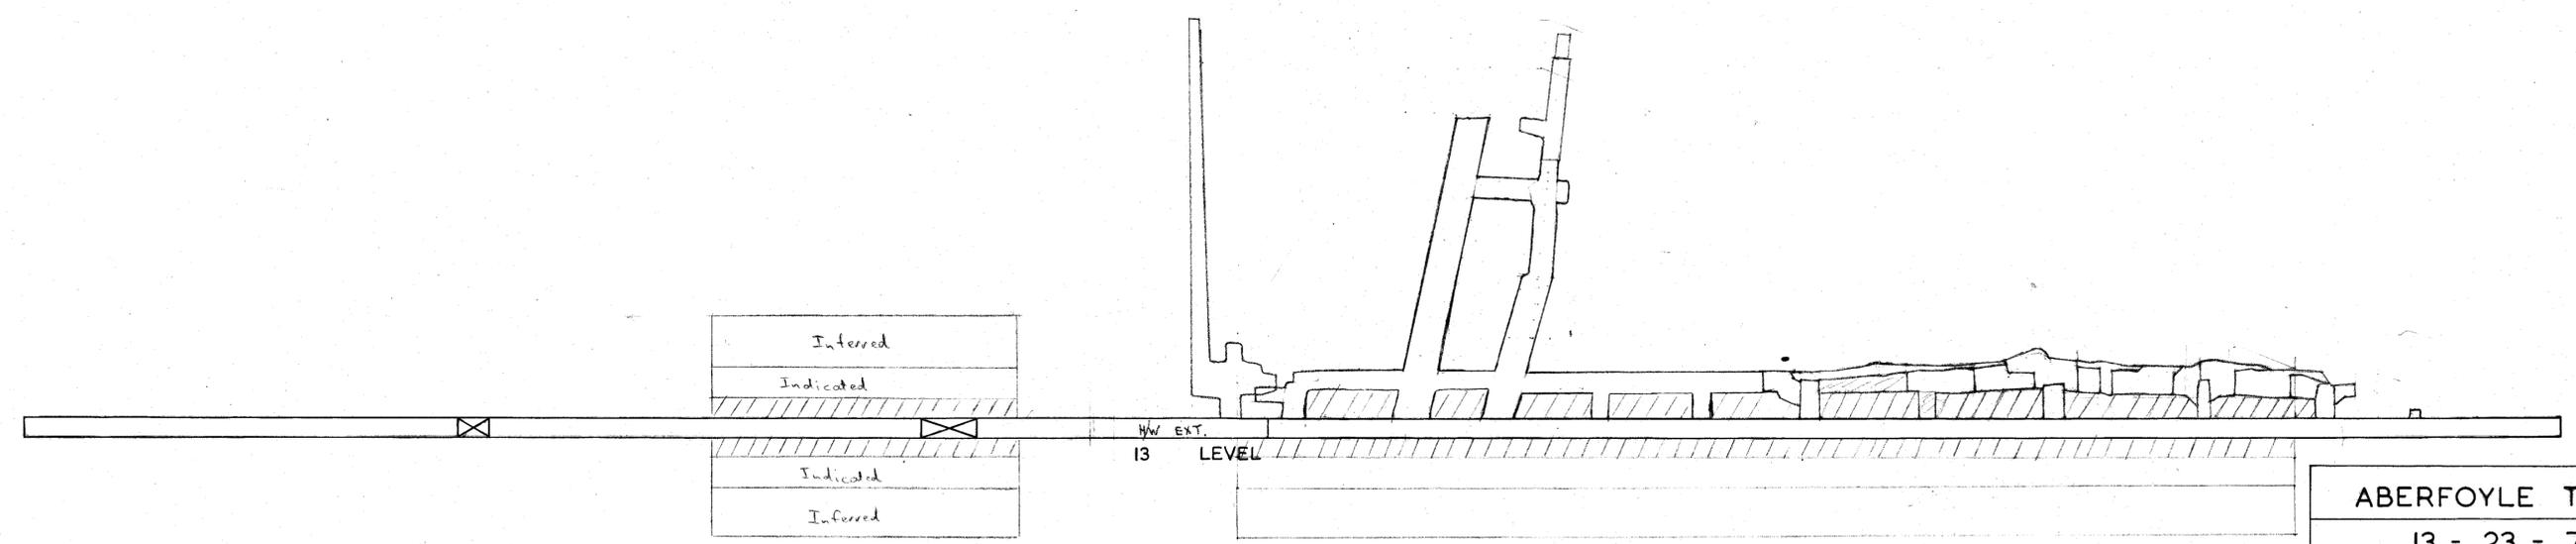

ABERFOYLE TIN N.L.
 13 - 23 - 755
 HANGING WALL VEIN
 SCALE 1:500
 PROJECTION - PLANE OF VEIN
 J.H.C.