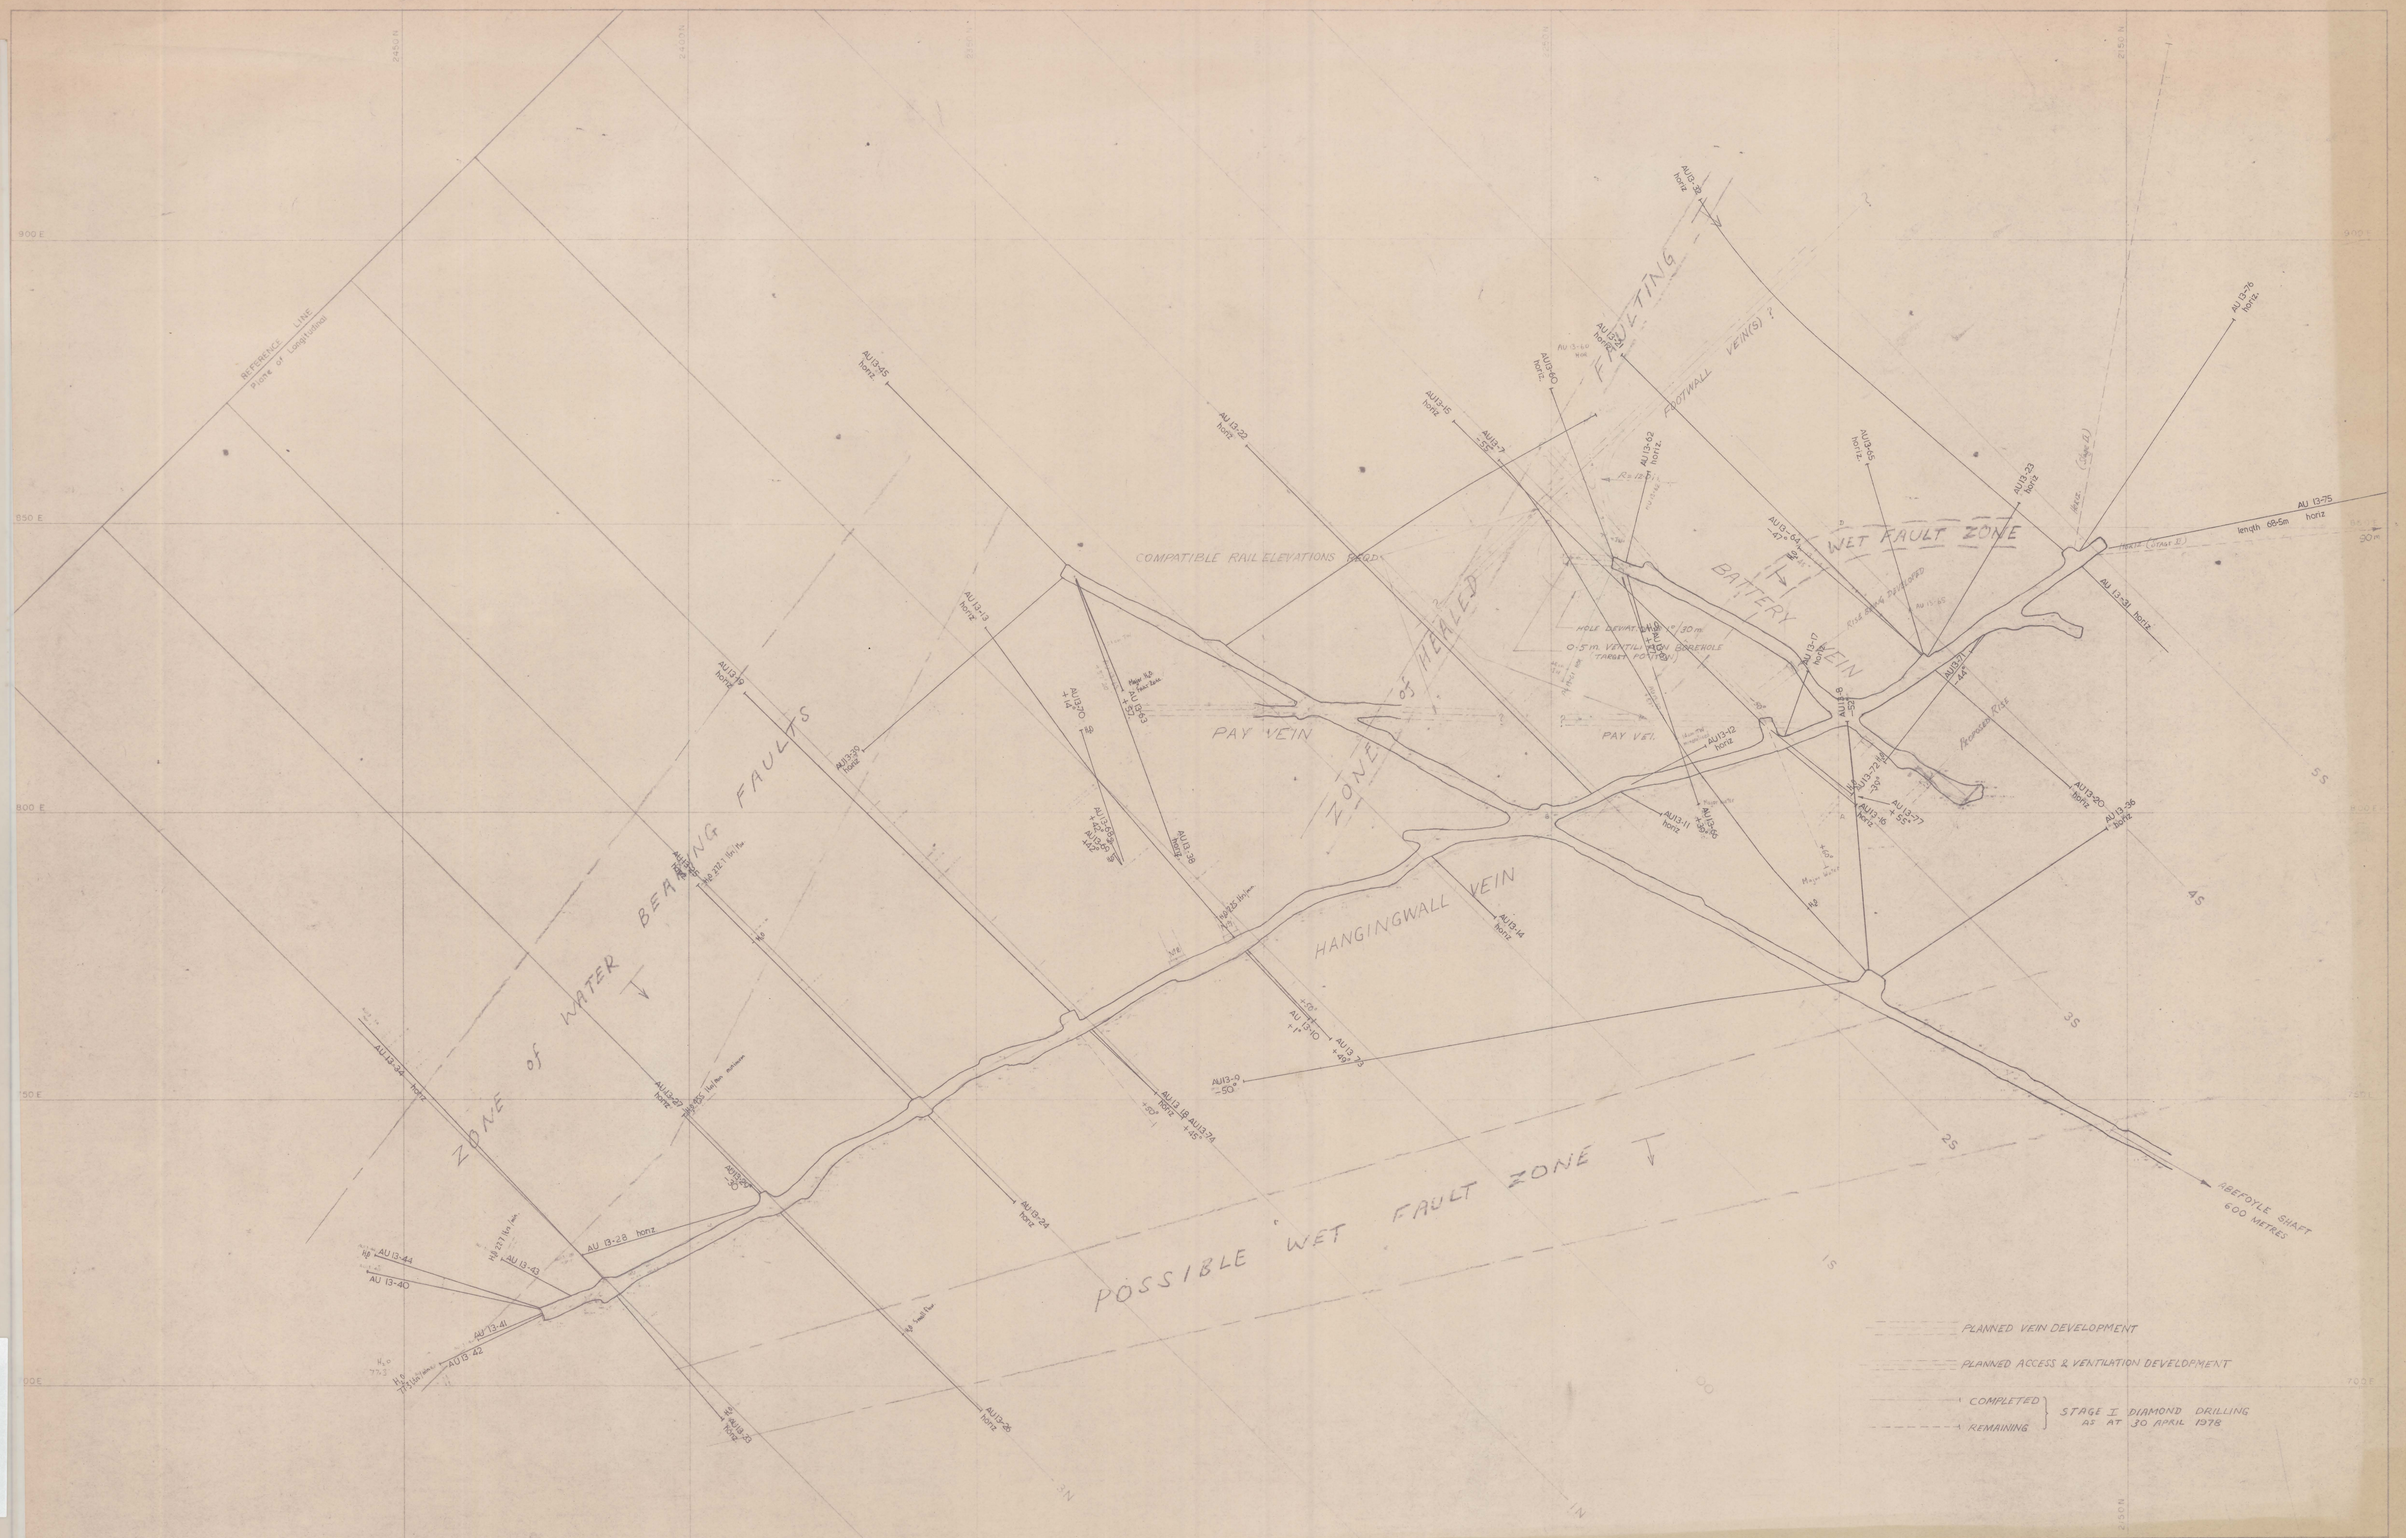523 A
ABERF_
5239