


525

ABERF_525

5 cm

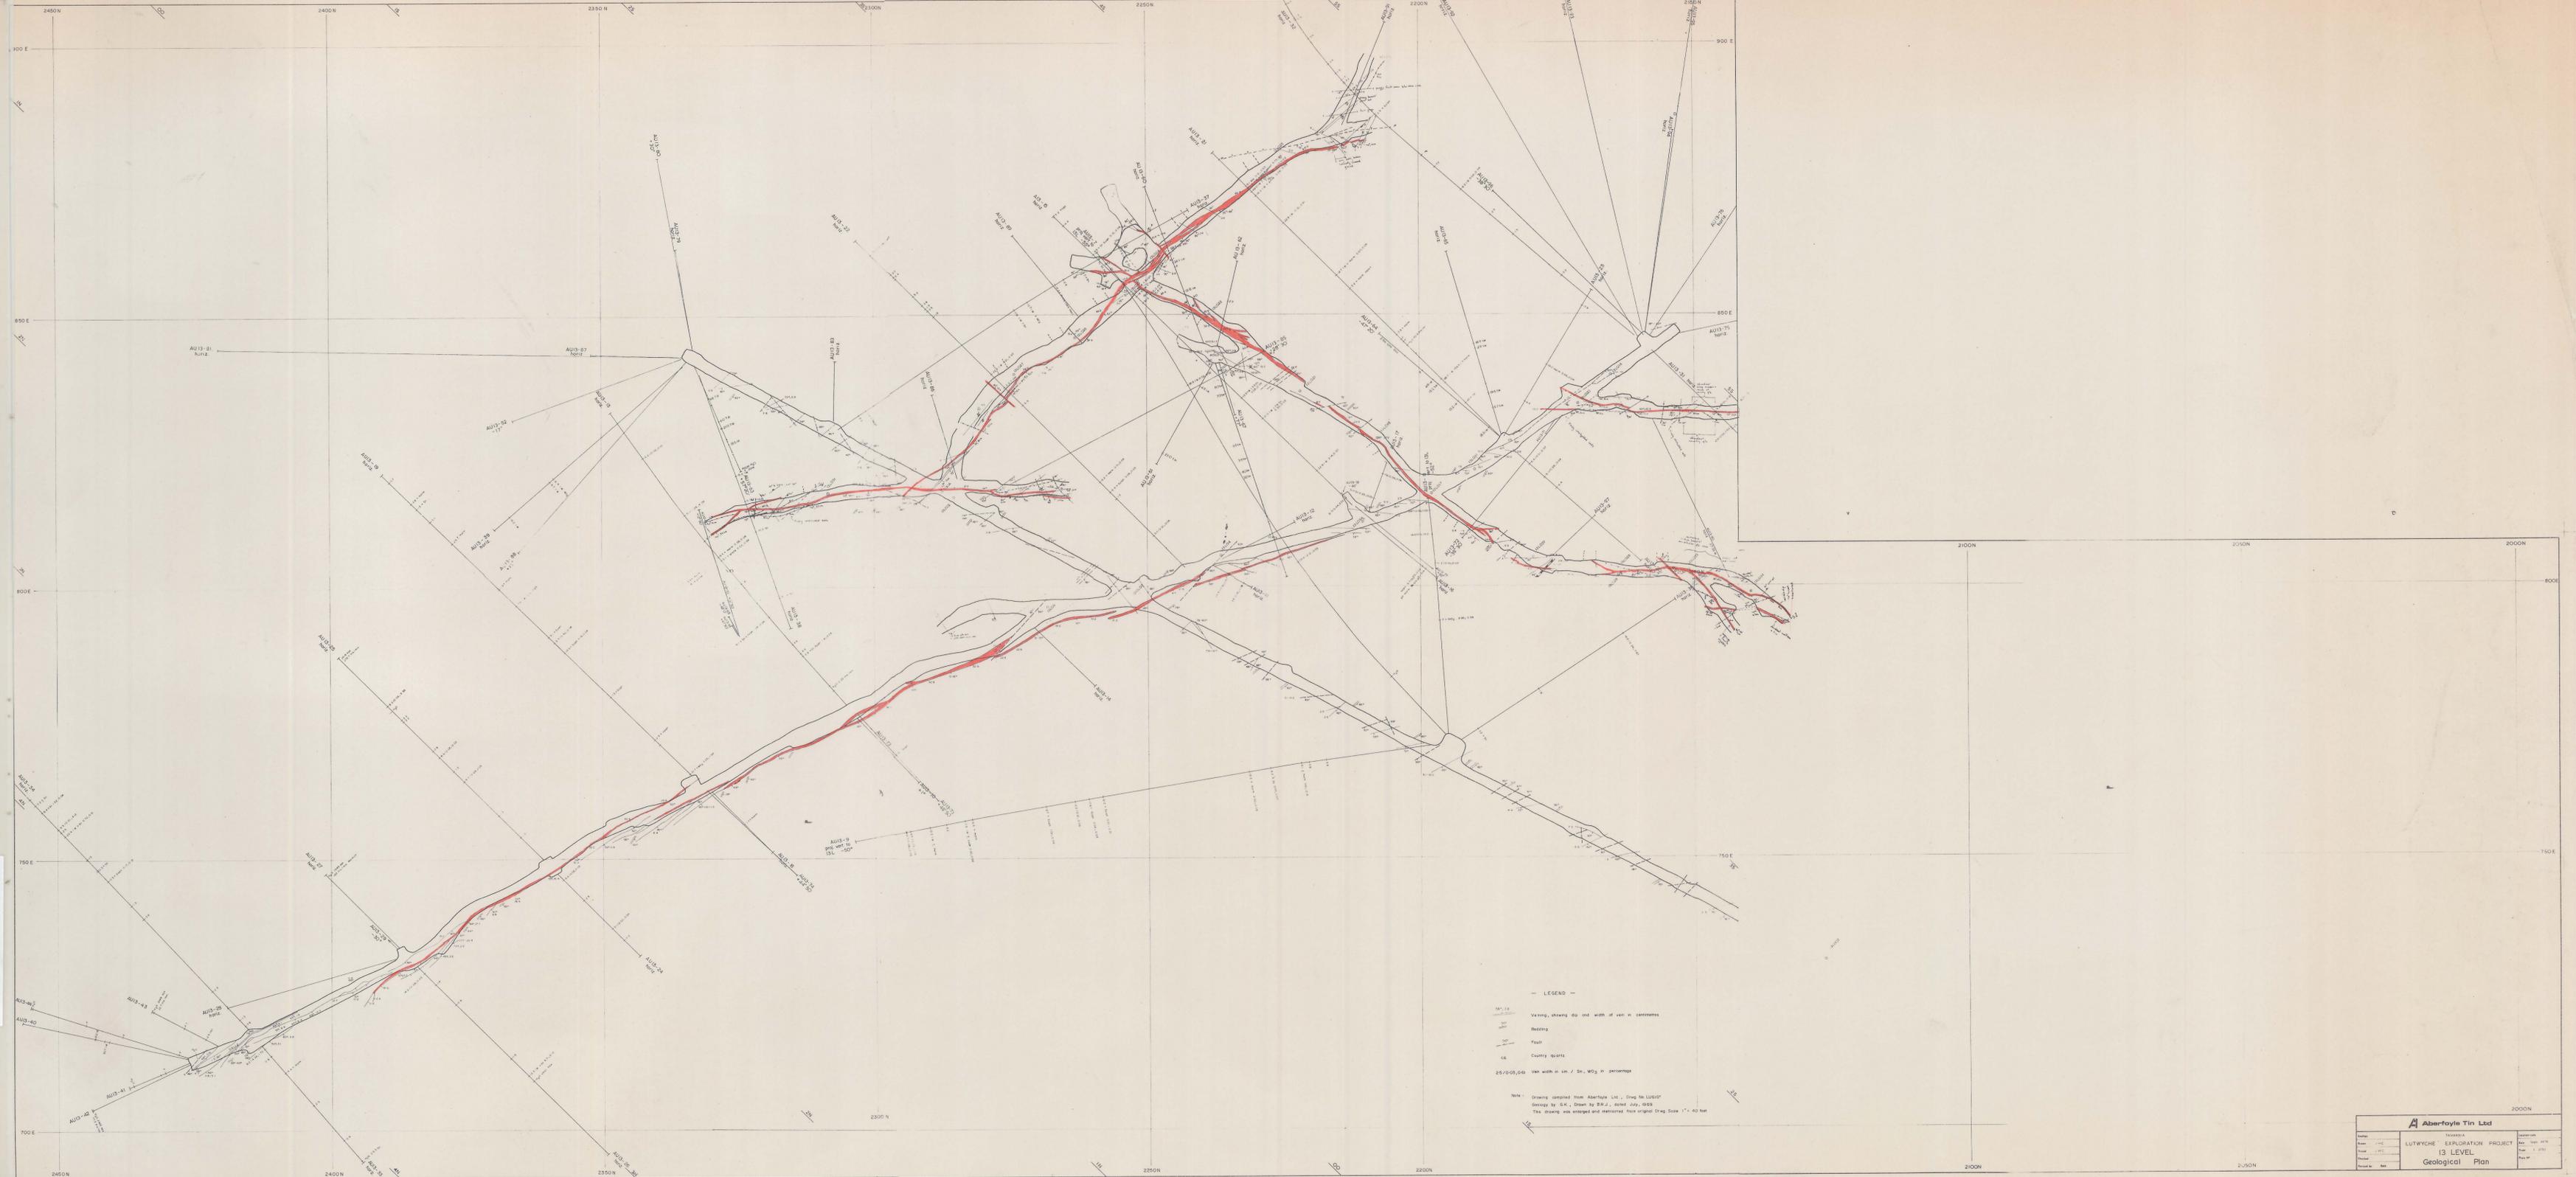

— LEGEND —

100% 1:1
 Veins, showing dip and width of vein in centimetres

100% 1:1
 Faults

100% 1:1
 Country spots

 Vein width in cm / Sn, Wg3 in percentage

NOTE:
 Drawing compiled from Aberfoyle Ltd., Drwg No. LUS507
 Survey by G.K., Drawn by B.M.J., dated July, 1989
 This drawing was enlarged and rechecked from original Drwg Scale 1" = 40 feet

Aberfoyle Tin Ltd		
Project	LUTWICHE EXPLORATION PROJECT	Scale
Sheet	13 LEVEL	Date
Drawn by	Geological Plan	Drawn by