


552

5 cm

ABERF-
552A

1540N

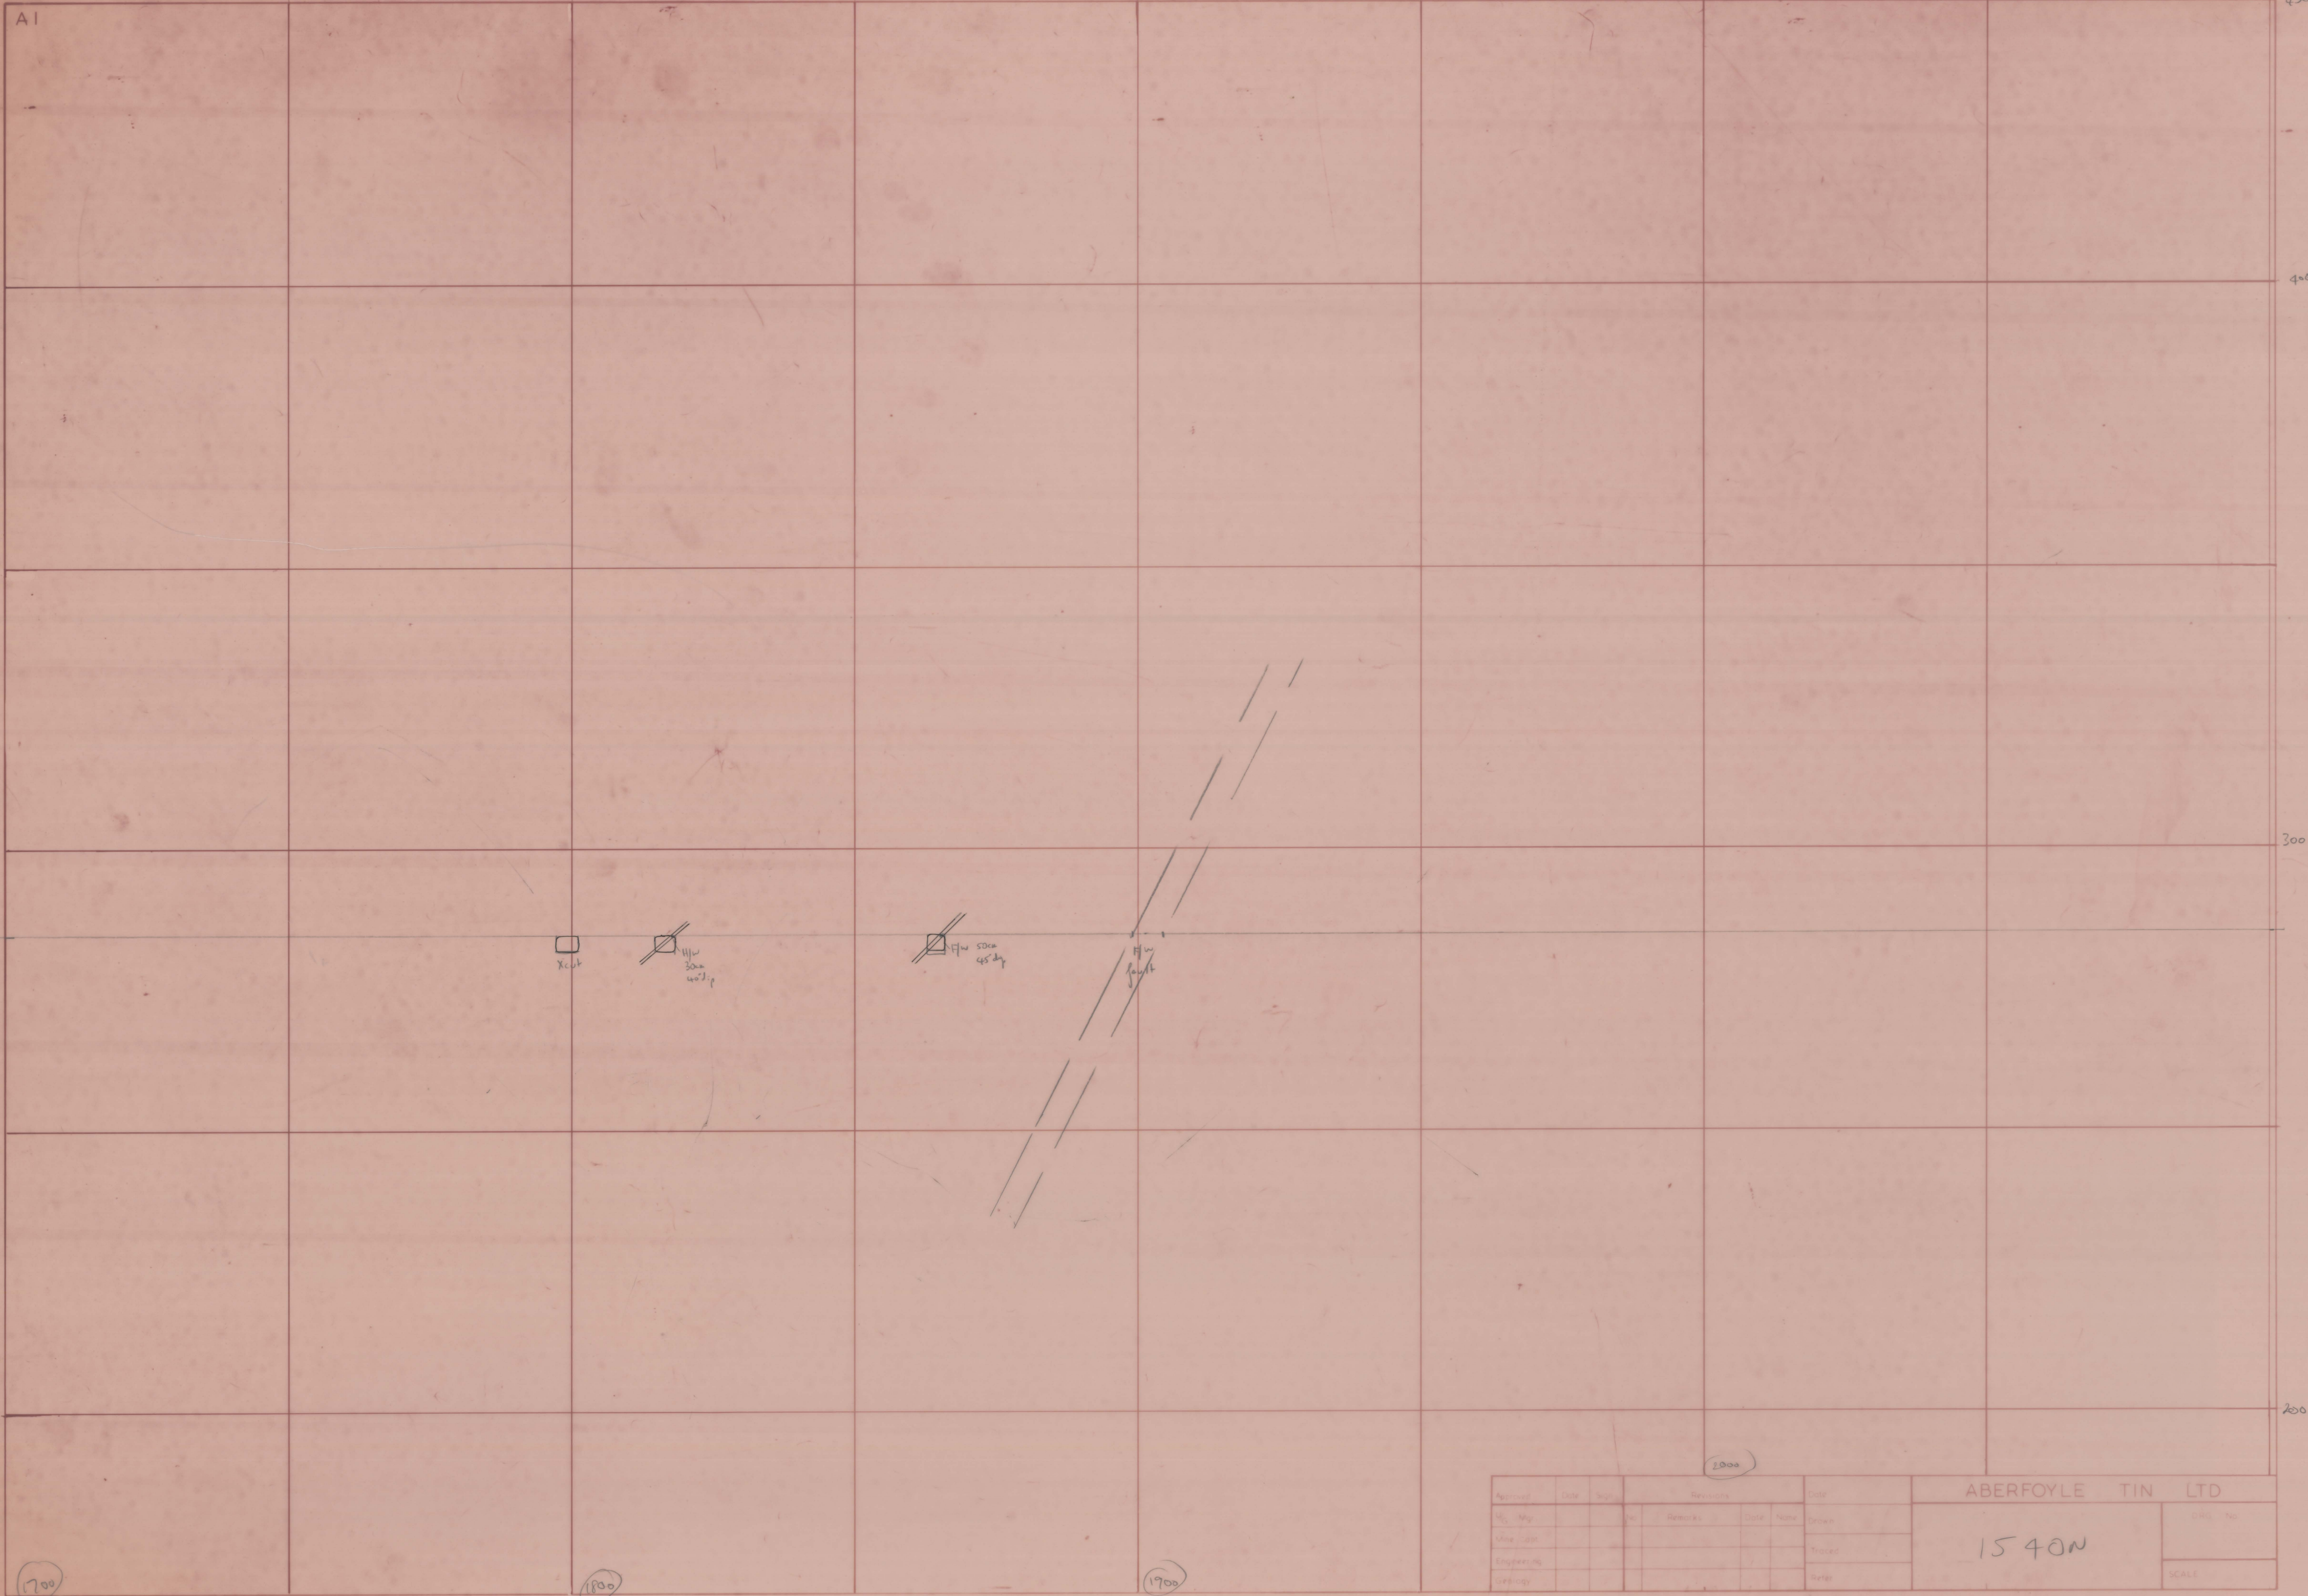

Approved	Date	By	Revisions	Date	By	Drawn	ABERFOYLE TIN LTD	
Rev	By	No	Remarks	Date	Name	Drawn	1540N	
Engineer	By					Checked		
Surveyor	By					Settled	SCALE	