


ABERF-S80

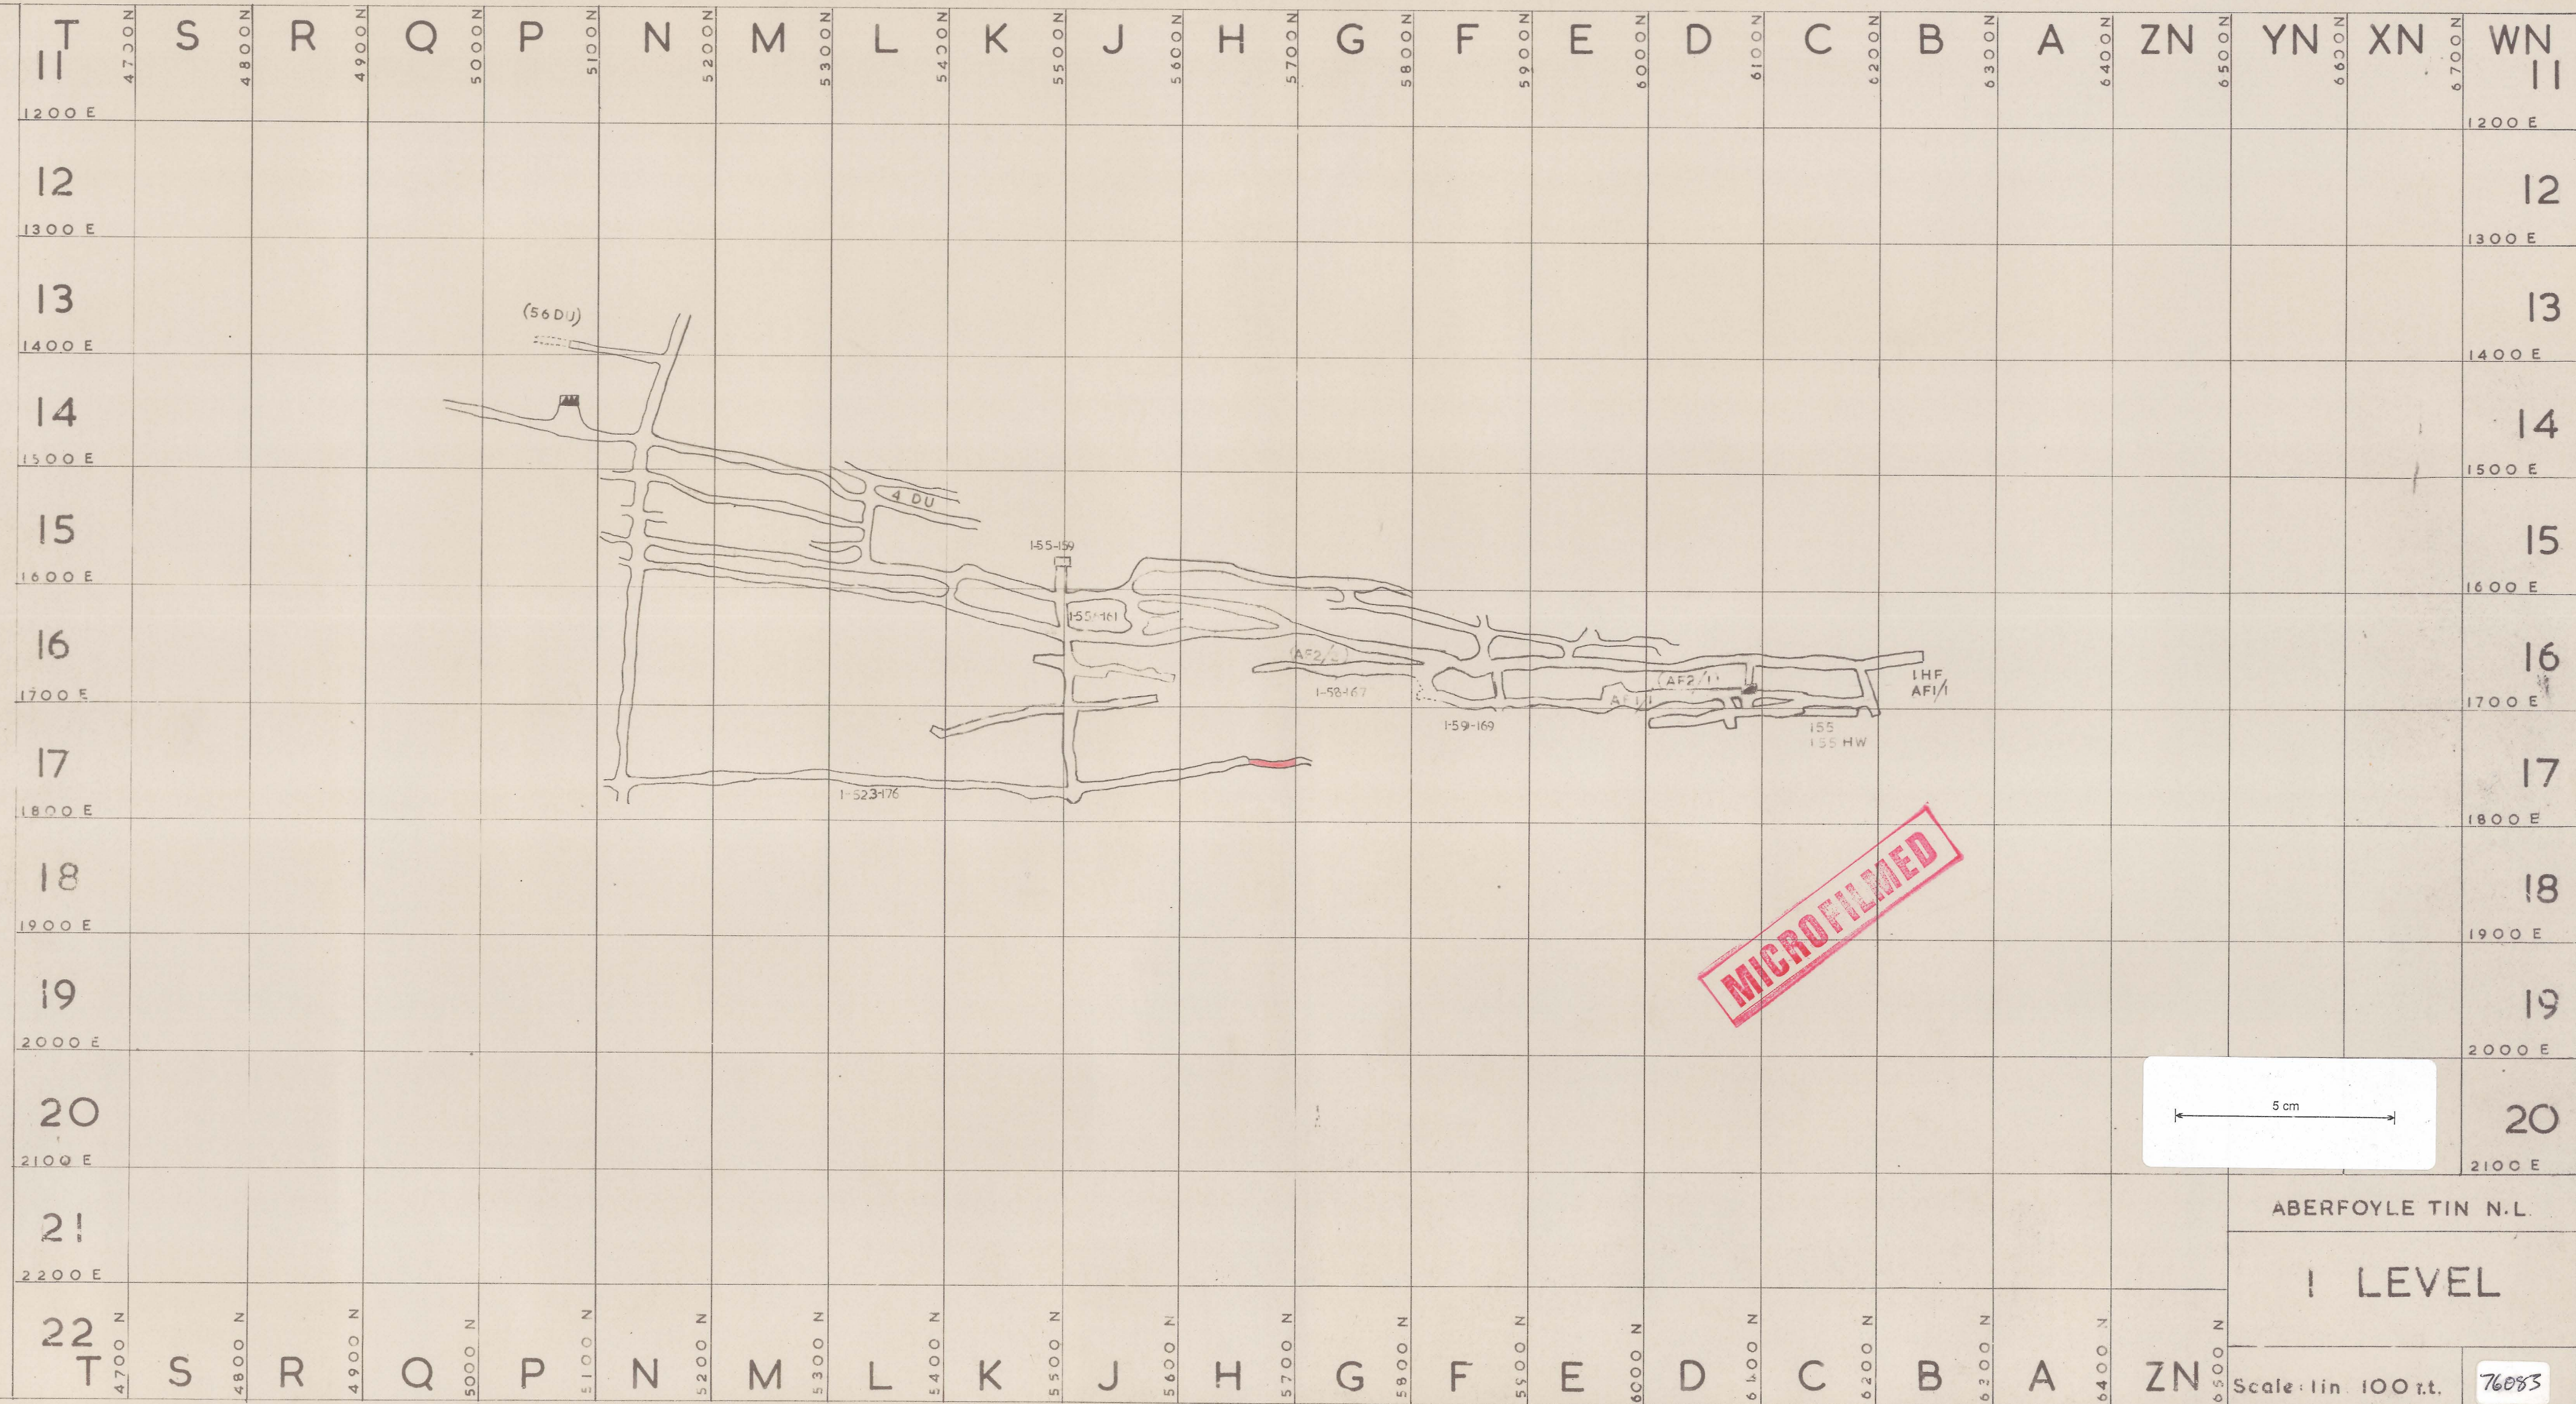

MICROFILMED

5 cm

ABERFOYLE TIN N.L.

I LEVEL

Scale: 1 in. = 100 ft.

76083