



ABERF - 581

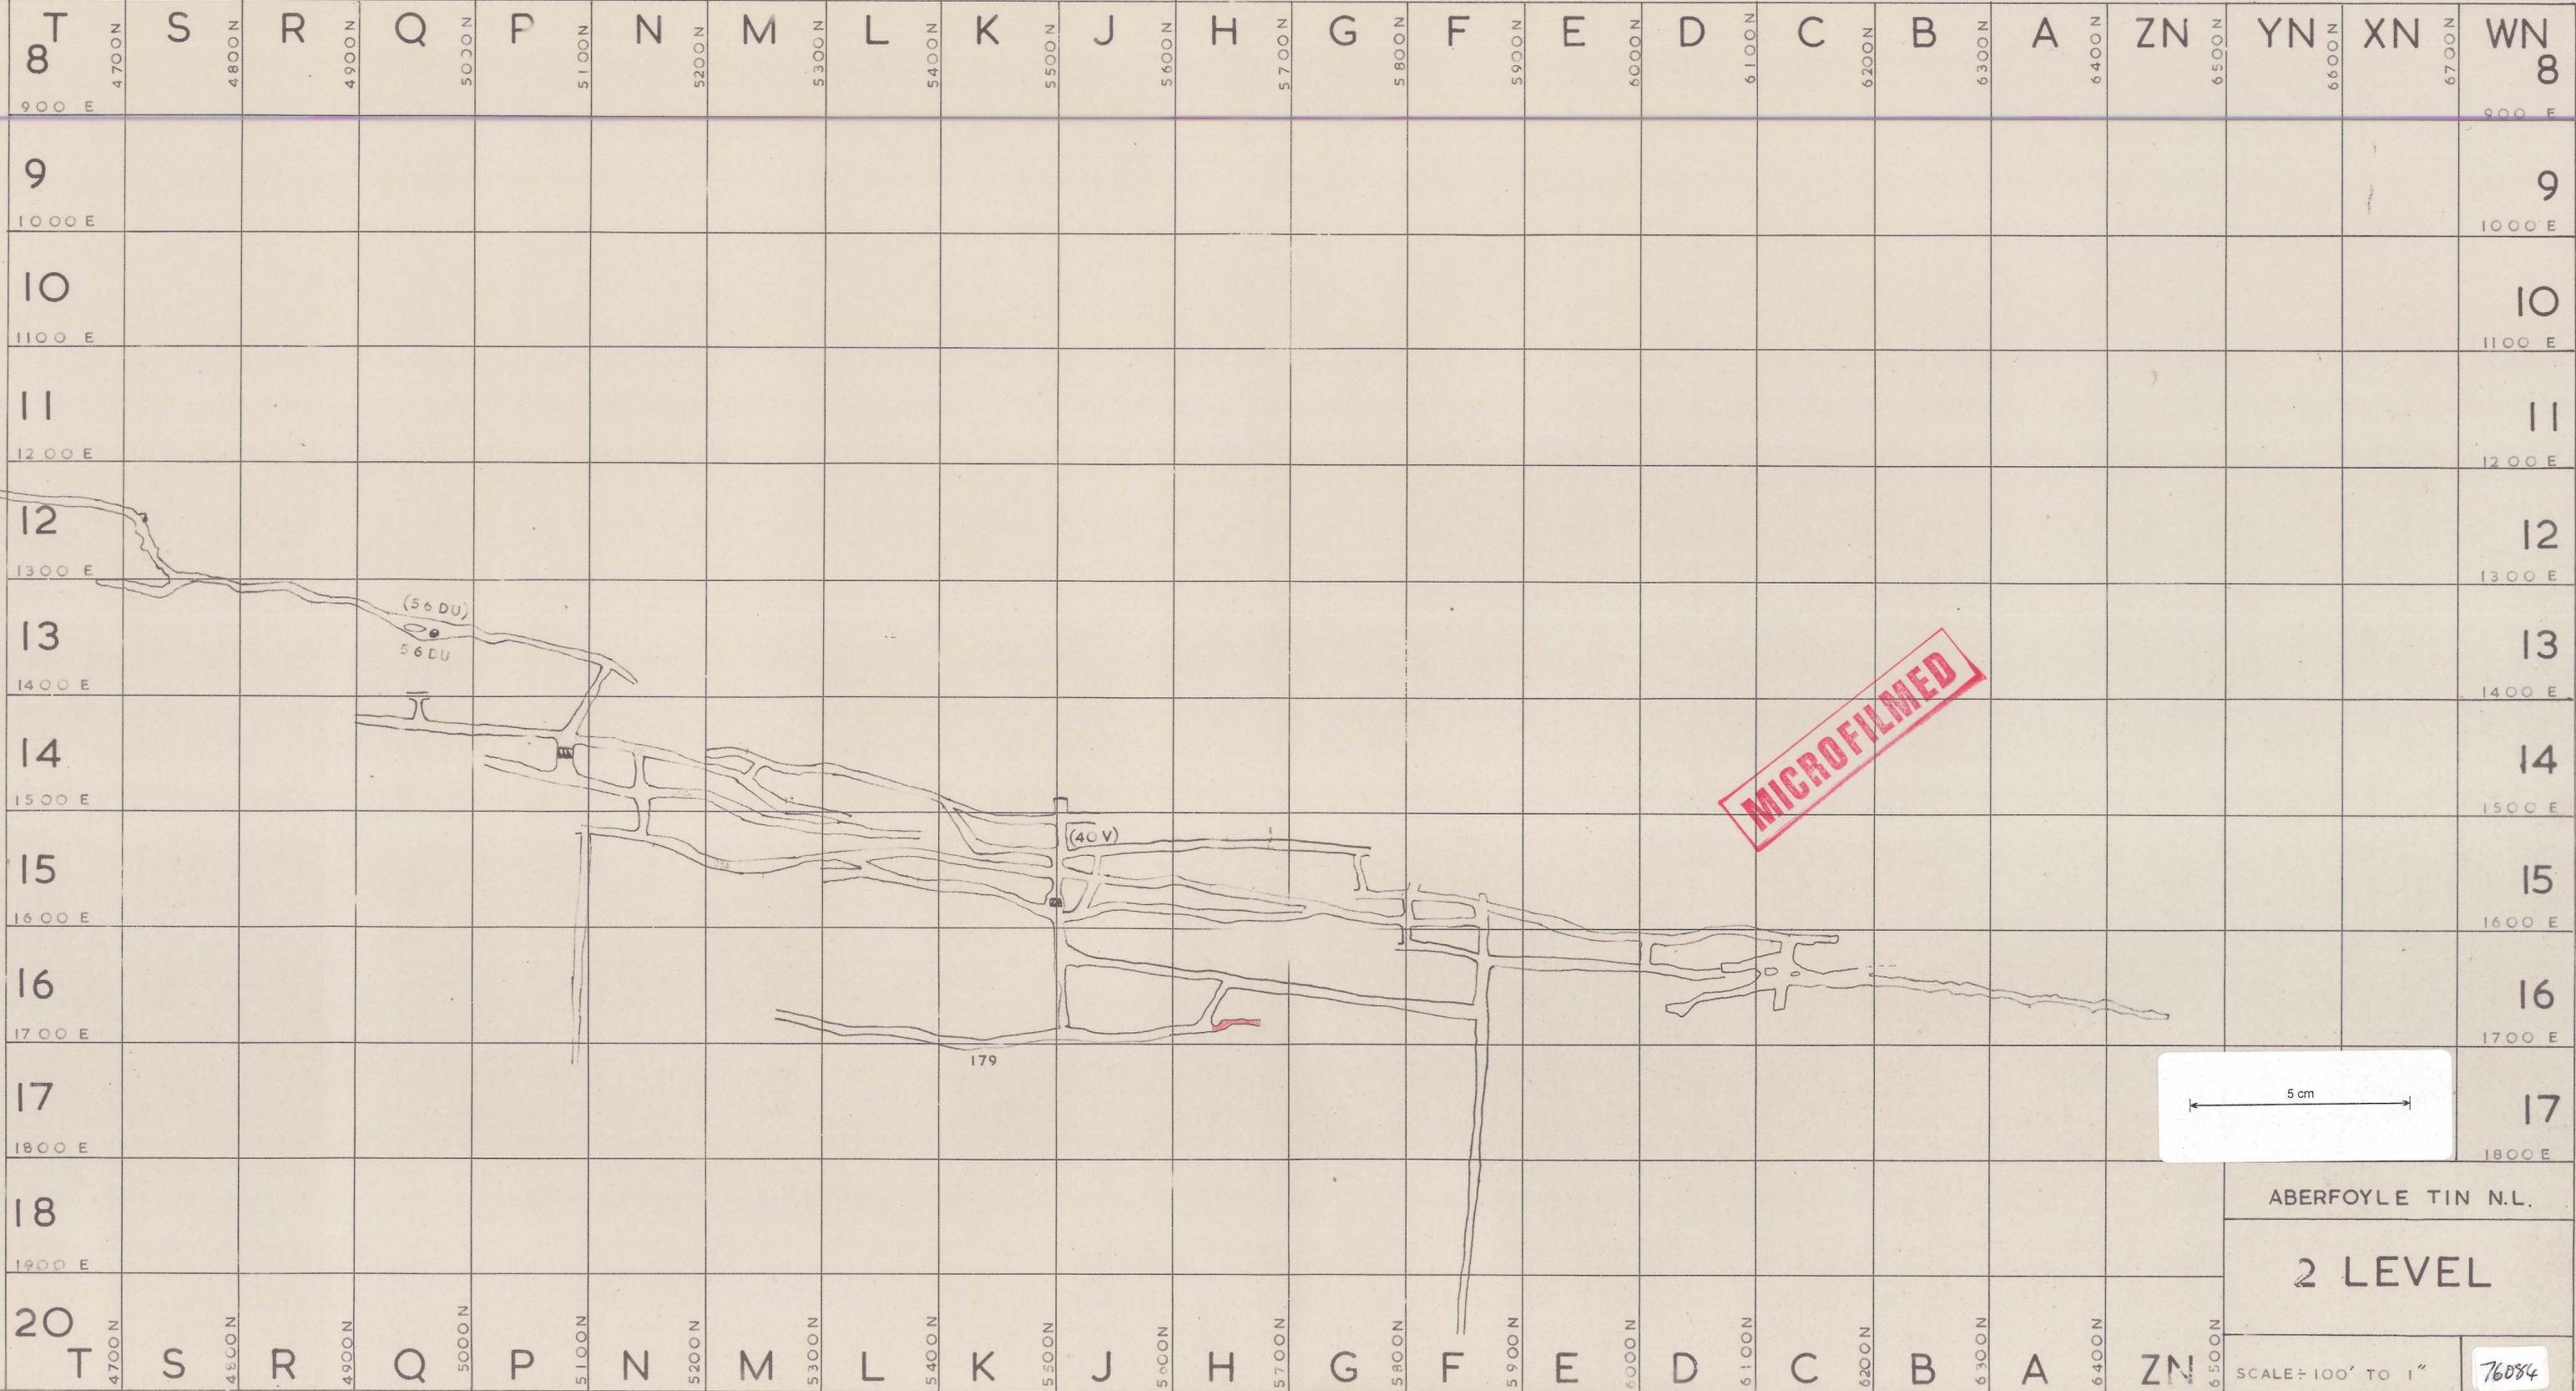

MICROFILMED

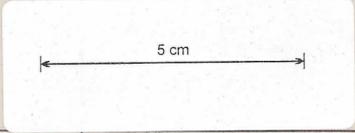

ABERFOYLE TIN N.L.

2 LEVEL

SCALE = 100' TO 1"

76084