



ABERF - 583

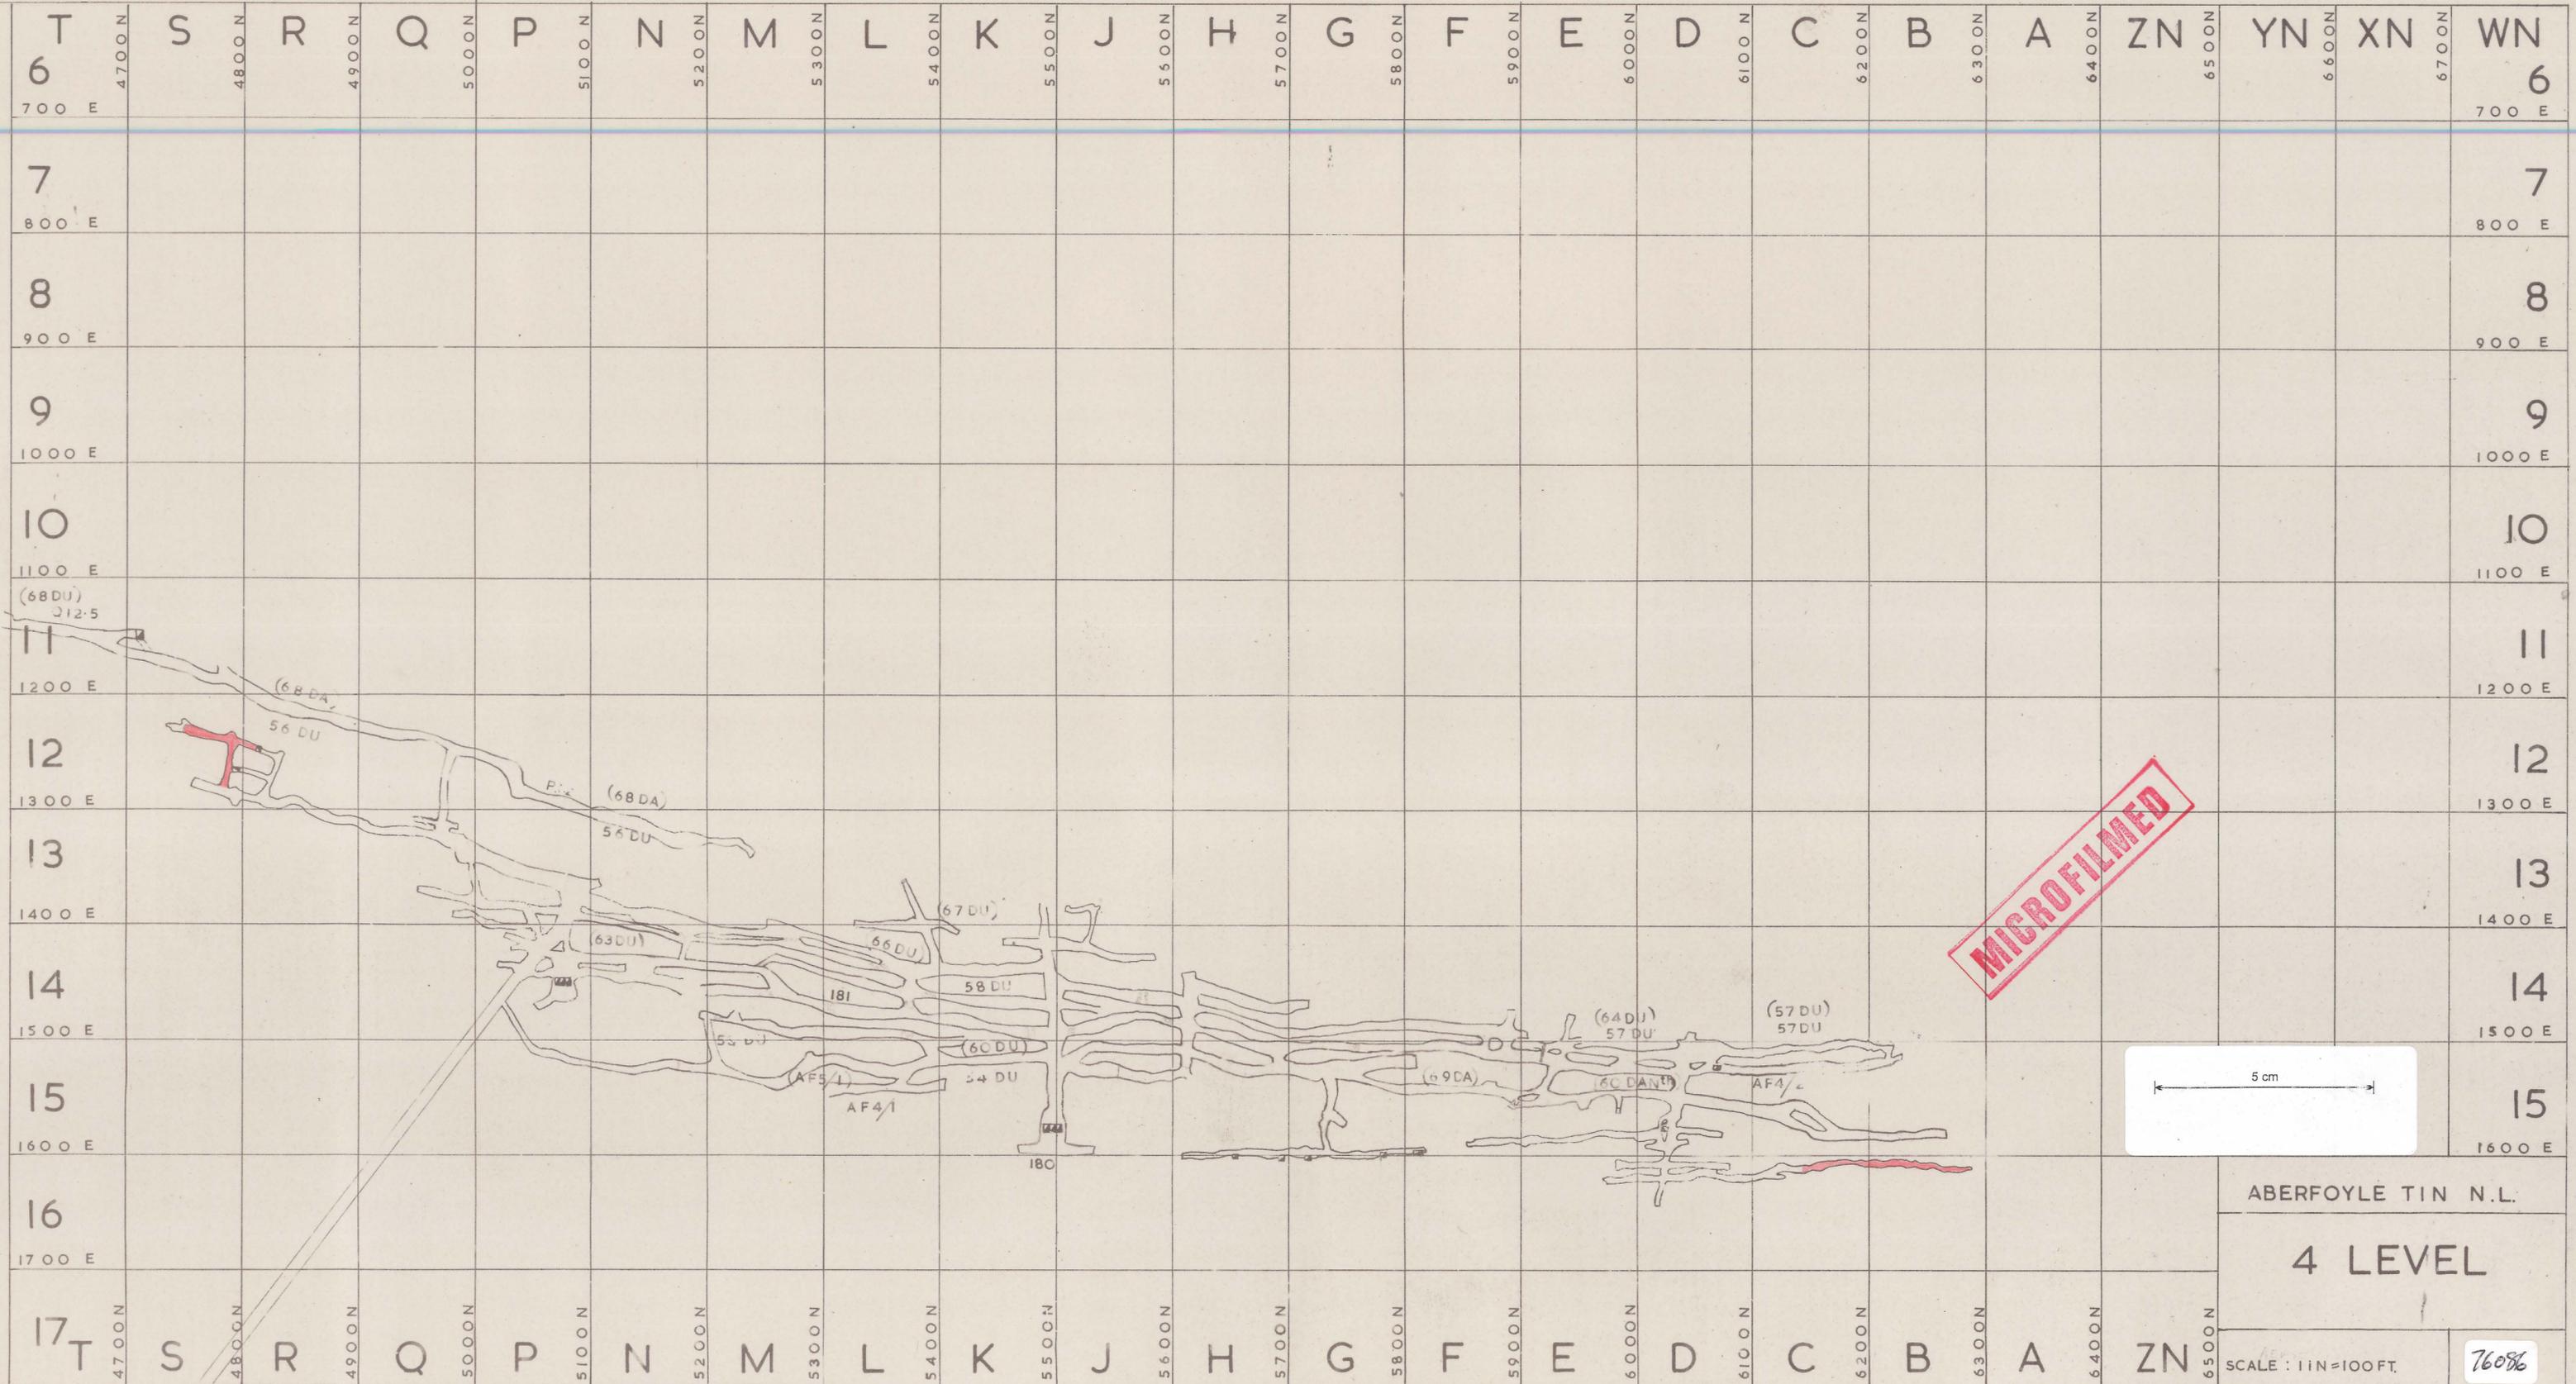

MICROFILMED

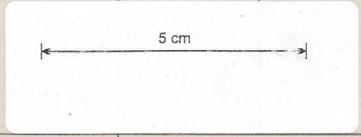

ABERFOYLE TIN N.L.

4 LEVEL

SCALE: 1 IN = 100 FT.

76086