



ABERF - 585

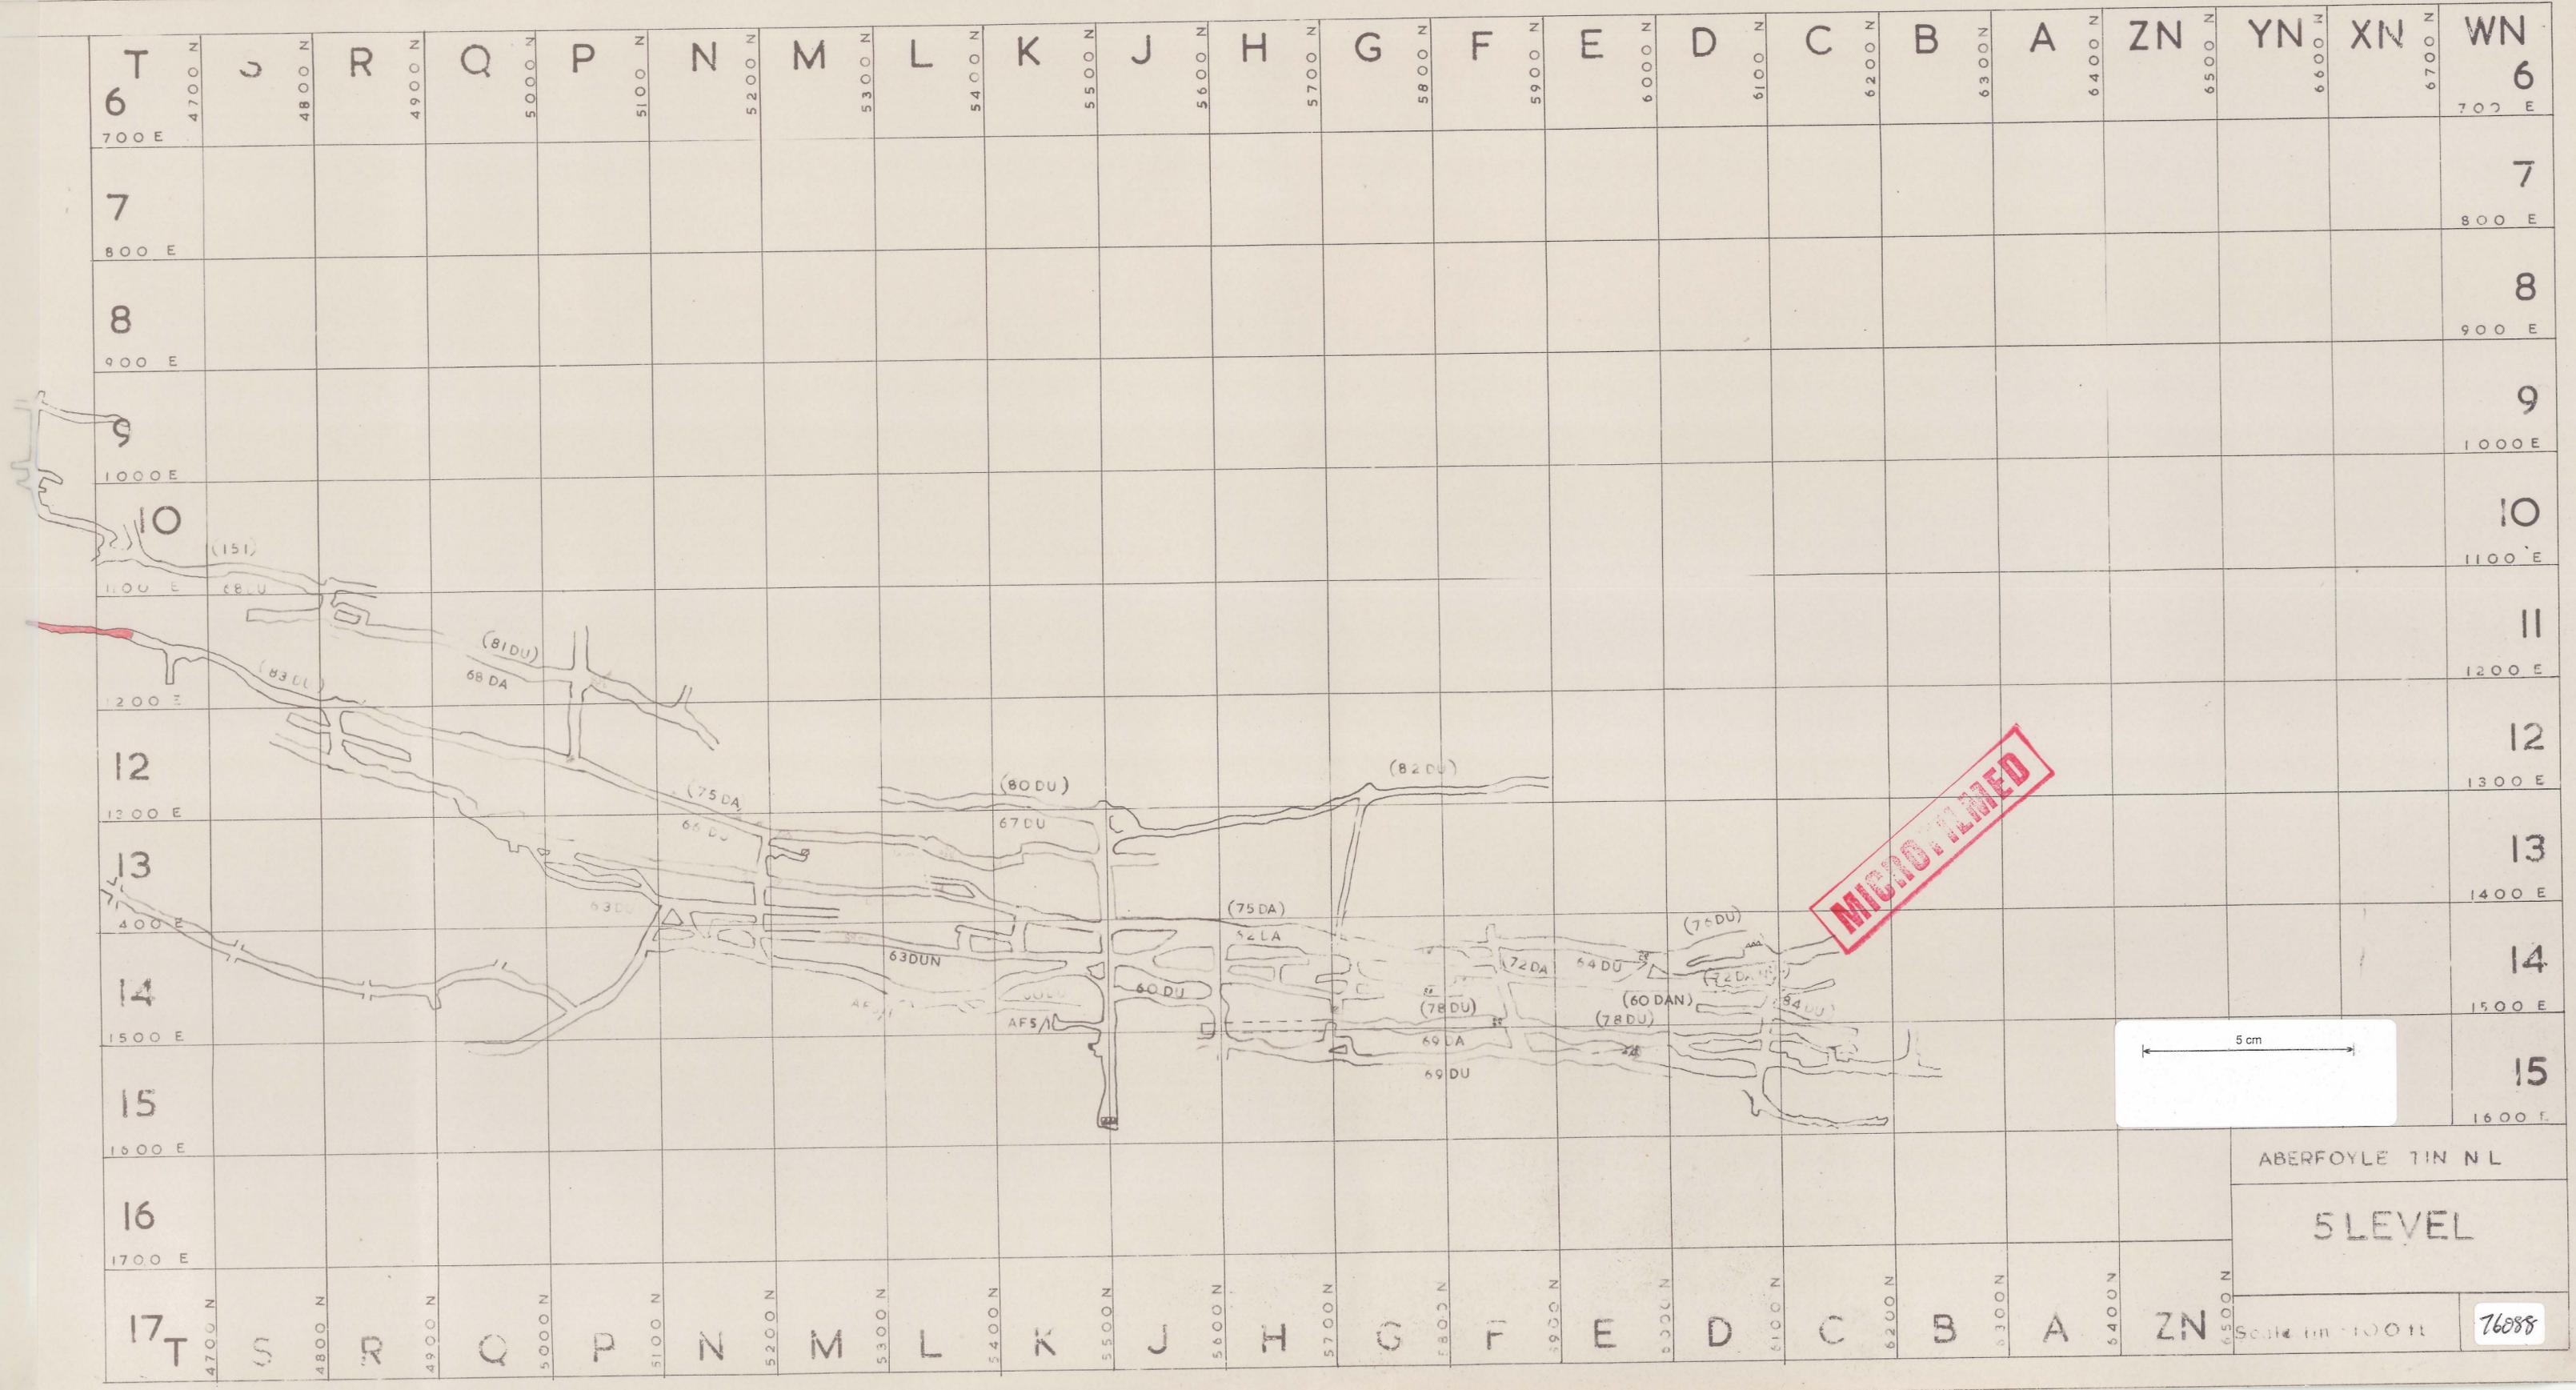

MICROFILMED

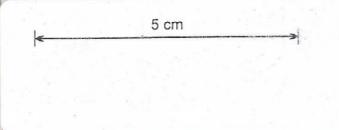

ABERFOYLE TIN N L

5 LEVEL

Scale 1 in = 100 ft

7688