


ABERF-586

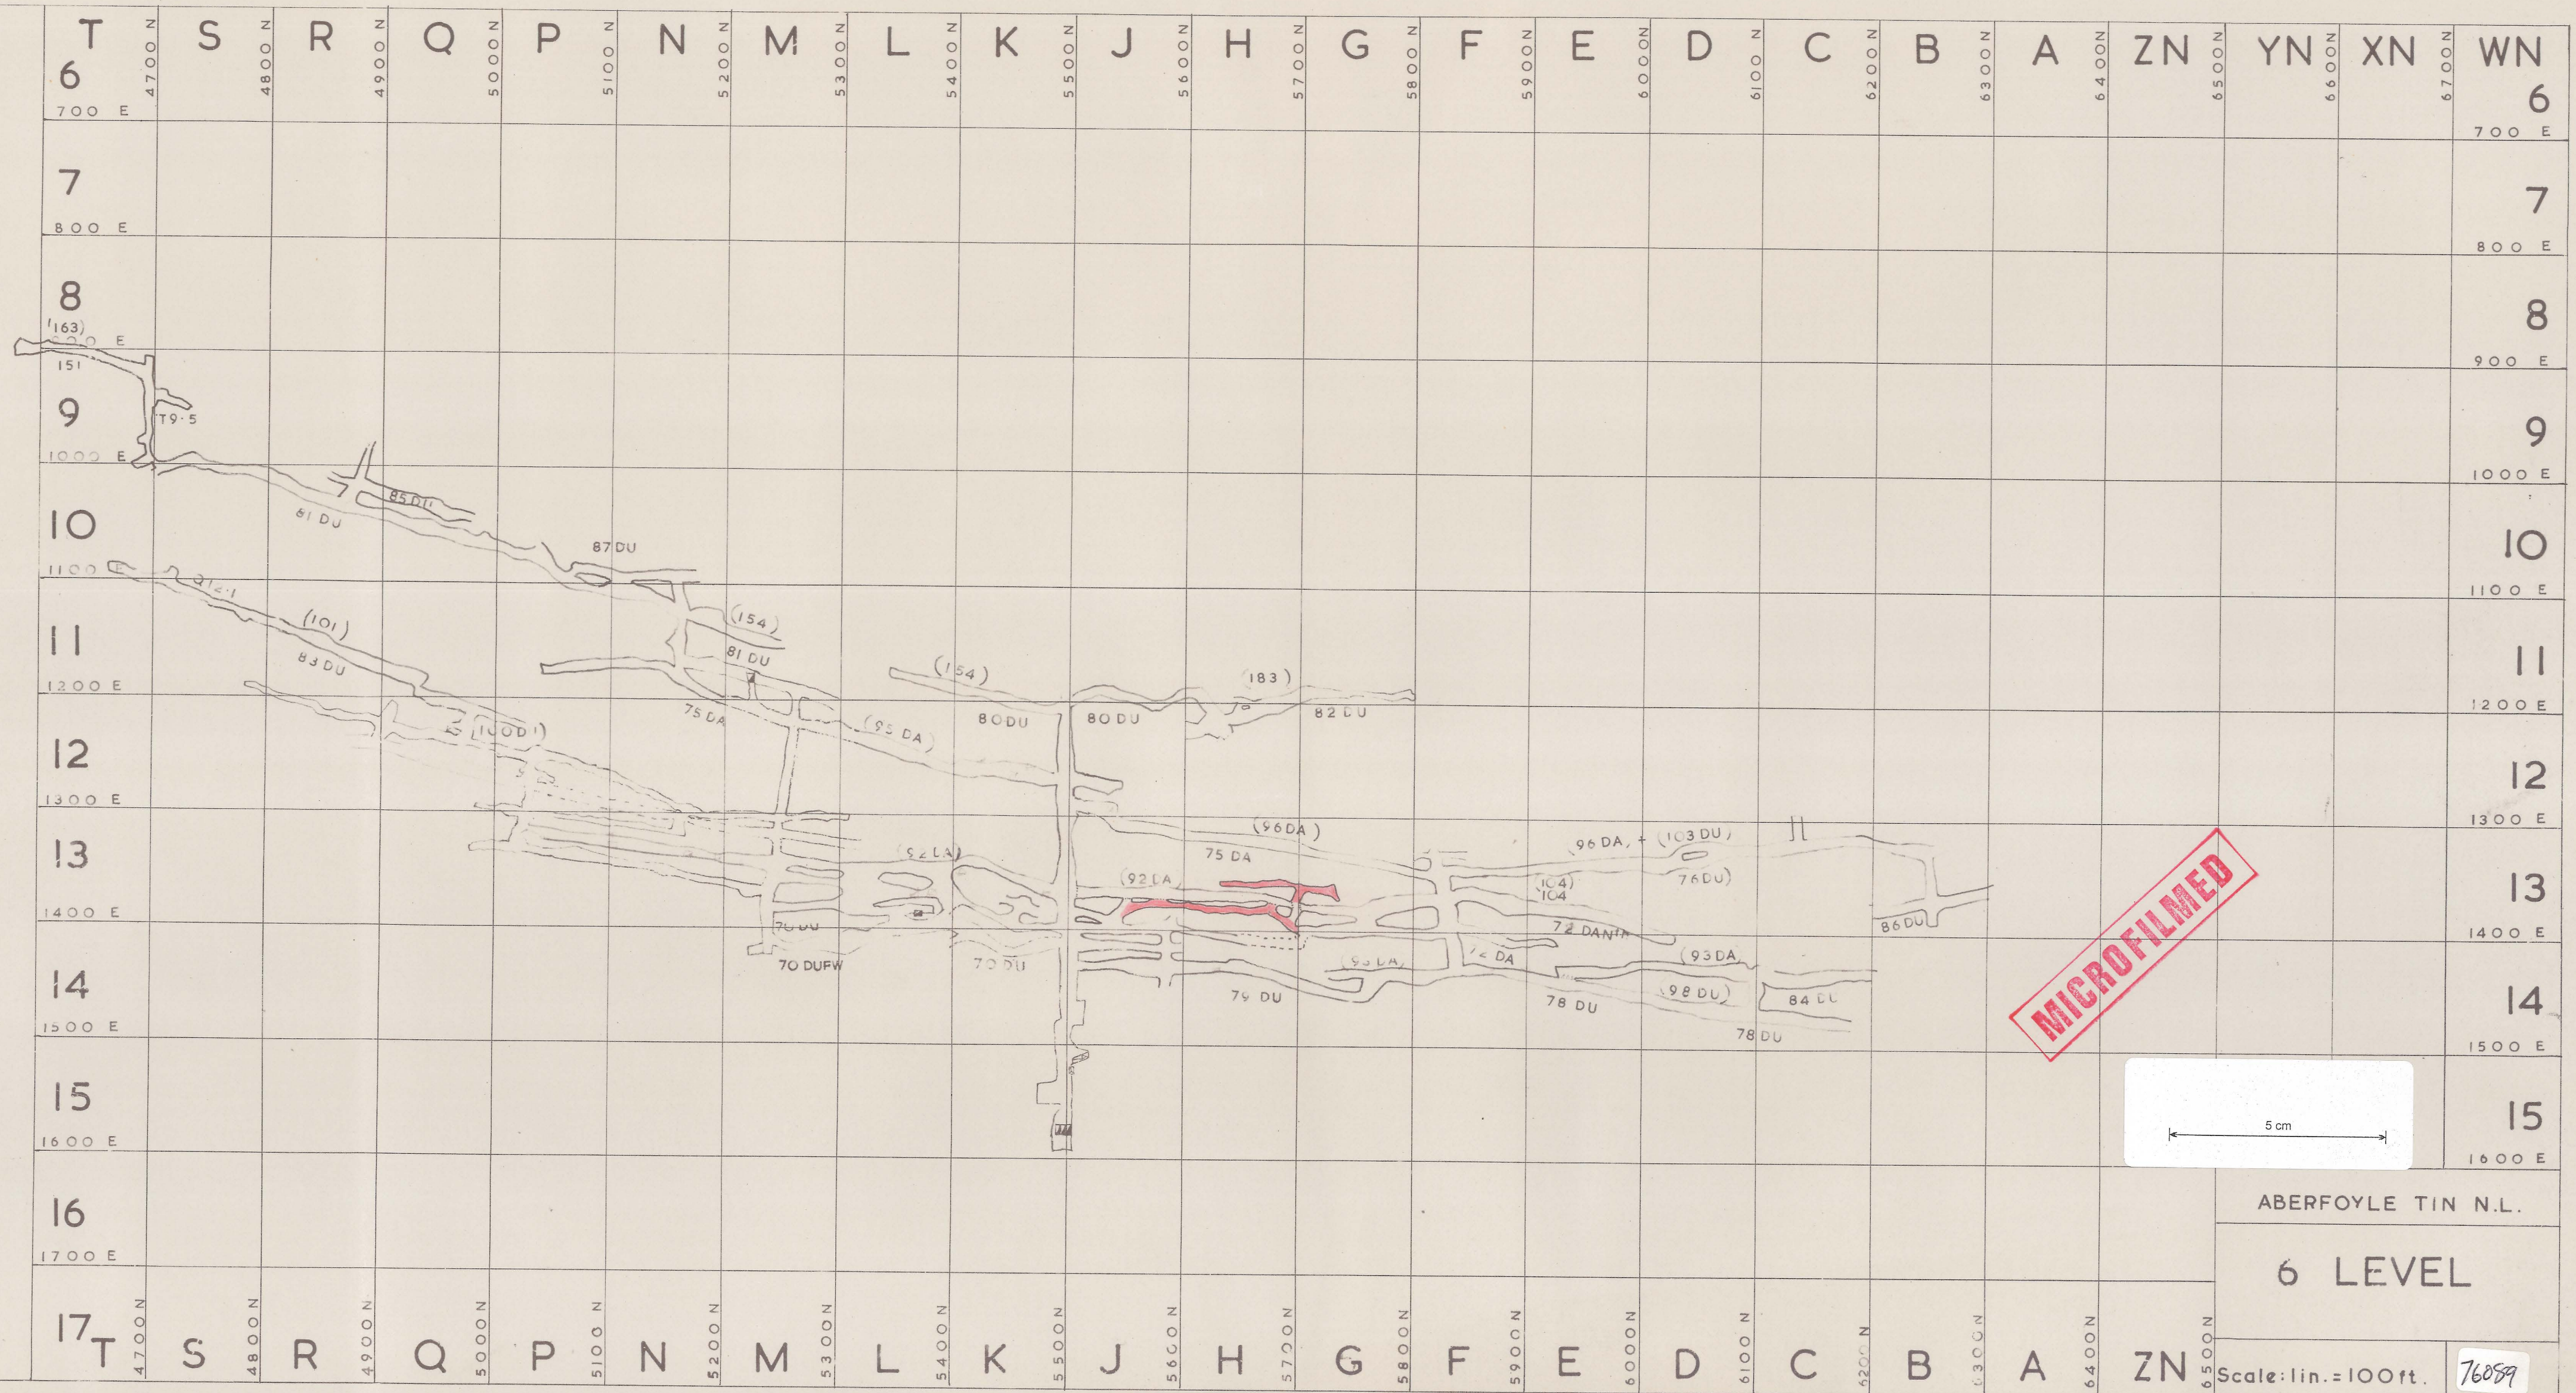

MICROFILMED

