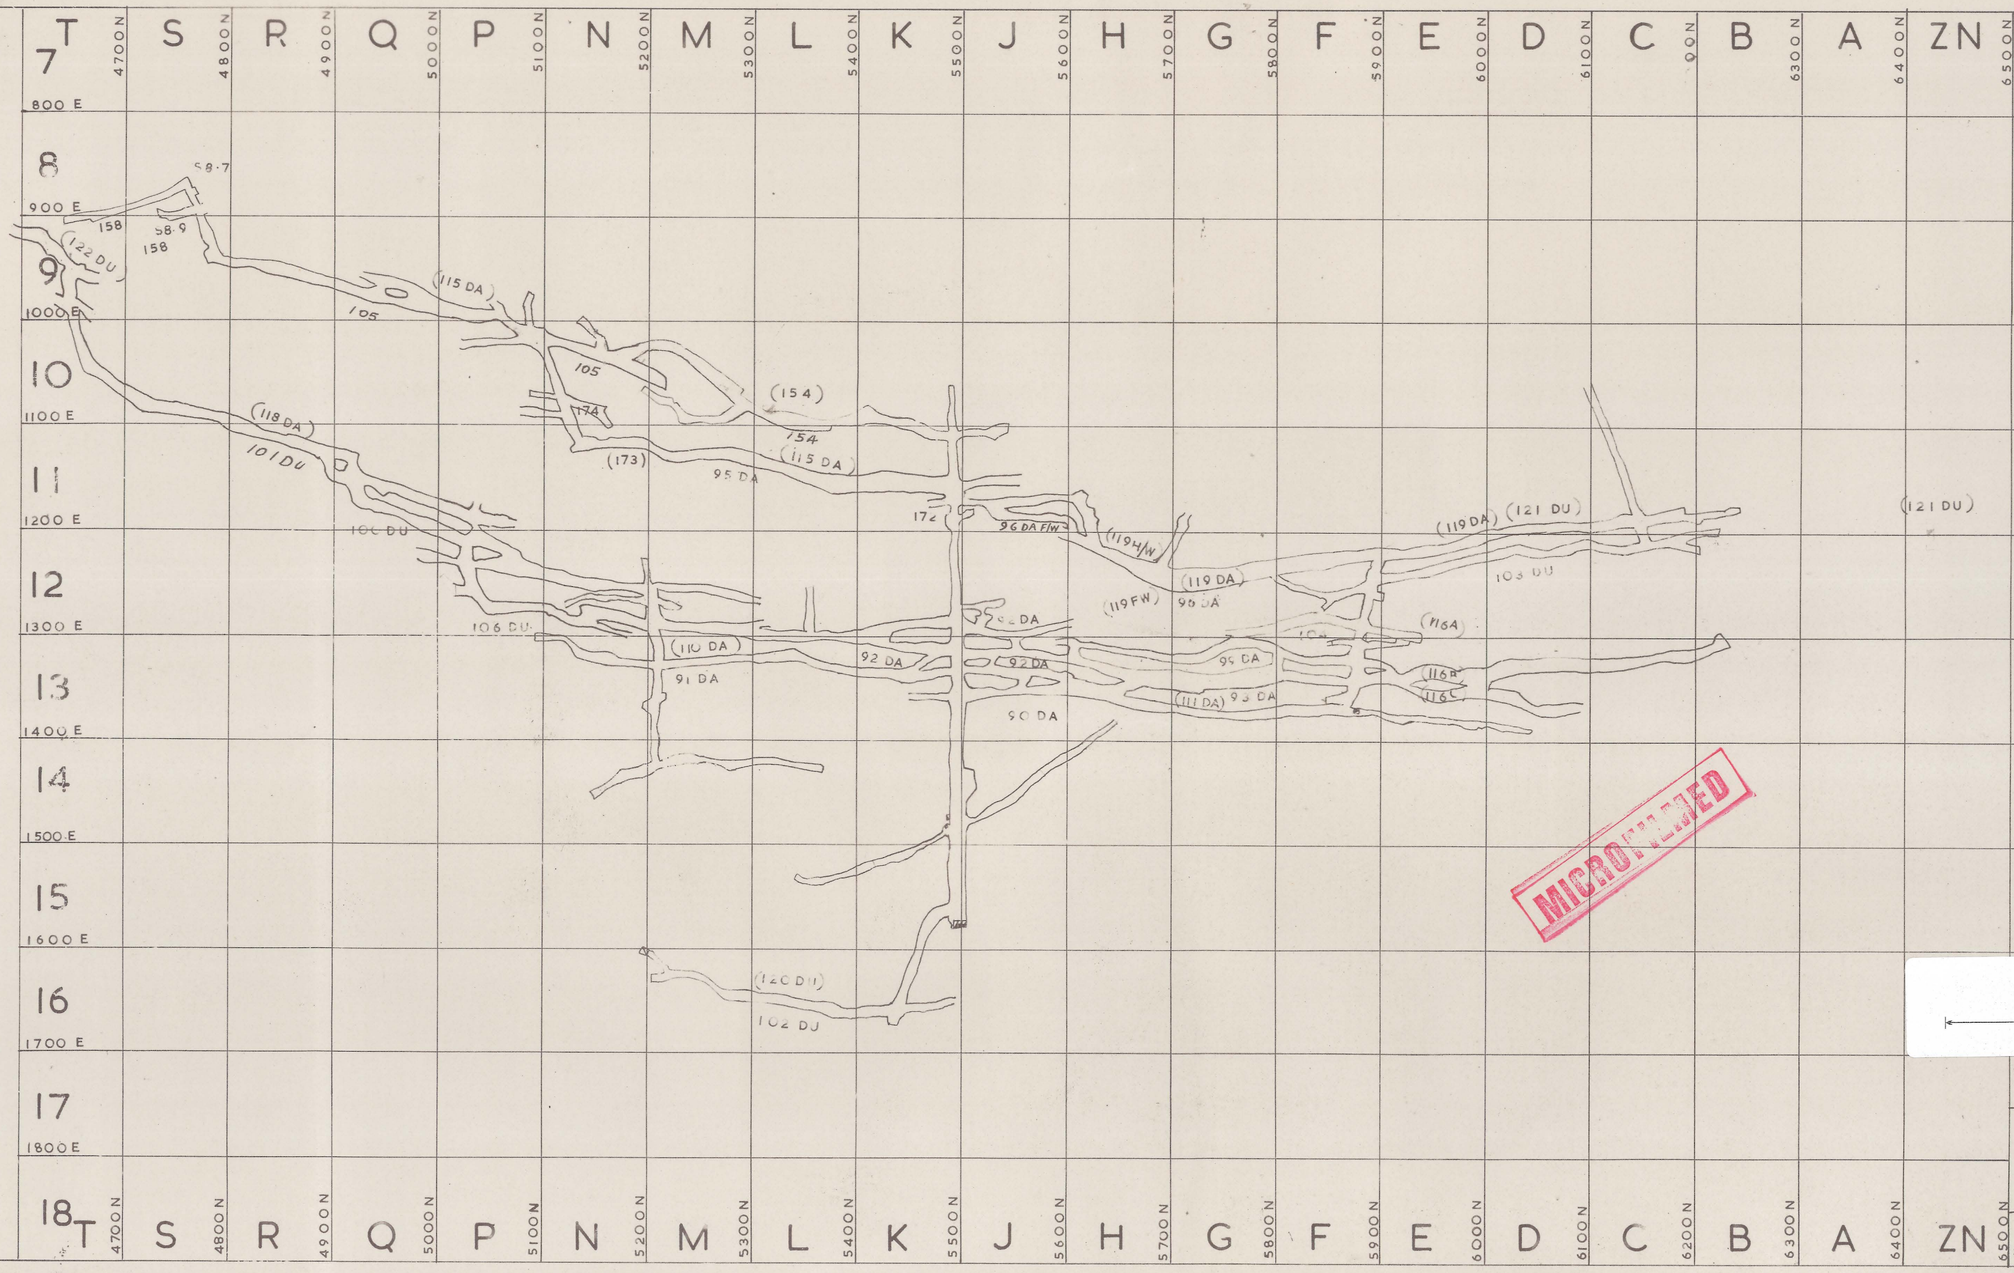

MICROFILMED

ABERF - S87