



ABERF-593

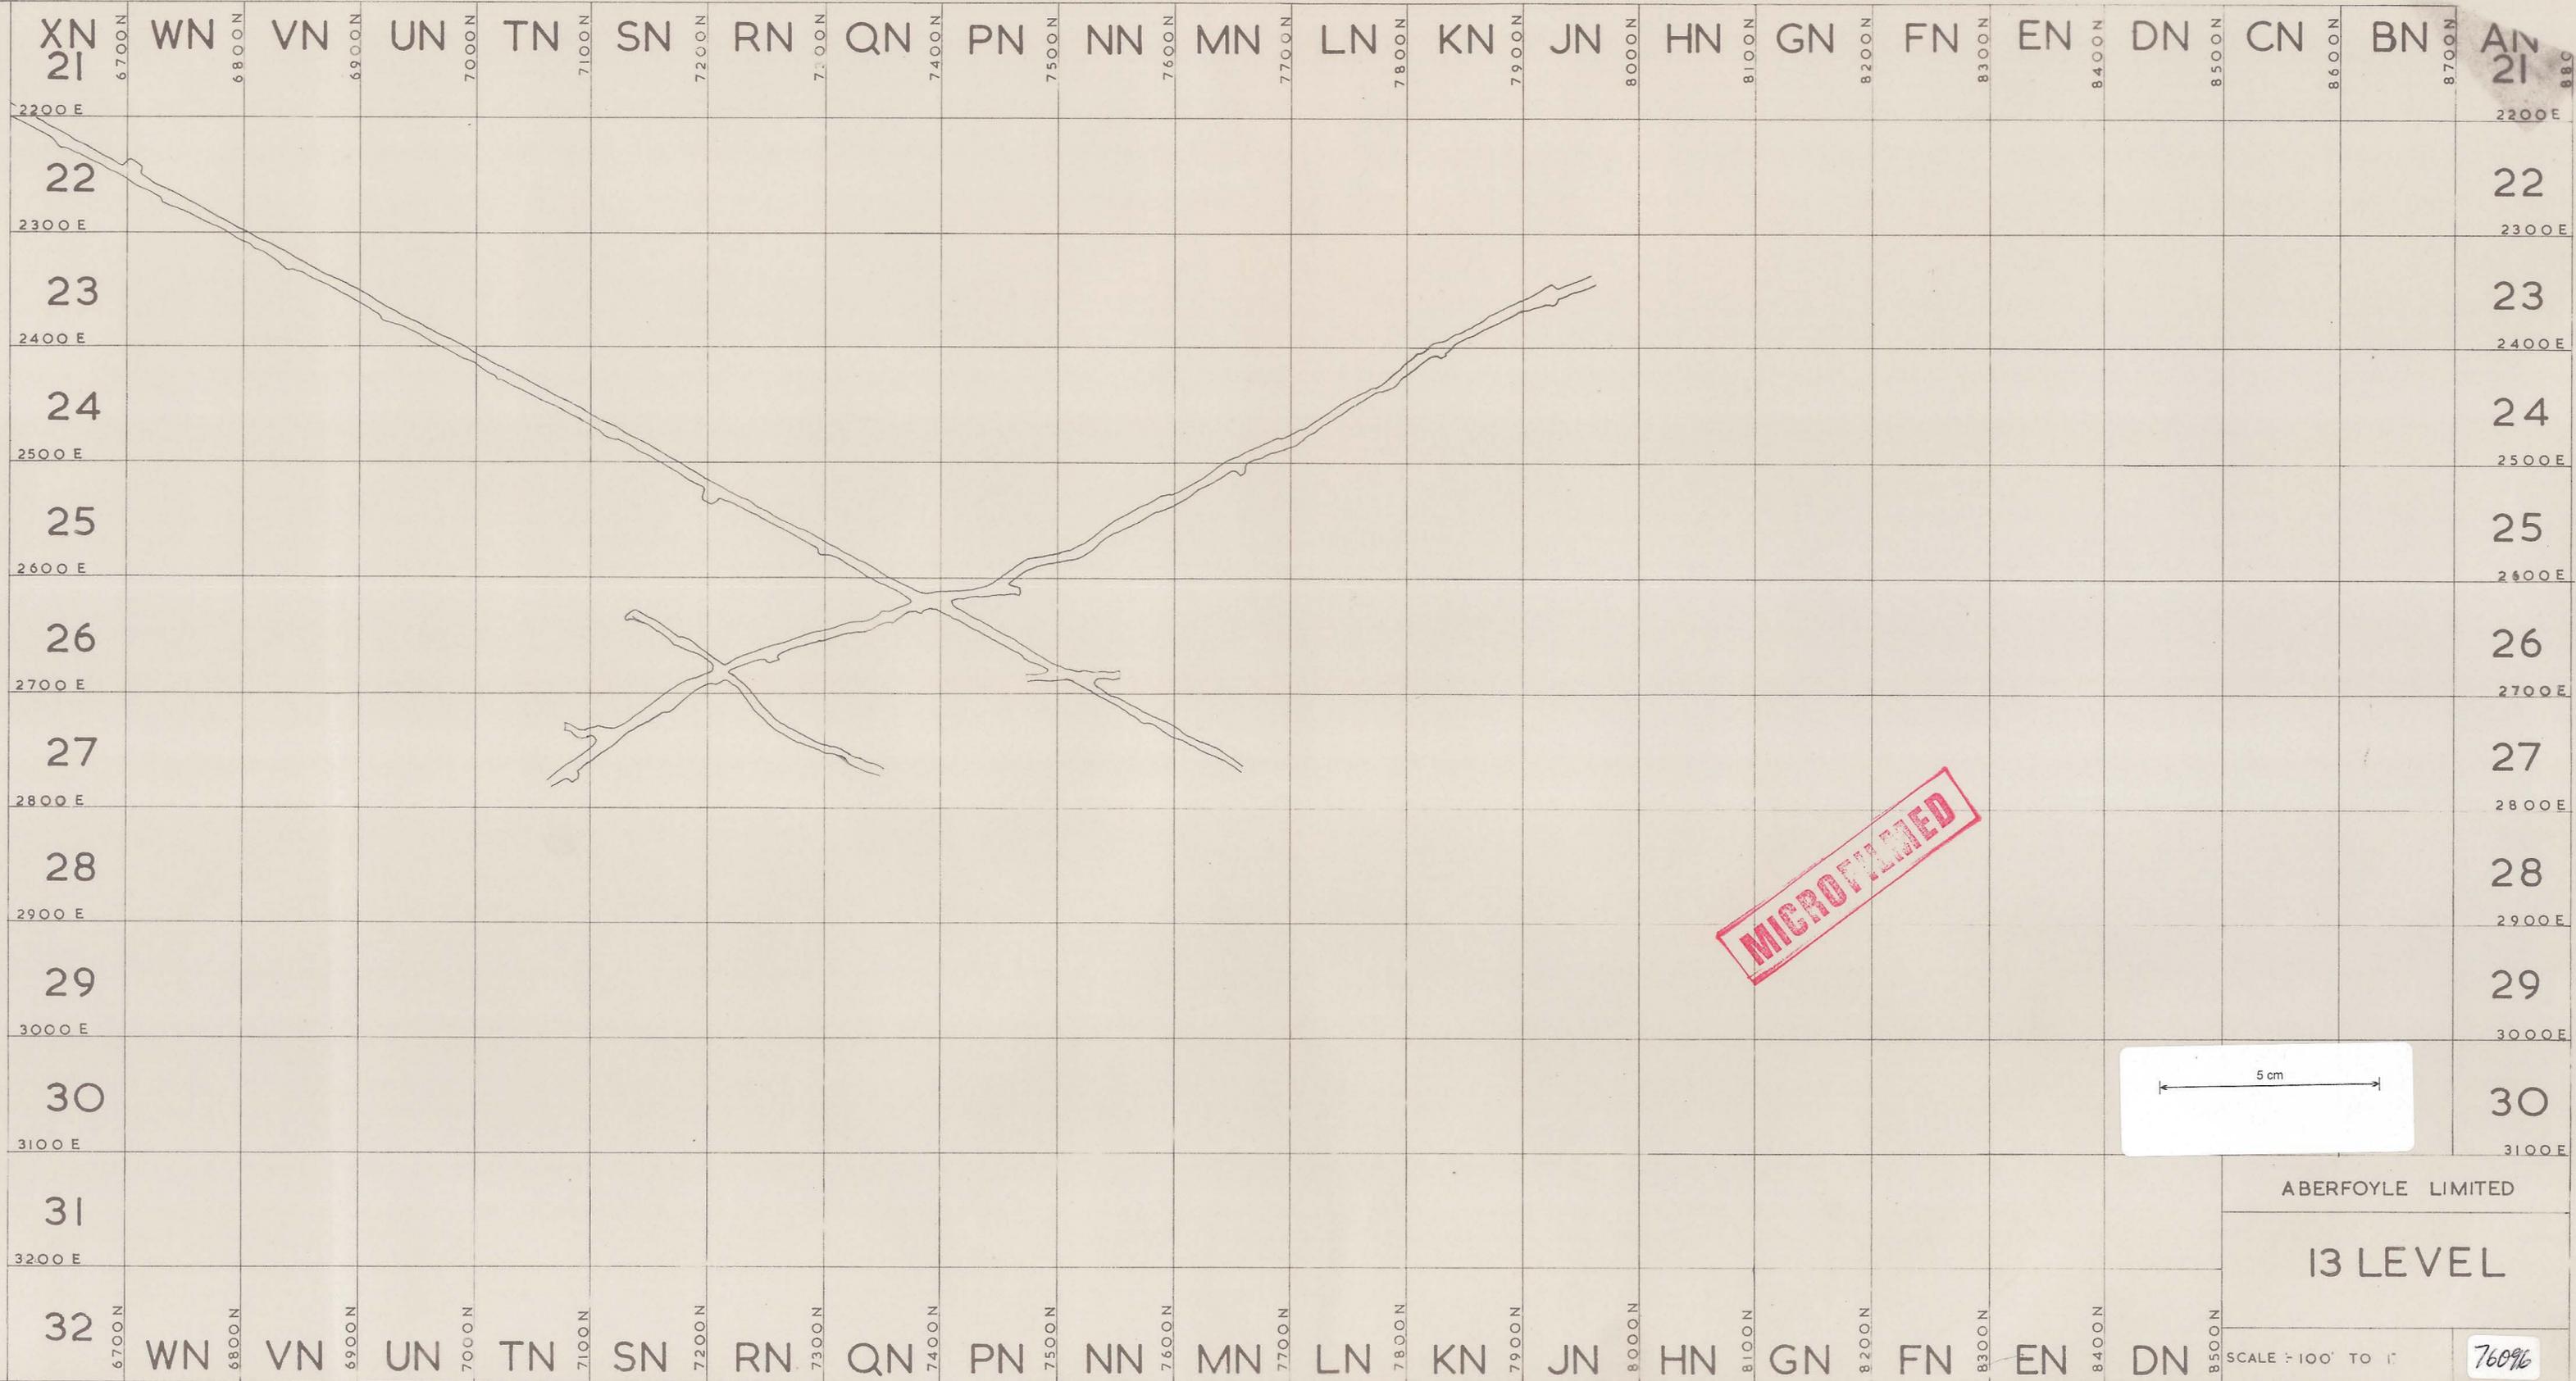

MICROFILMED

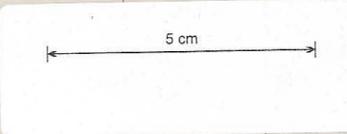

ABERFOYLE LIMITED

13 LEVEL

SCALE: 100' TO 1"

760%