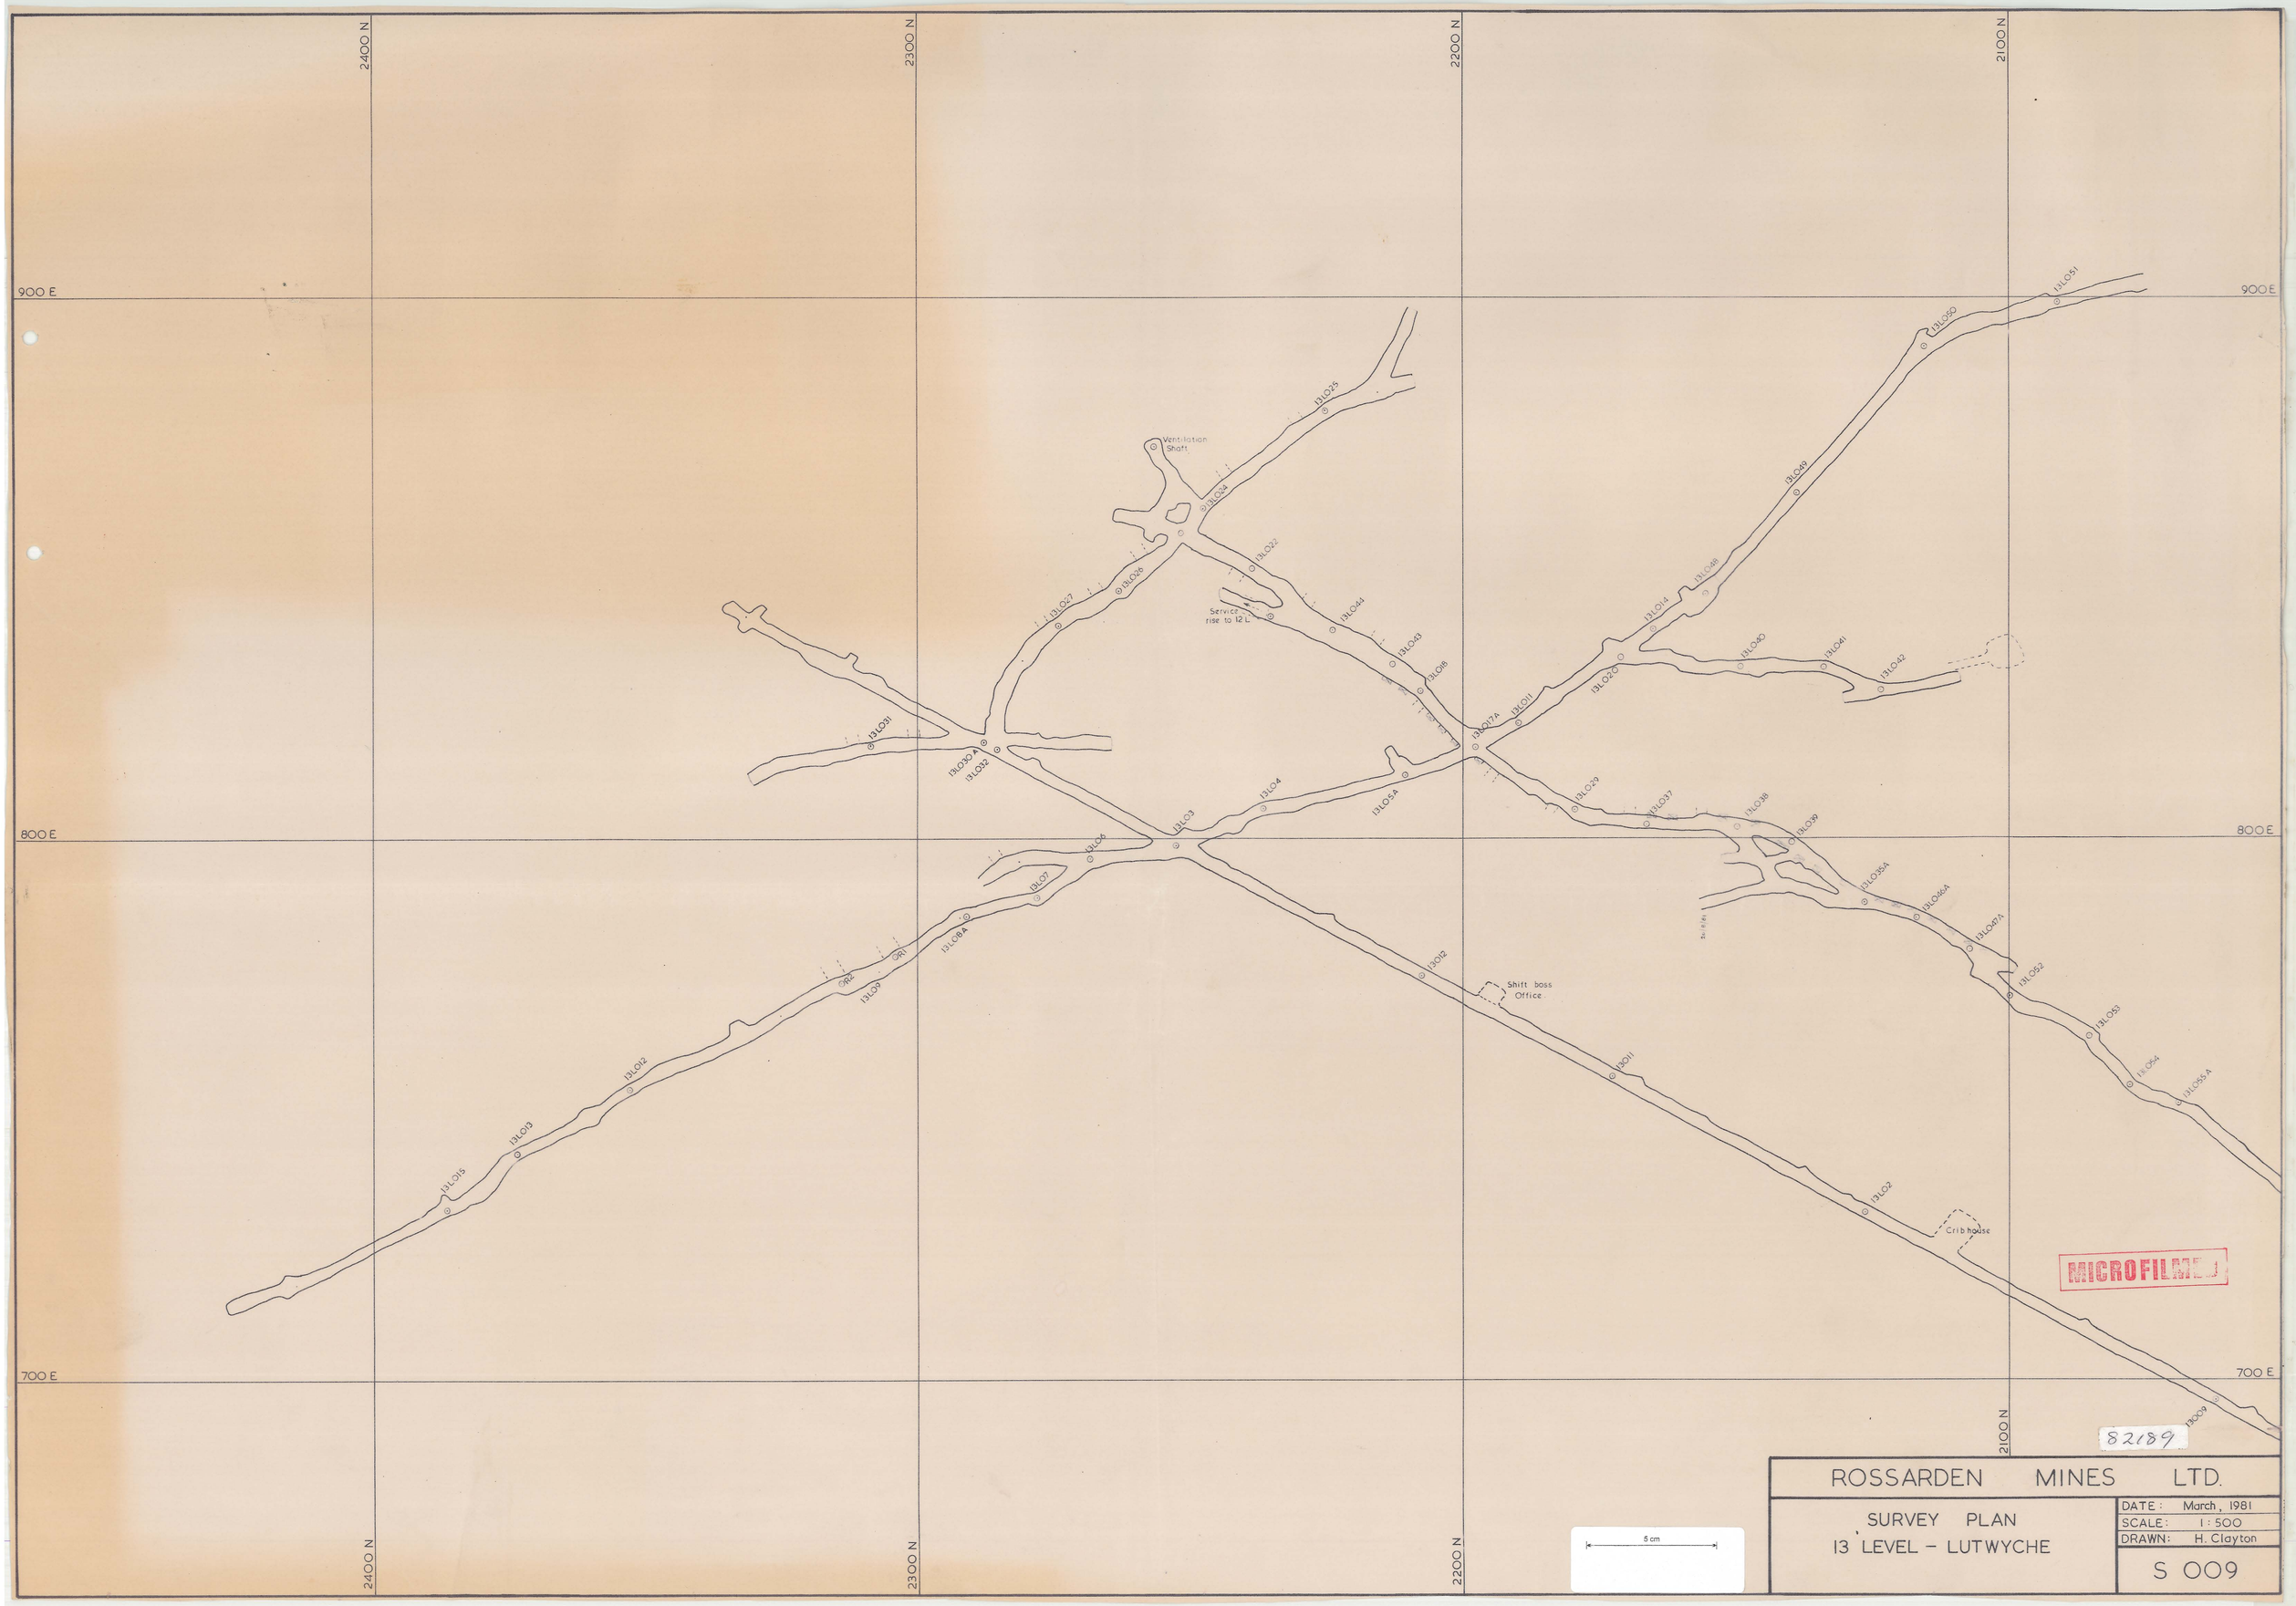

MICROFILMED
82189
TBERF-617

ROSSARDEN MINES LTD.

SURVEY PLAN
13 LEVEL – LUTWYCHE

DATE: March, 1981
SCALE: 1 : 500
DRAWN: H. Clayton

S 009