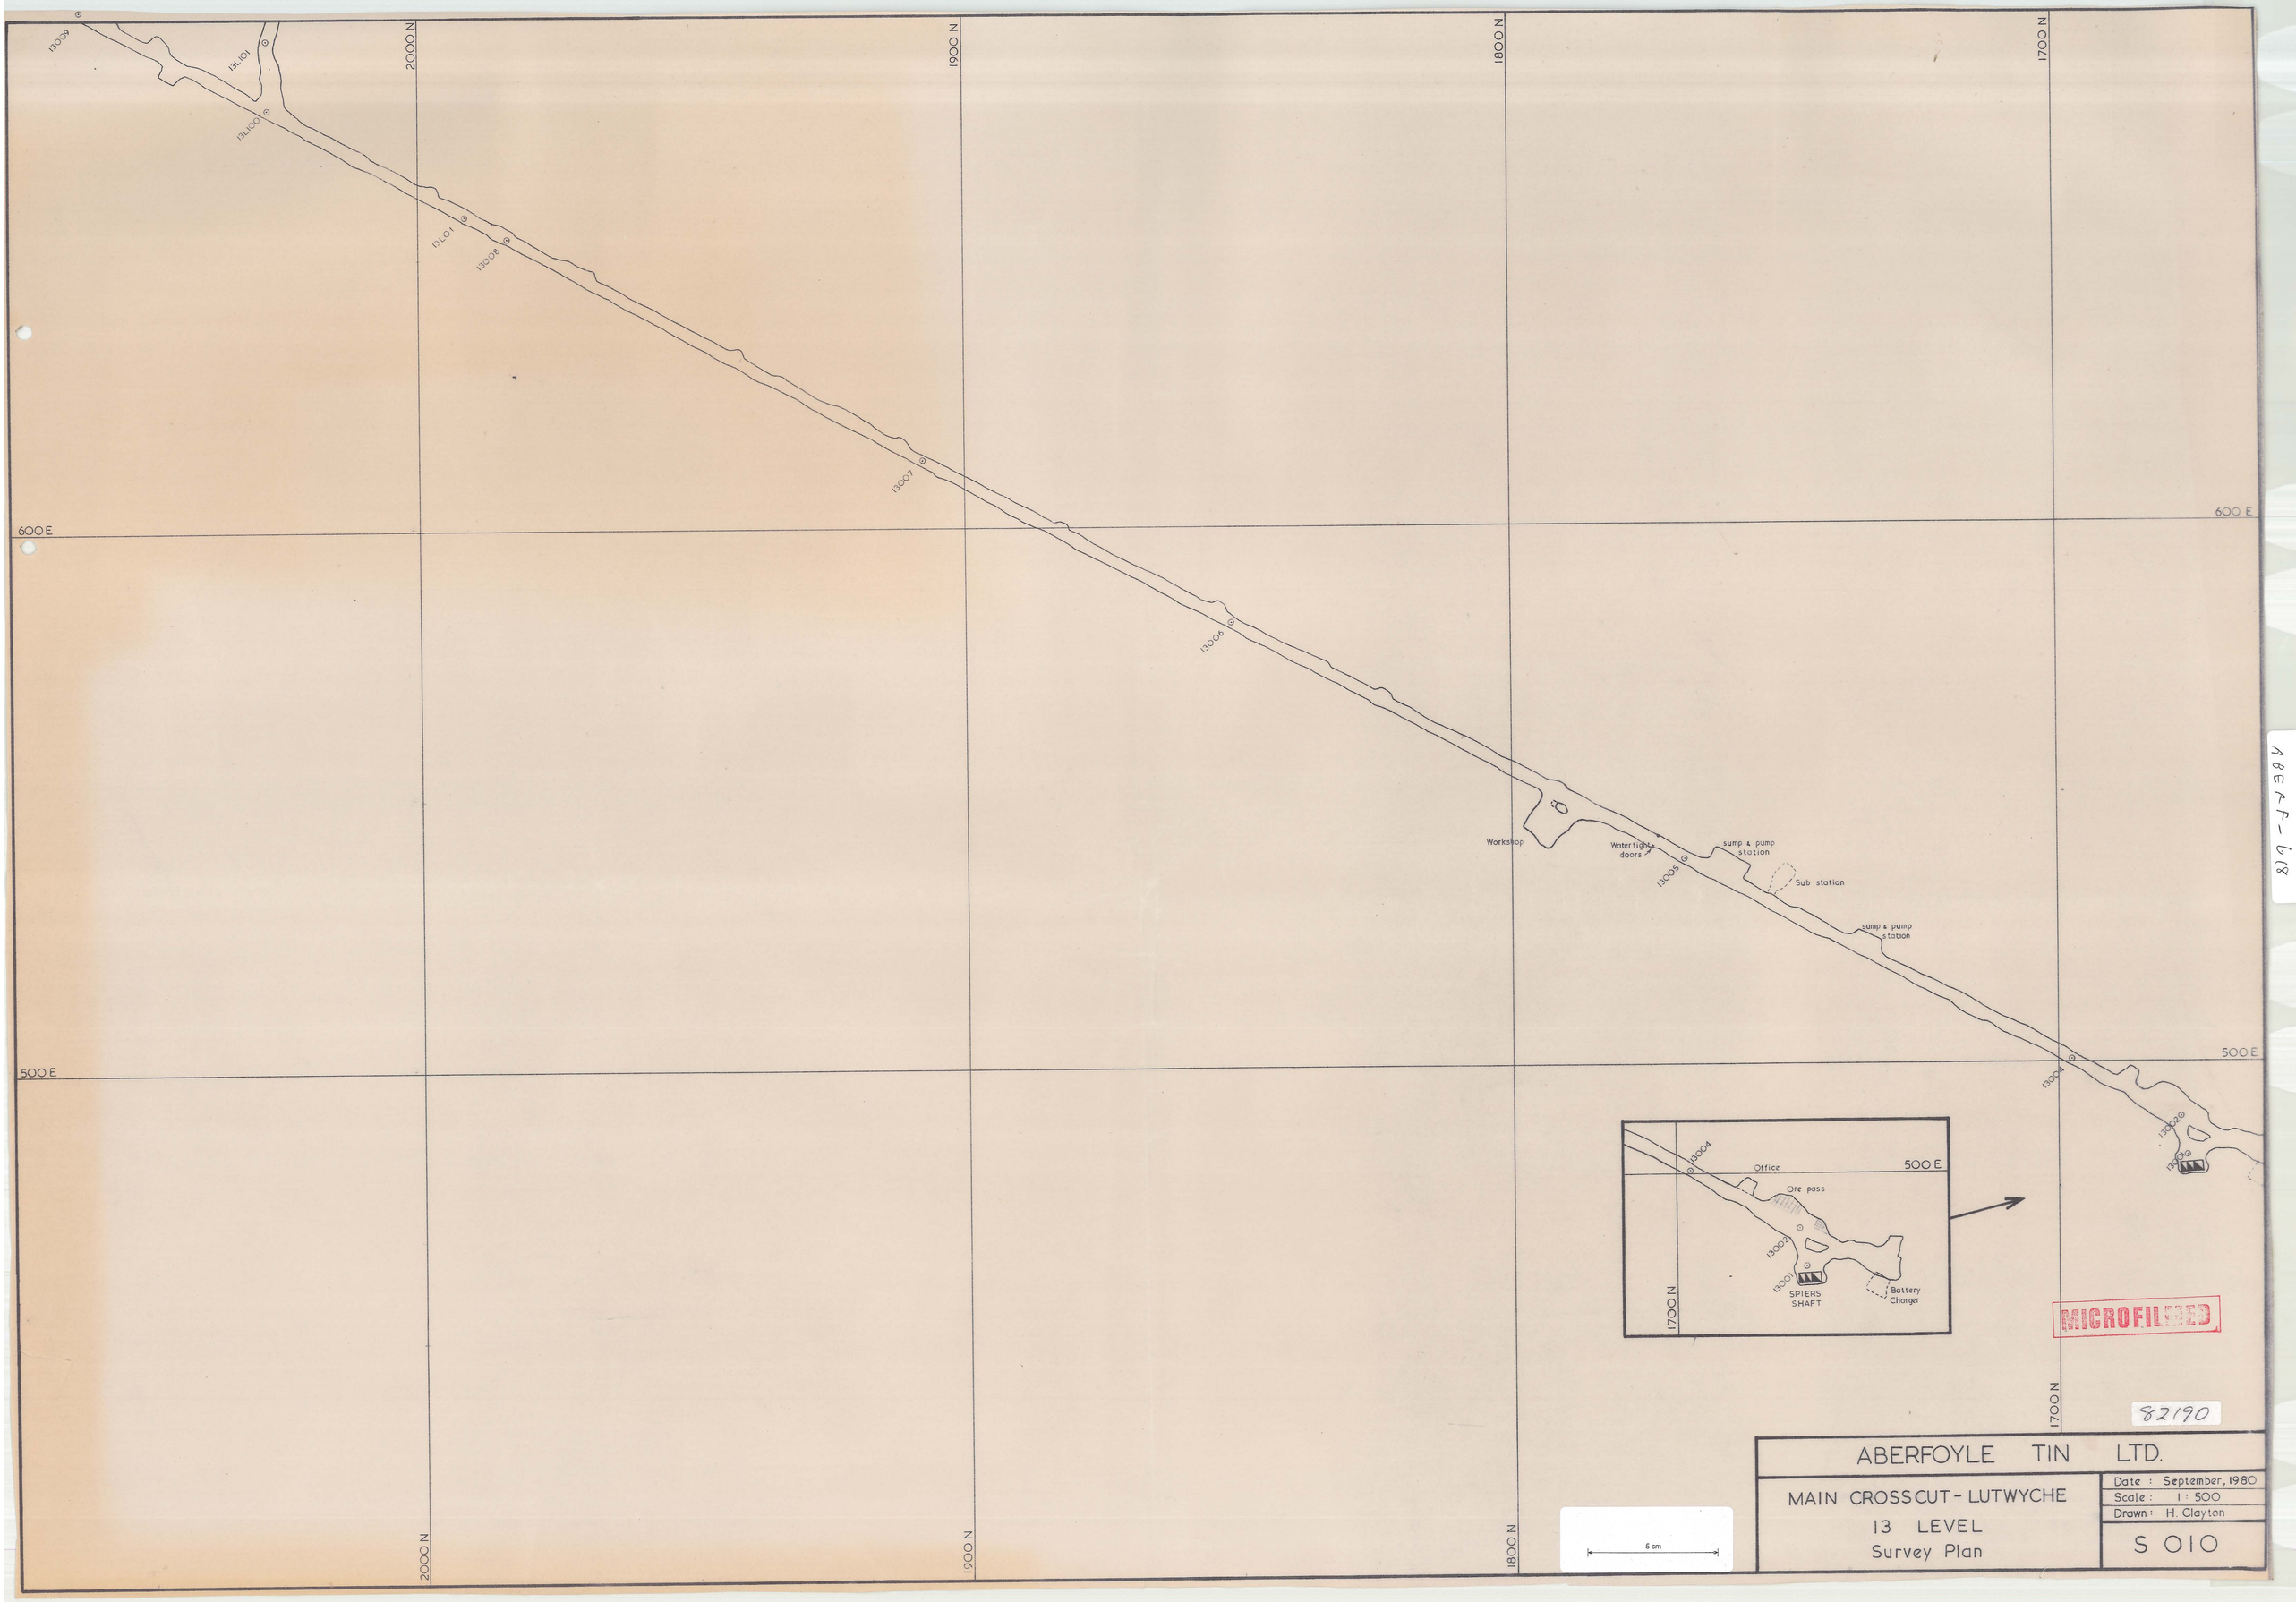

MICROFILMED

82190

ABERFOYLE TIN LTD.

MAIN CROSSCUT - LUTWYCHE
13 LEVEL
Survey Plan

Date : September, 1980
Scale : 1 : 500
Drawn : H. Clayton

S 010

ABE A-F-68