


APERF - 624

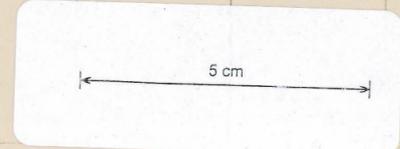

**MICROFILMED**

S . C . T . M . C .  
N° 1 LEVEL



SURVEYED	SCALE 1:100
DRAWN	RL = 2429.00
DATE 31-12-	

XX009