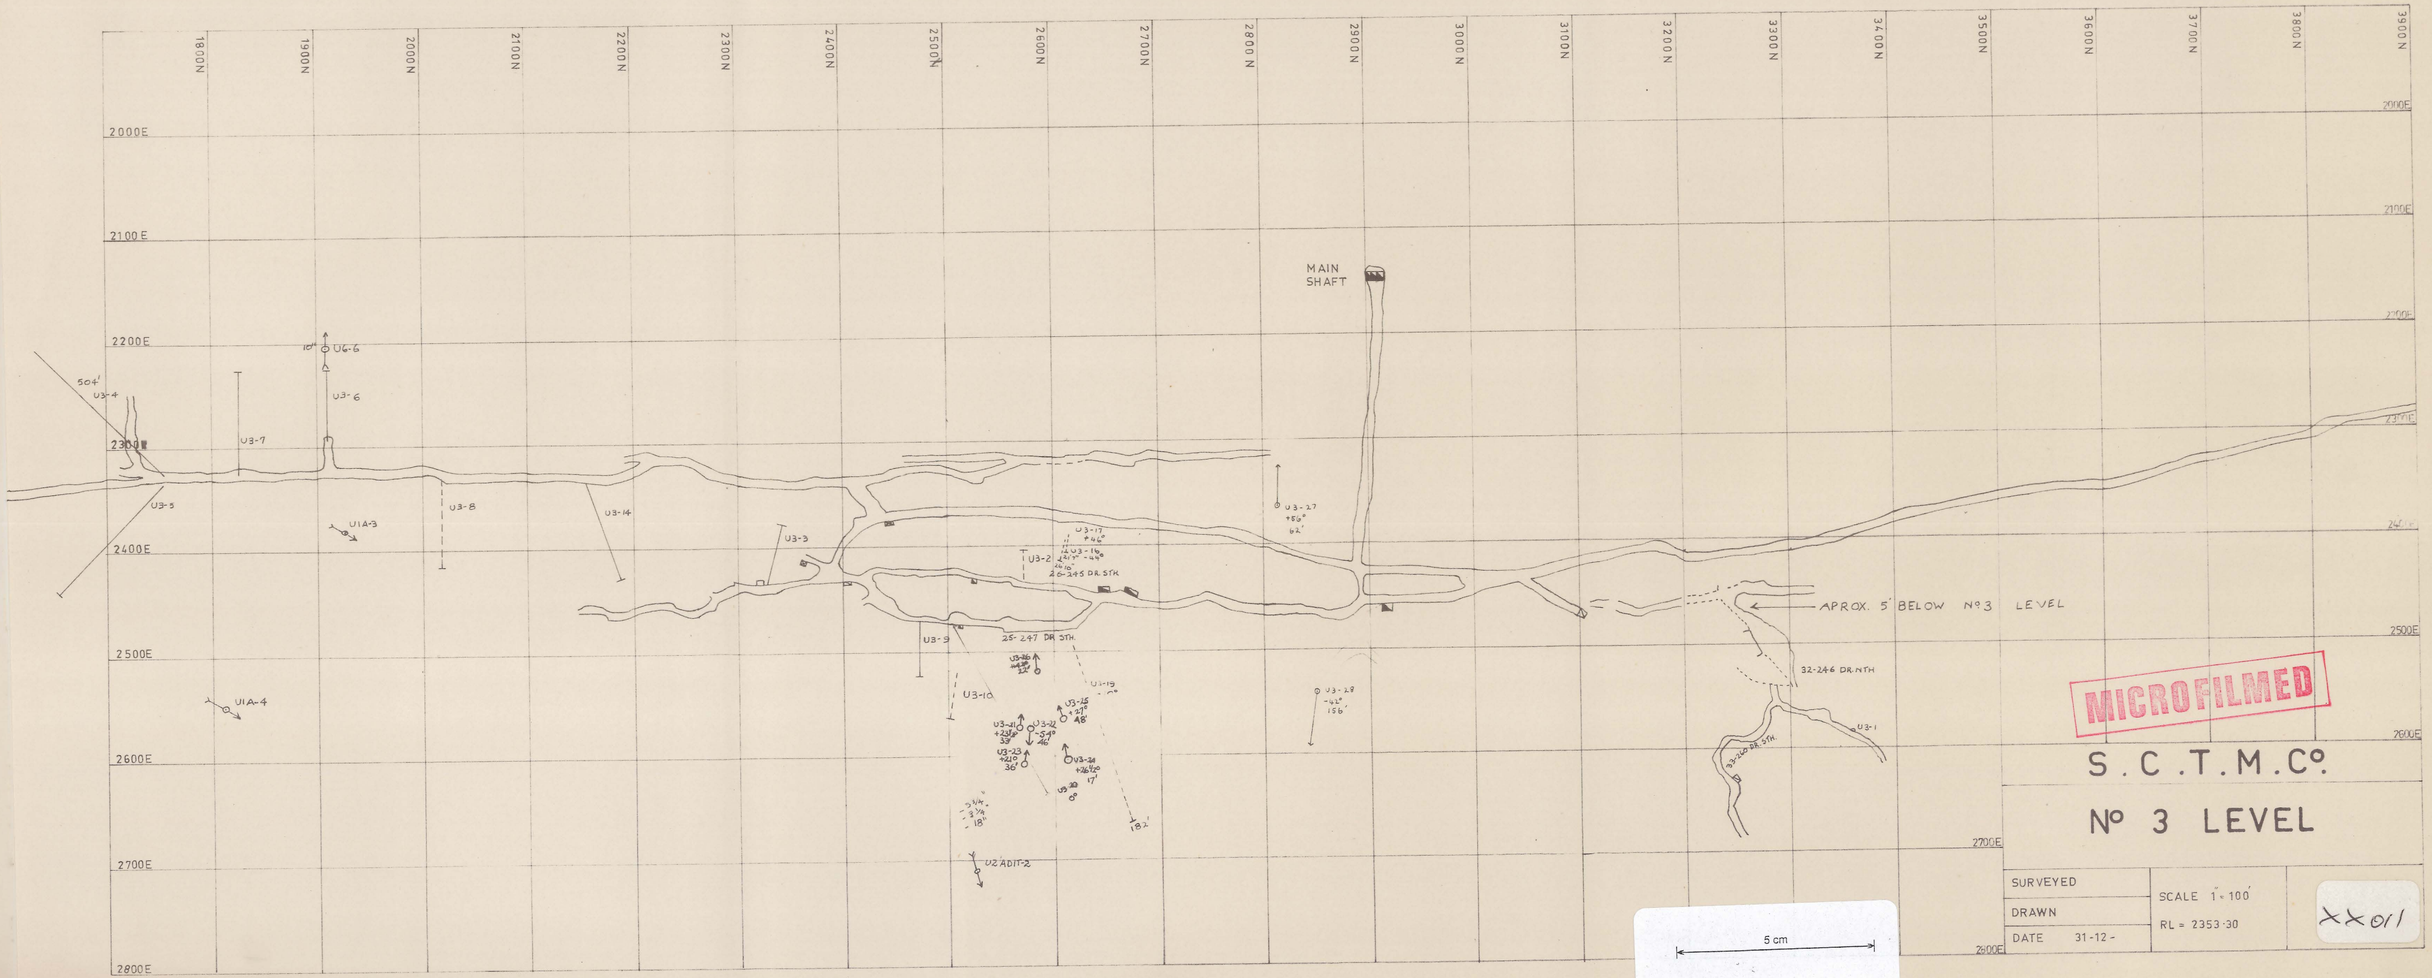


MICROFILMED

S.C.T.M.Co.

No 3 LEVEL

| | |
|---|---|
| SURVEYED | SCALE 1" = 100' |
| DRAWN | RL = 2353·30 |
| DATE 31-12- | |

XX011

ABERF - 626