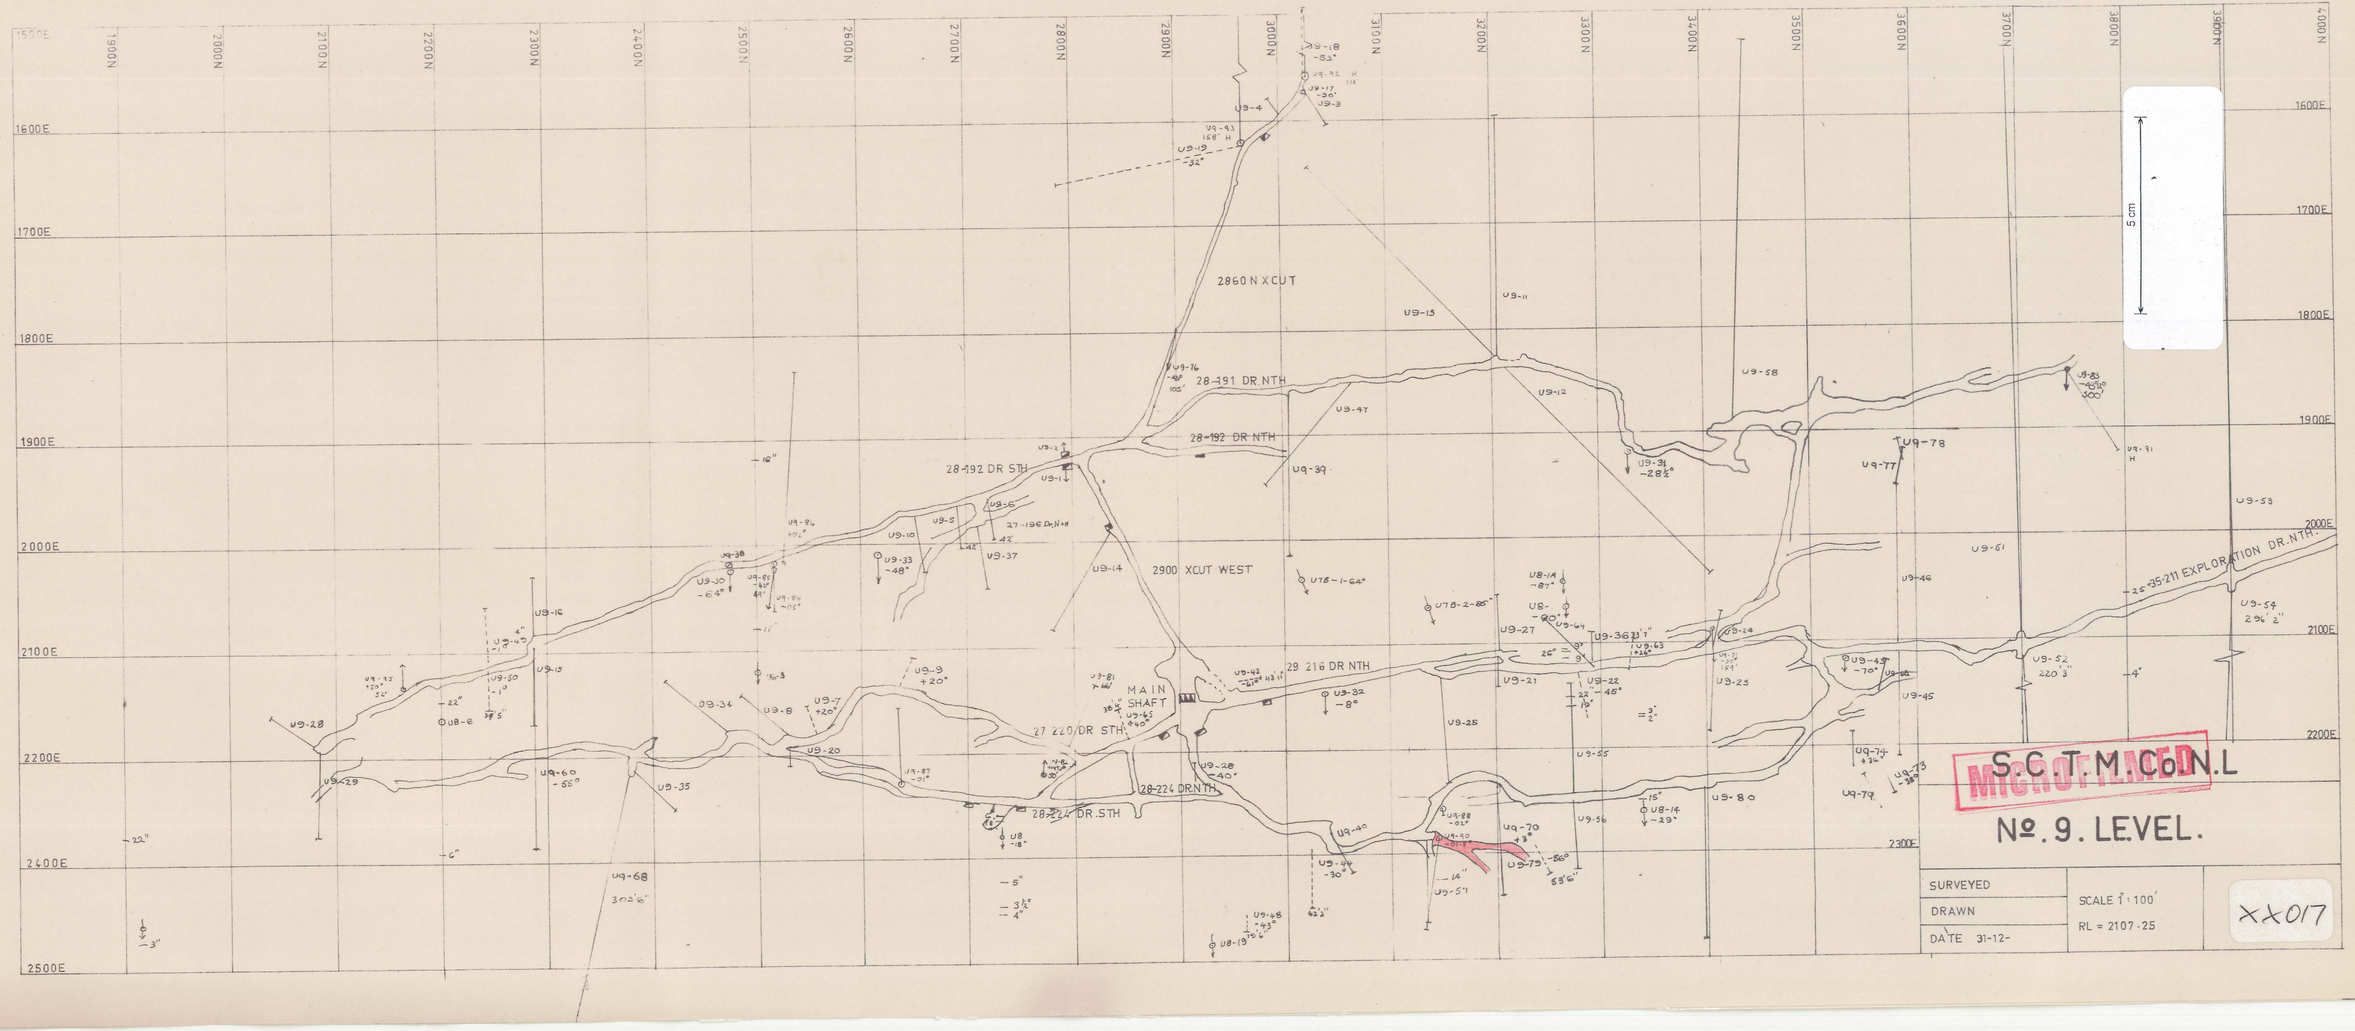
S.C.T.M. Co. N.L
No. 9. LEVEL.
SURVEYED
DRAWN
DATE 31-12-
SCALE 1" : 100'
RL = 2107.25
XX017
MICROFILMED
2860 N XCUT
28-191 DR NTH
28-192 DR NTH
28-192 DR STH
2900 XCUT WEST
MAIN SHAFT
29 216 DR NTH
27 220 DR STH
28-224 DR NTH
28-224 DR STH
25-35-211 EXPLORATION DR. NTH.
5 cm

ABERA - 632