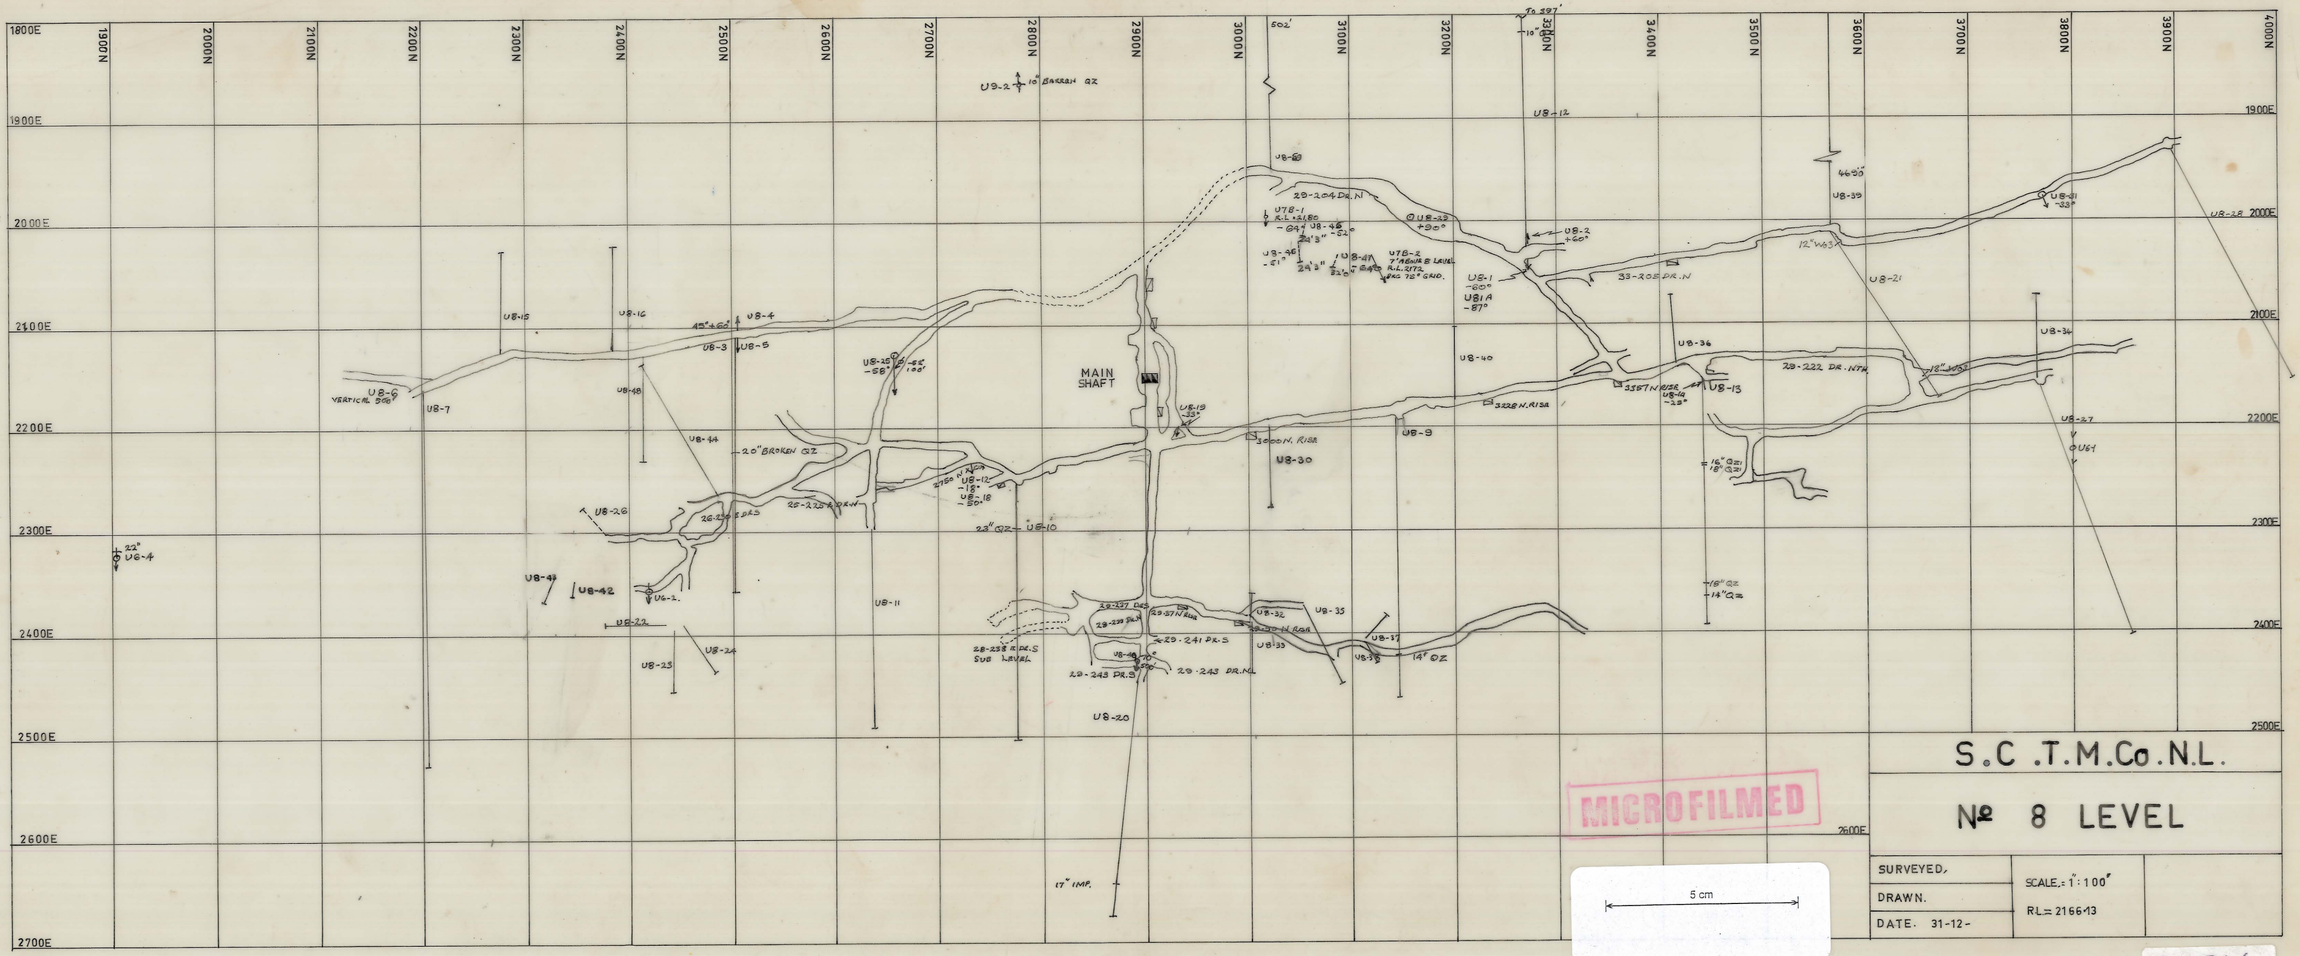
1800E
1900E
2000E
2100E
2200E
2300E
2400E
2500E
2600E
2700E
1900N
2000N
2100N
2200N
2300N
2400N
2500N
2600N
2700N
2800N
2900N
3000N
3100N
3200N
3300N
3400N
3500N
3600N
3700N
3800N
3900N
4000N
MAIN SHAFT
U8-9
U8-30
U8-40
U8-12
U8-13
U8-14
U8-21
U8-34
U8-35
U8-32
U8-33
U8-17
U8-20
U8-10
U8-11
U8-23
U8-24
U8-25
U8-26
U8-42
U8-41
U8-44
U8-48
U8-15
U8-16
U8-3
U8-4
U8-5
U8-6
U8-7
U8-19
U8-27
U8-28
U8-39
U8-31
U8-2
U8-1
U8-18
U8-46
U8-47
U8-4
U6-2
20-204 DR. N
33-205 DR. N
29-222 DR. NTH
3567 N RISE
3228 N. RISE
3000 N. RISE
29-237 DR.
29-239 DR.
29-241 PR. S
29-243 DR. NL
28-238 R. DR. S
SUB LEVEL
20" BROKEN QZ
23" QZ
14" QZ
16" QZ
12" IMP.
10" BARREN QZ
To 197'
502'
4695'
S.C.T.M.Co.N.L.
№ 8 LEVEL
SURVEYED.
DRAWN.
DATE. 31-12-
SCALE.= 1" : 100'
RL.= 2166·13
5 cm
MICROFILMED
82266
ABERF-638