


ABERF-654

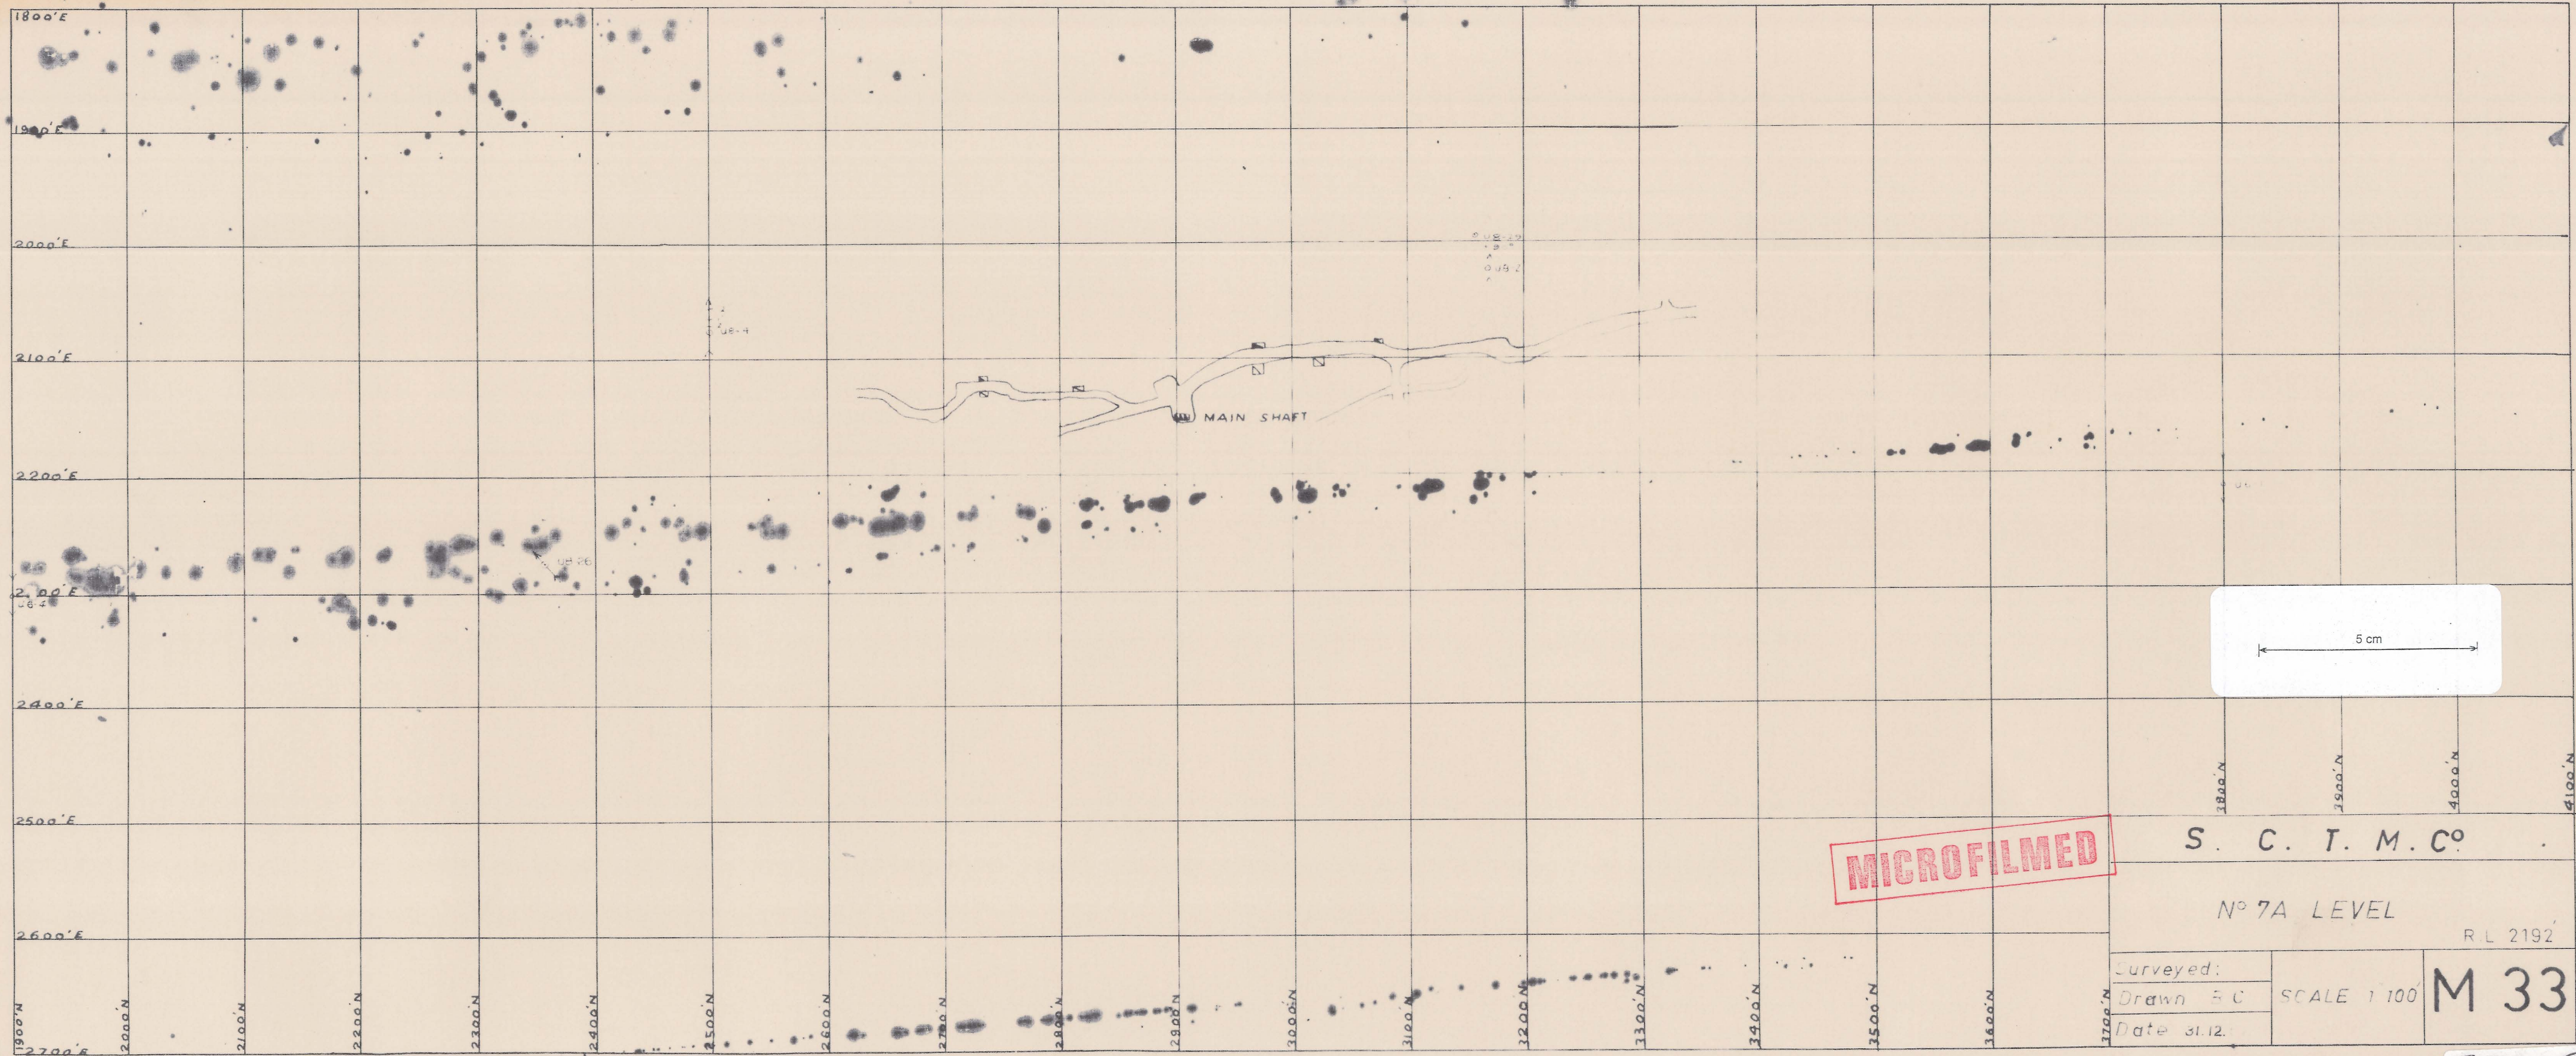

82245