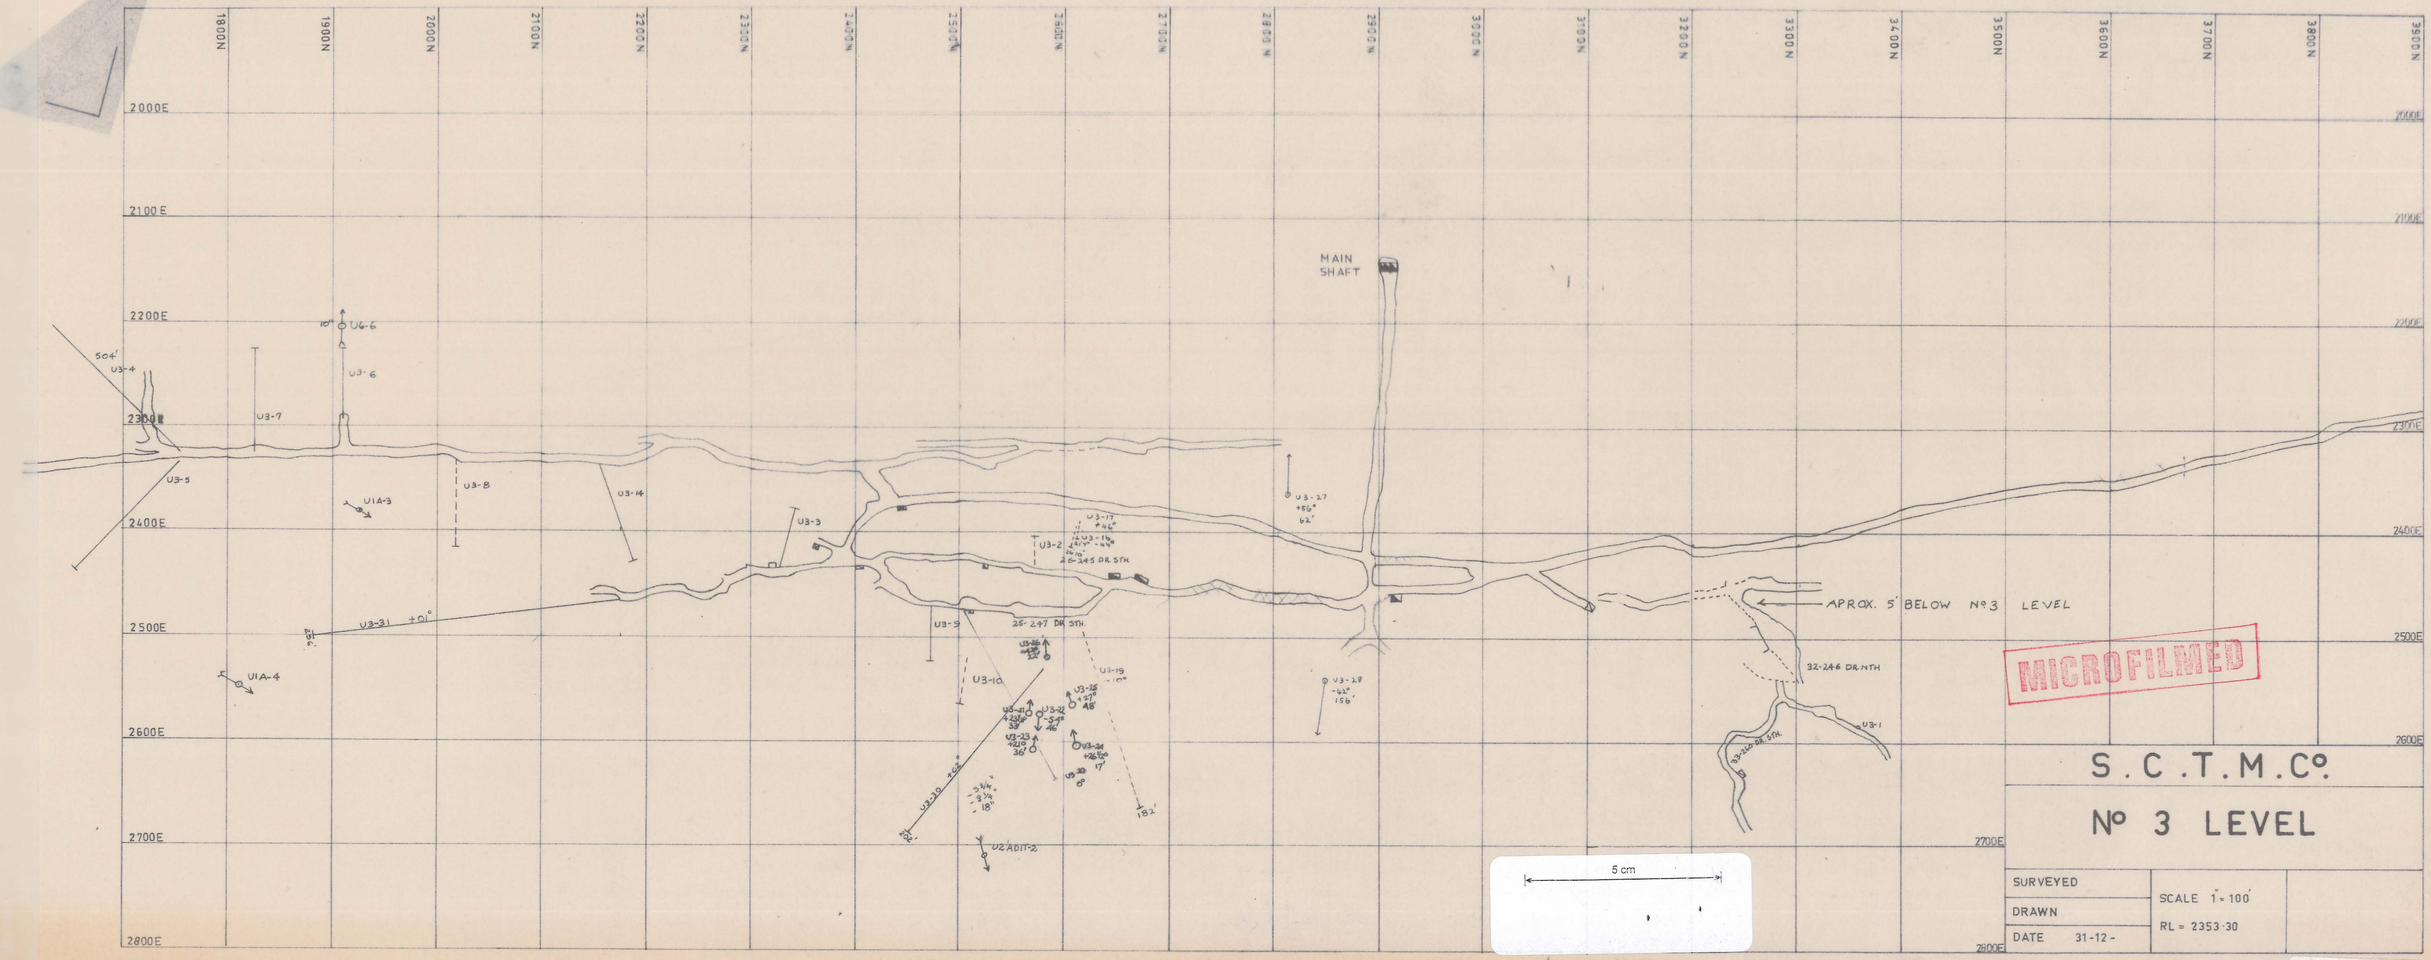

ABERF-661

82239