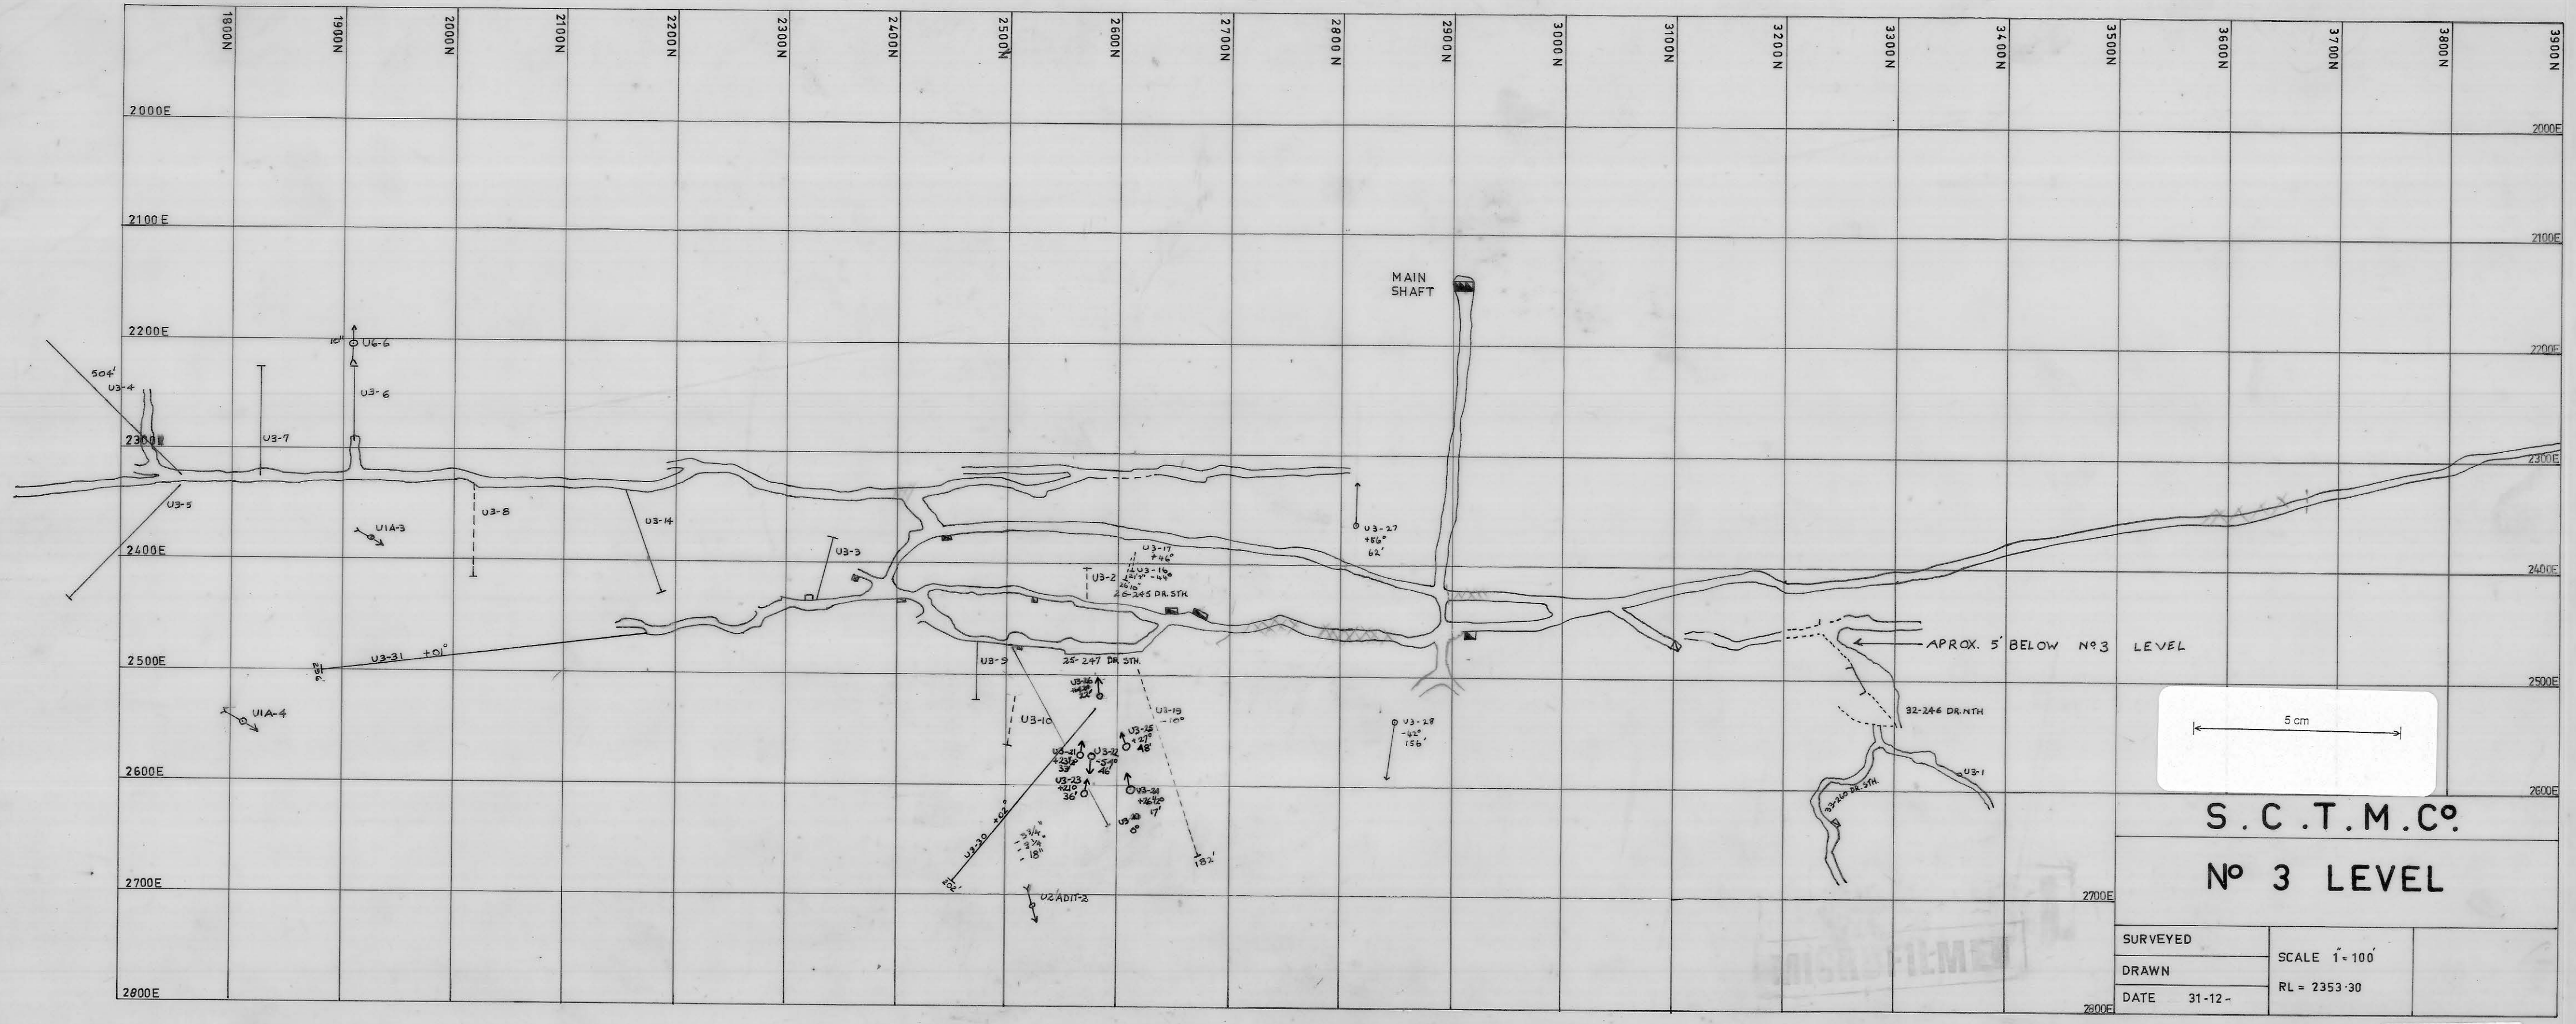

18ERF-668

82258