

ABERF-678




**MICROFILMED**

S. C. T. M. C. O.

Nº 6 LEVEL

SURVEYED	SCALE 1"=100'
DRAWN	
DATE 31-12-80	
RL = 2265.89	

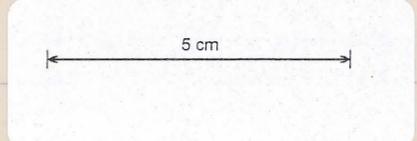

UP DATED AS AT 5-5-81

81009