


A B E R F - 6 8 5

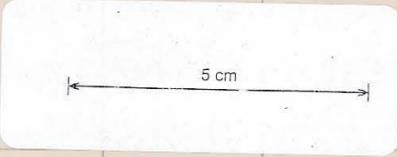

**MICROFILMED**  
S. C. T. M. Co. N. L.

N<sup>o</sup> 10A LEVEL

SURVEYED	SCALE: 1"=100'
DRAWN	R.L. 2060.87'
DATE 31-12-80	

UP DATED AS AT 5-5-81

81017