


ABERF-695

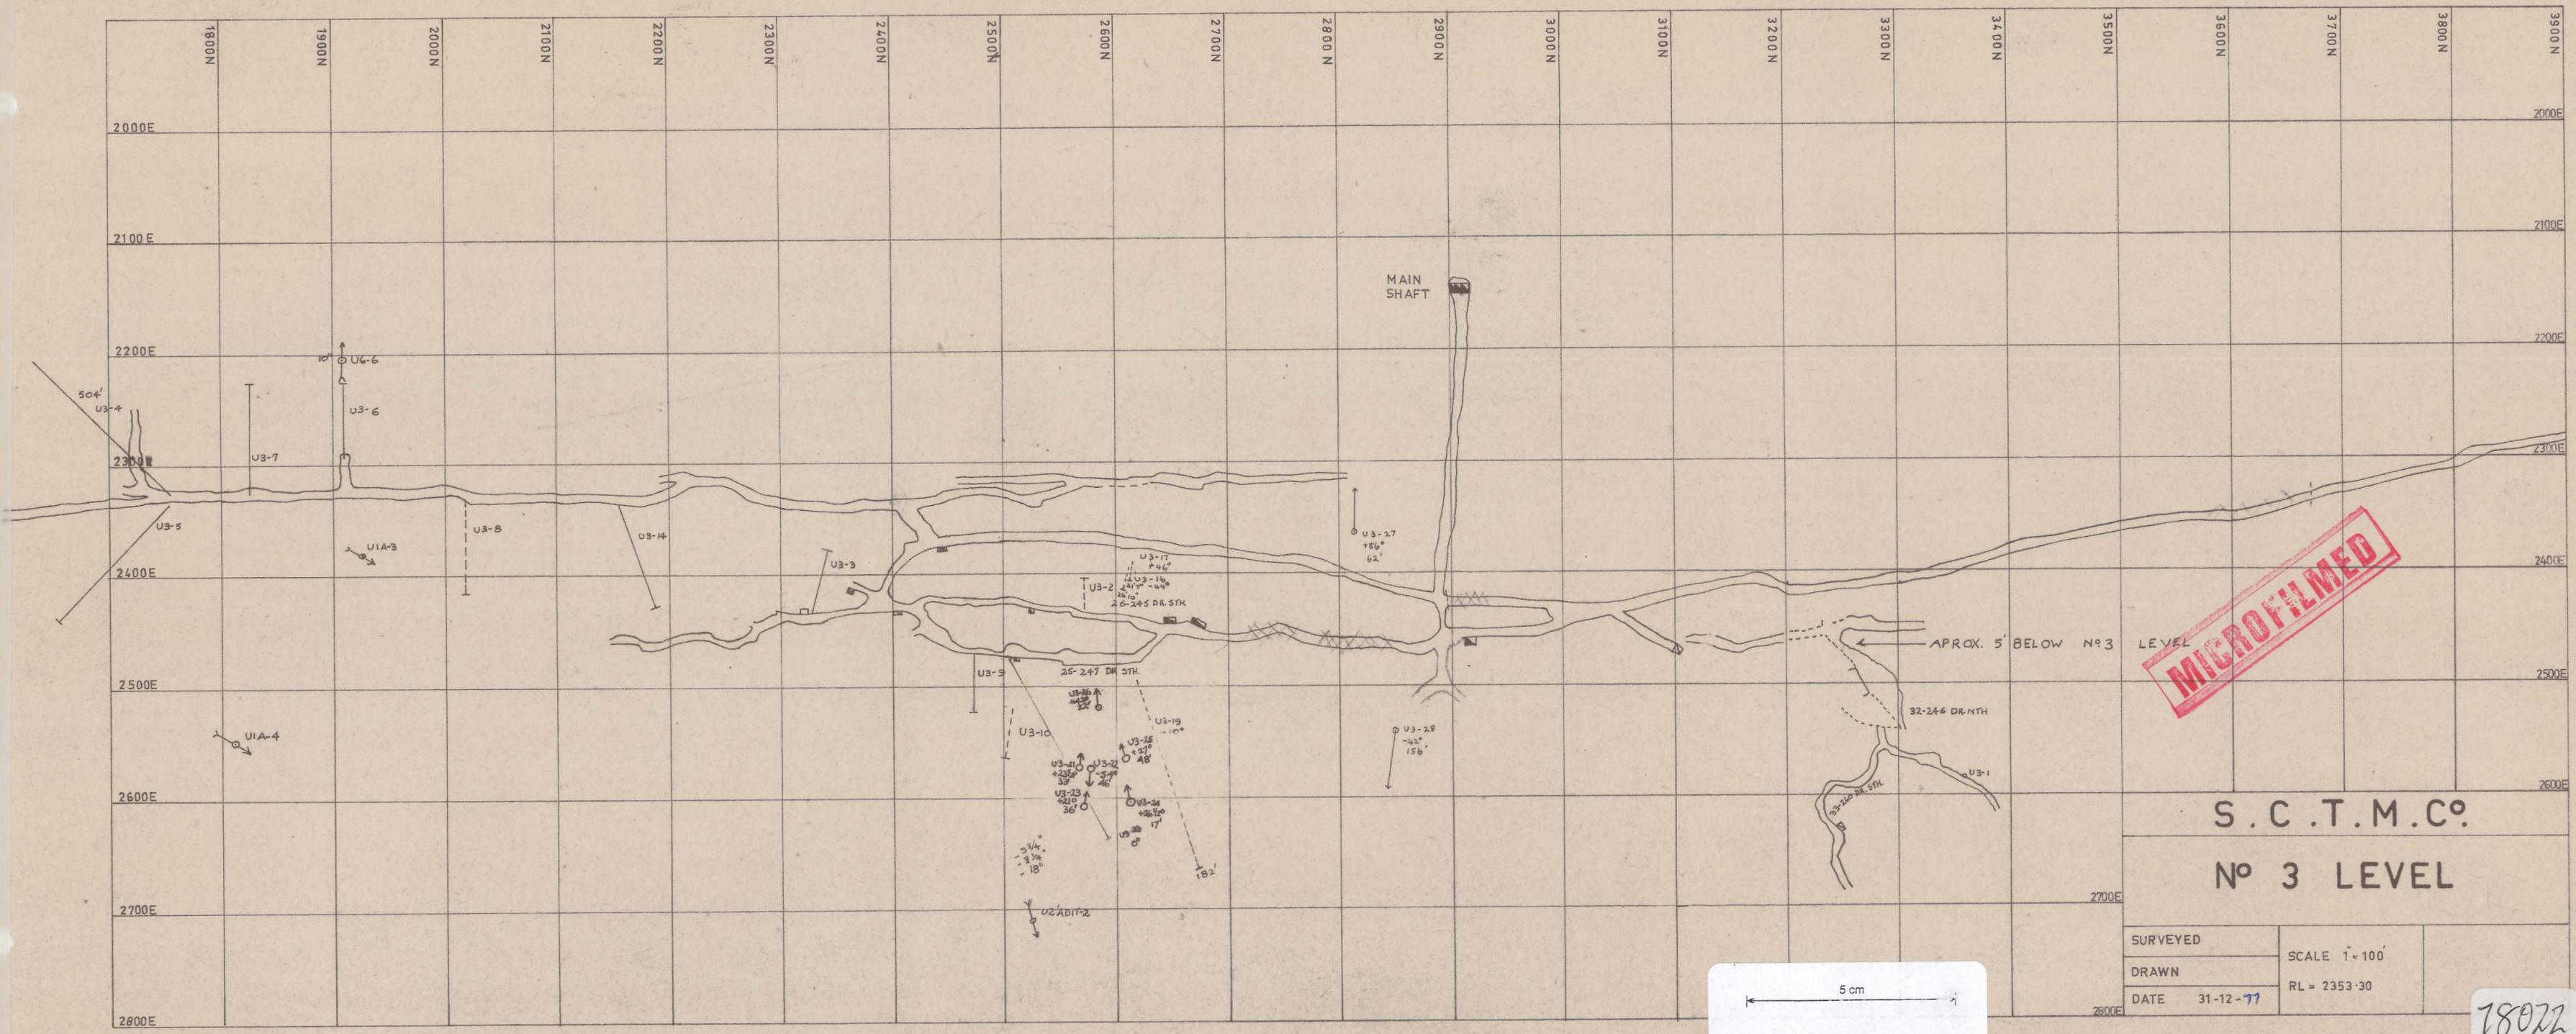

MICROFILMED

5 cm

78022