


ABERF-698

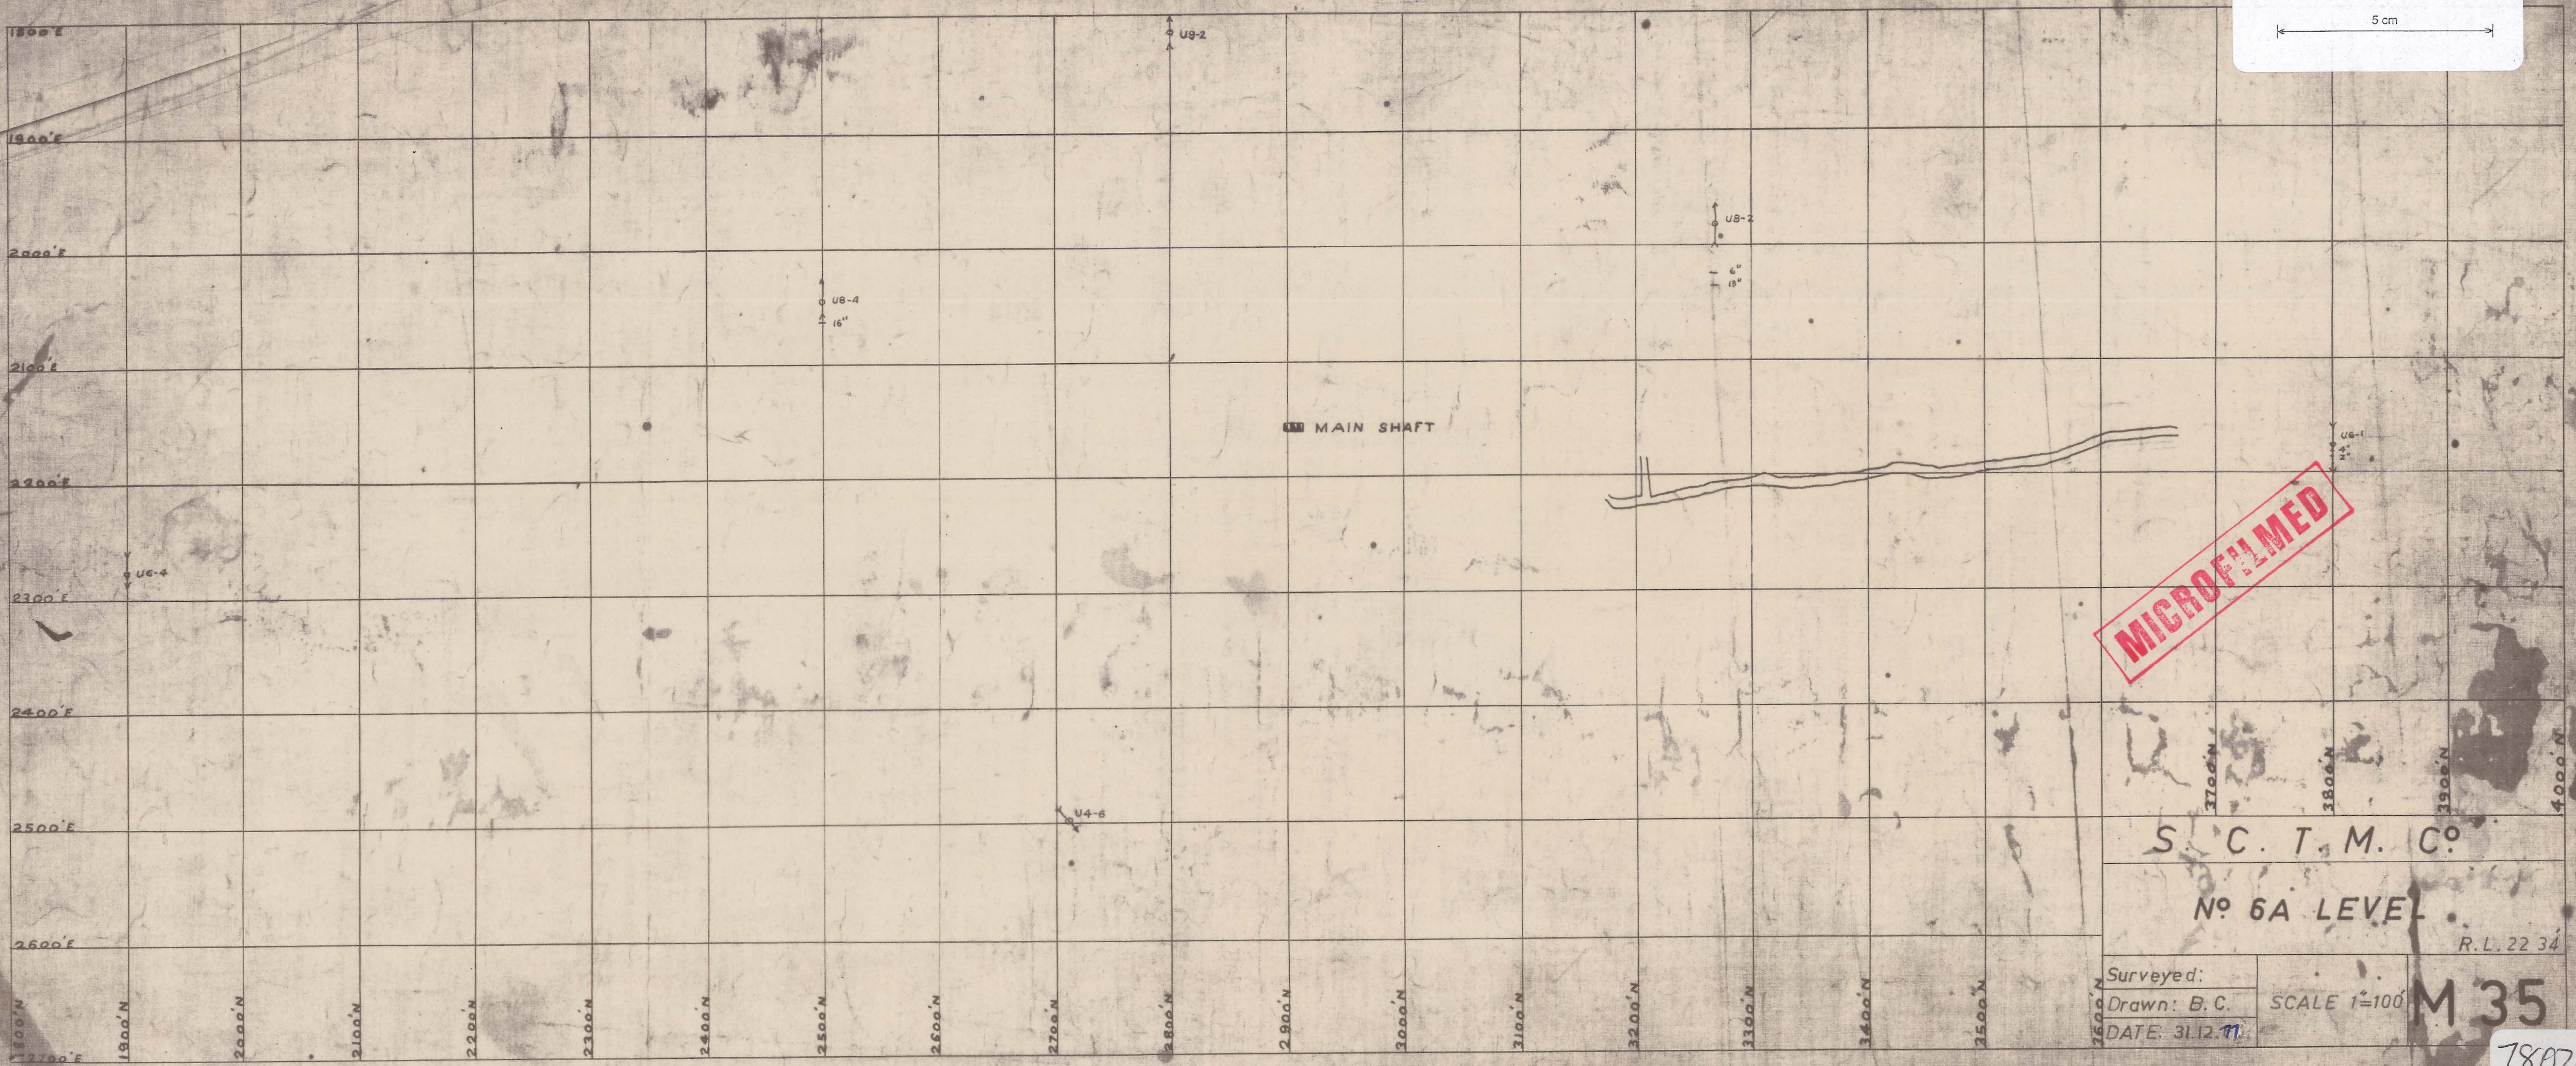

MICROFILMED

|                            |               |      |
|----------------------------|---------------|------|
| S. C. T. M. C <sup>o</sup> |               |      |
| N <sup>o</sup> 6A LEVEL    |               |      |
| R.L. 22 34                 |               |      |
| Surveyed:                  | SCALE 1"=100' | M 35 |
| Drawn: B. C.               |               |      |
| DATE: 31.12.11             |               |      |

78026