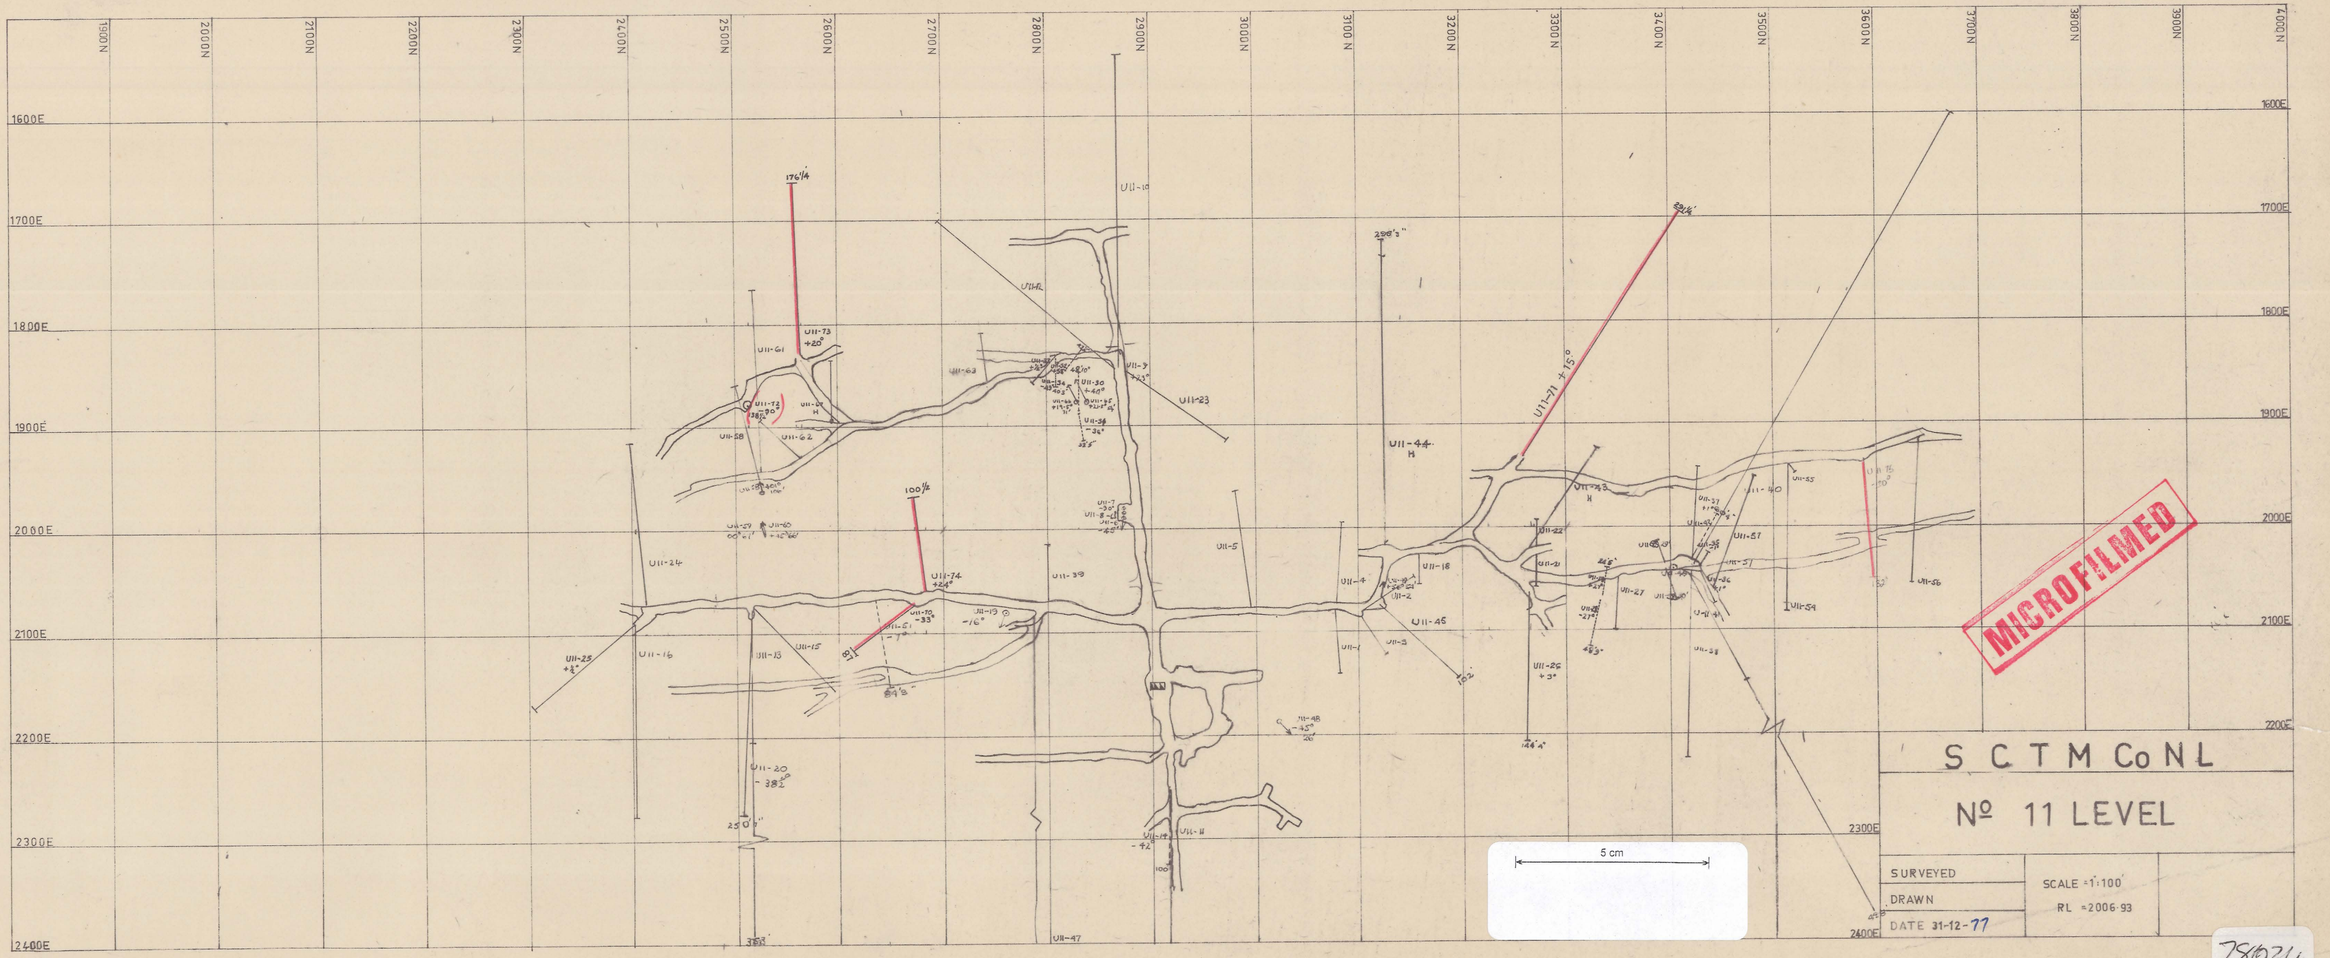

MICROFILMED

ABERF-707

78034