ABERF - 210

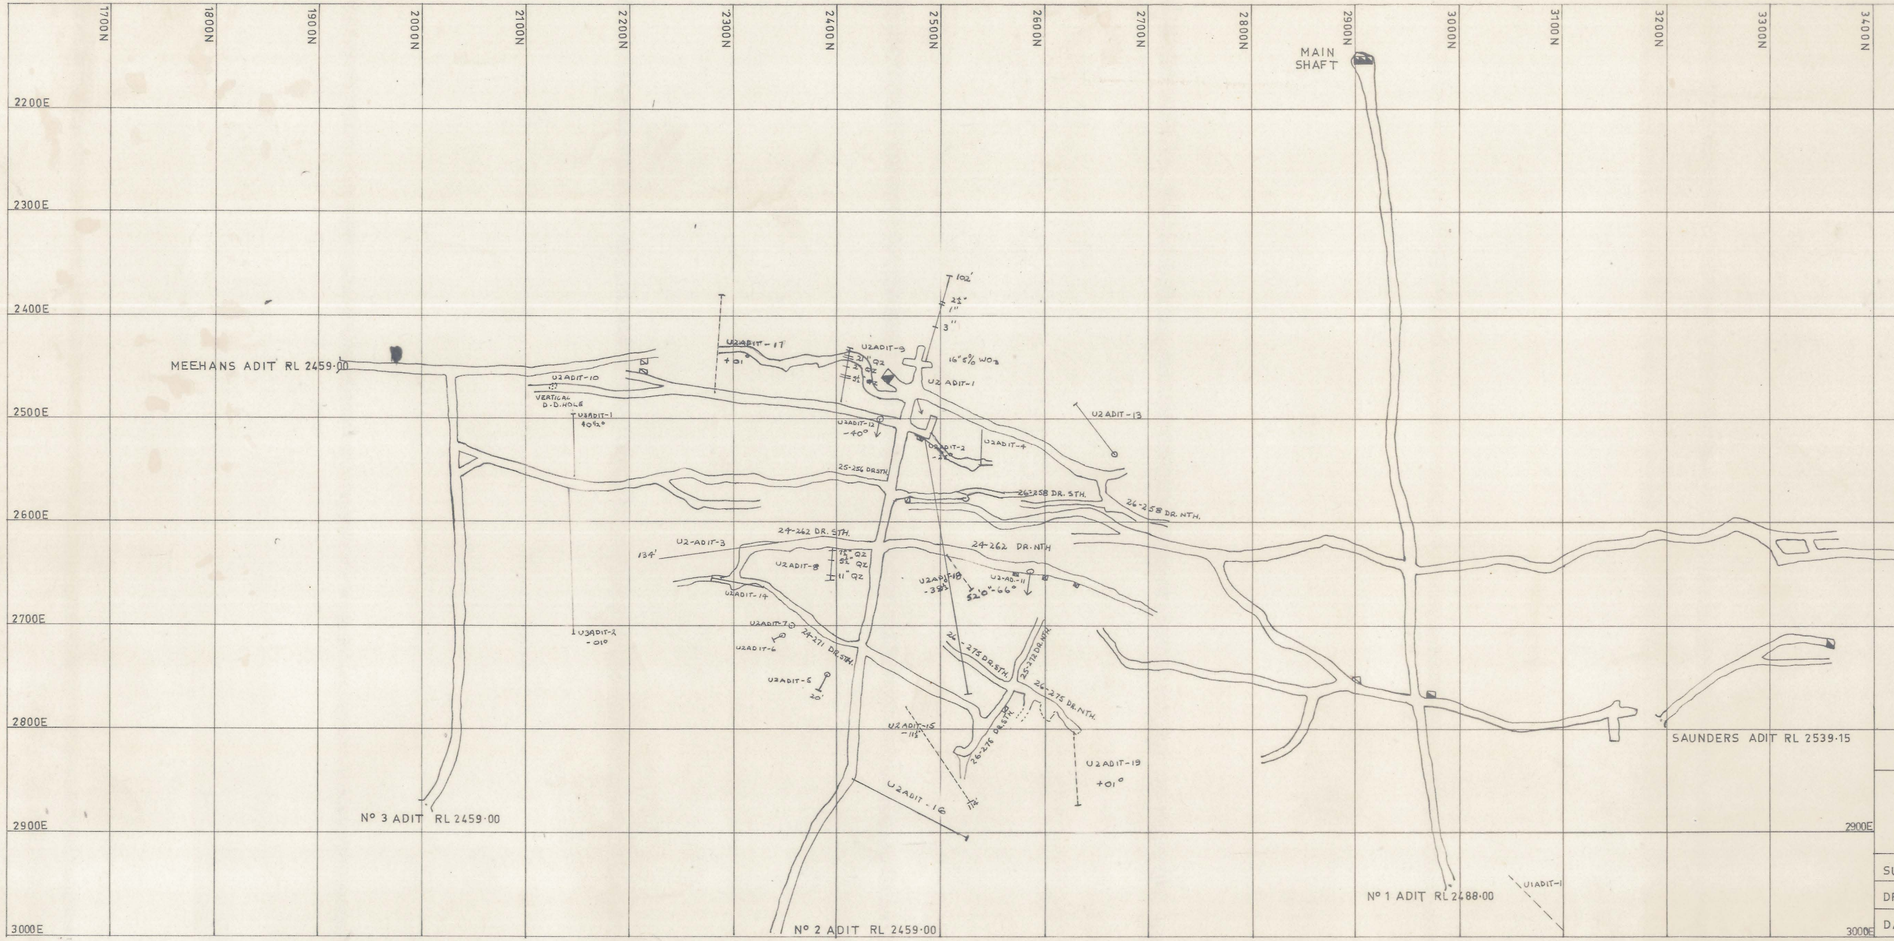

MICROFILMED

S.C.T.M.Co.

N° 1.2.&3 ADITS

SURVEYED	SCALE 1"=100'	73041
DRAWN	RL	
DATE 31-12-72		