



ABERF_729

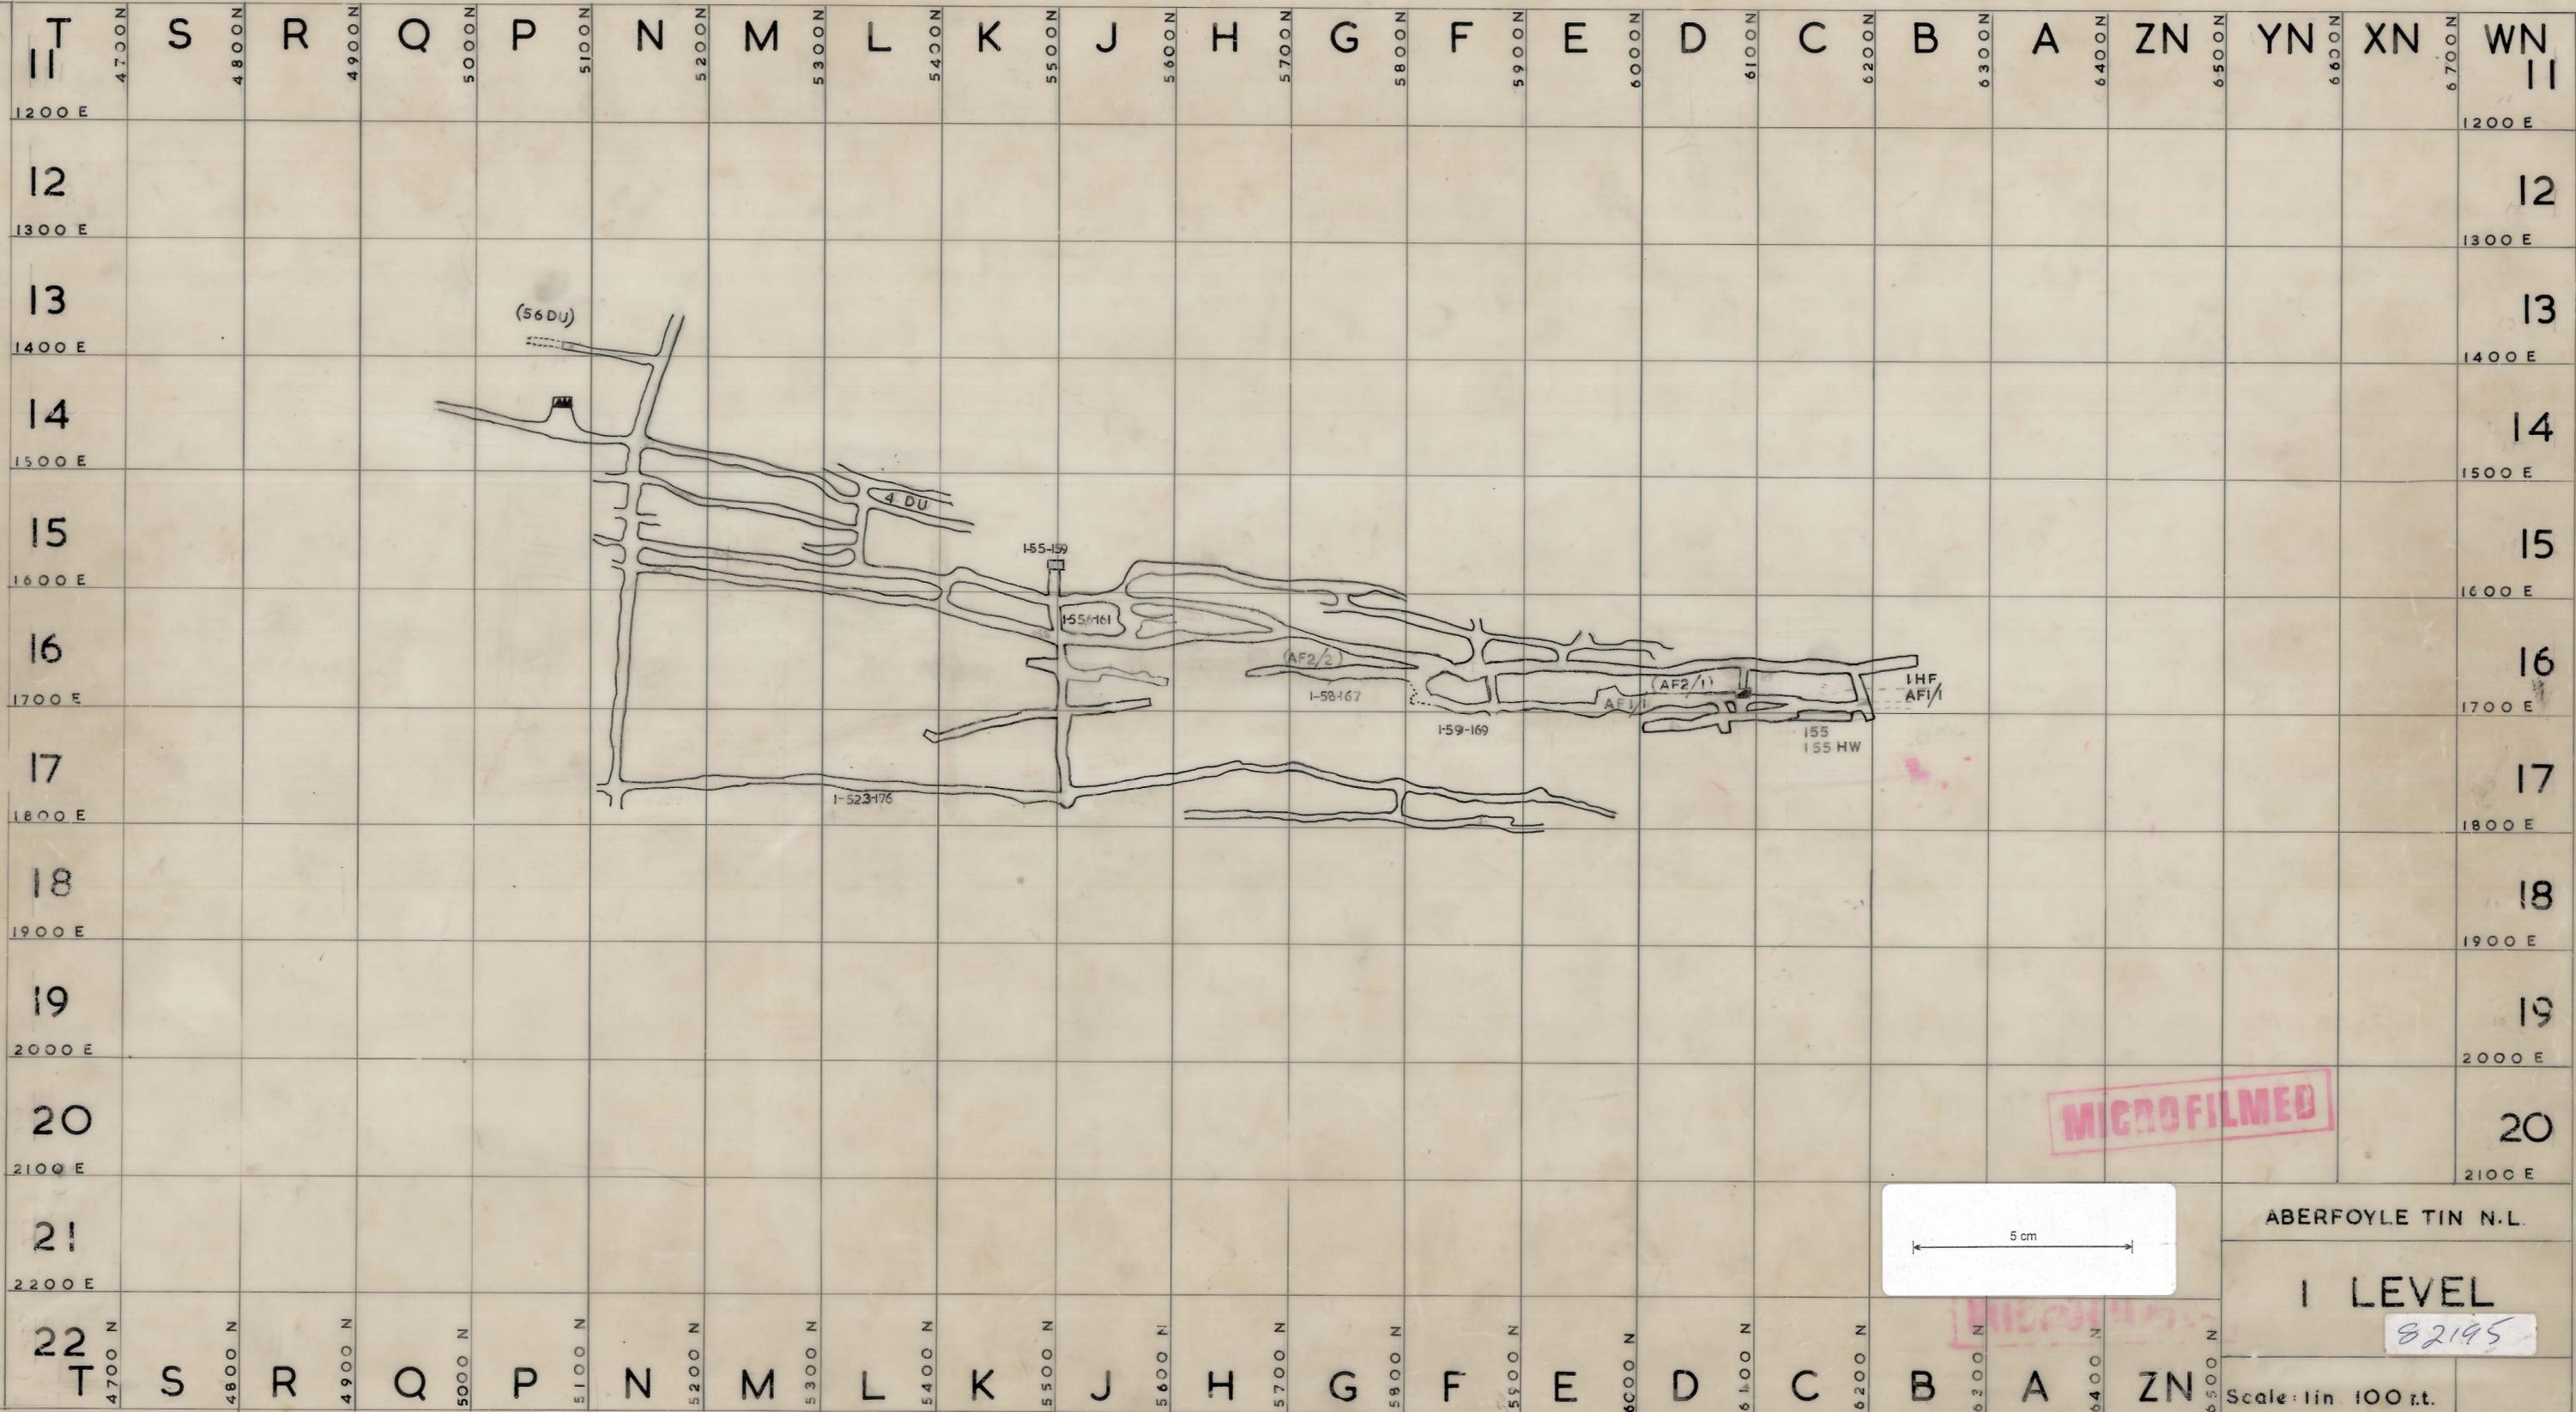

MICROFILMED

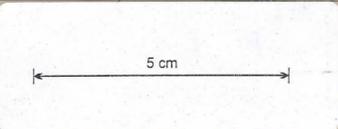

ABERFOYLE TIN N.L.

I LEVEL

82195

Scale: 1 in. = 100 ft.