
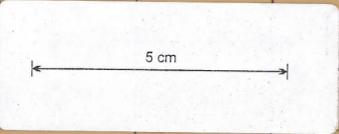


ABERF_730

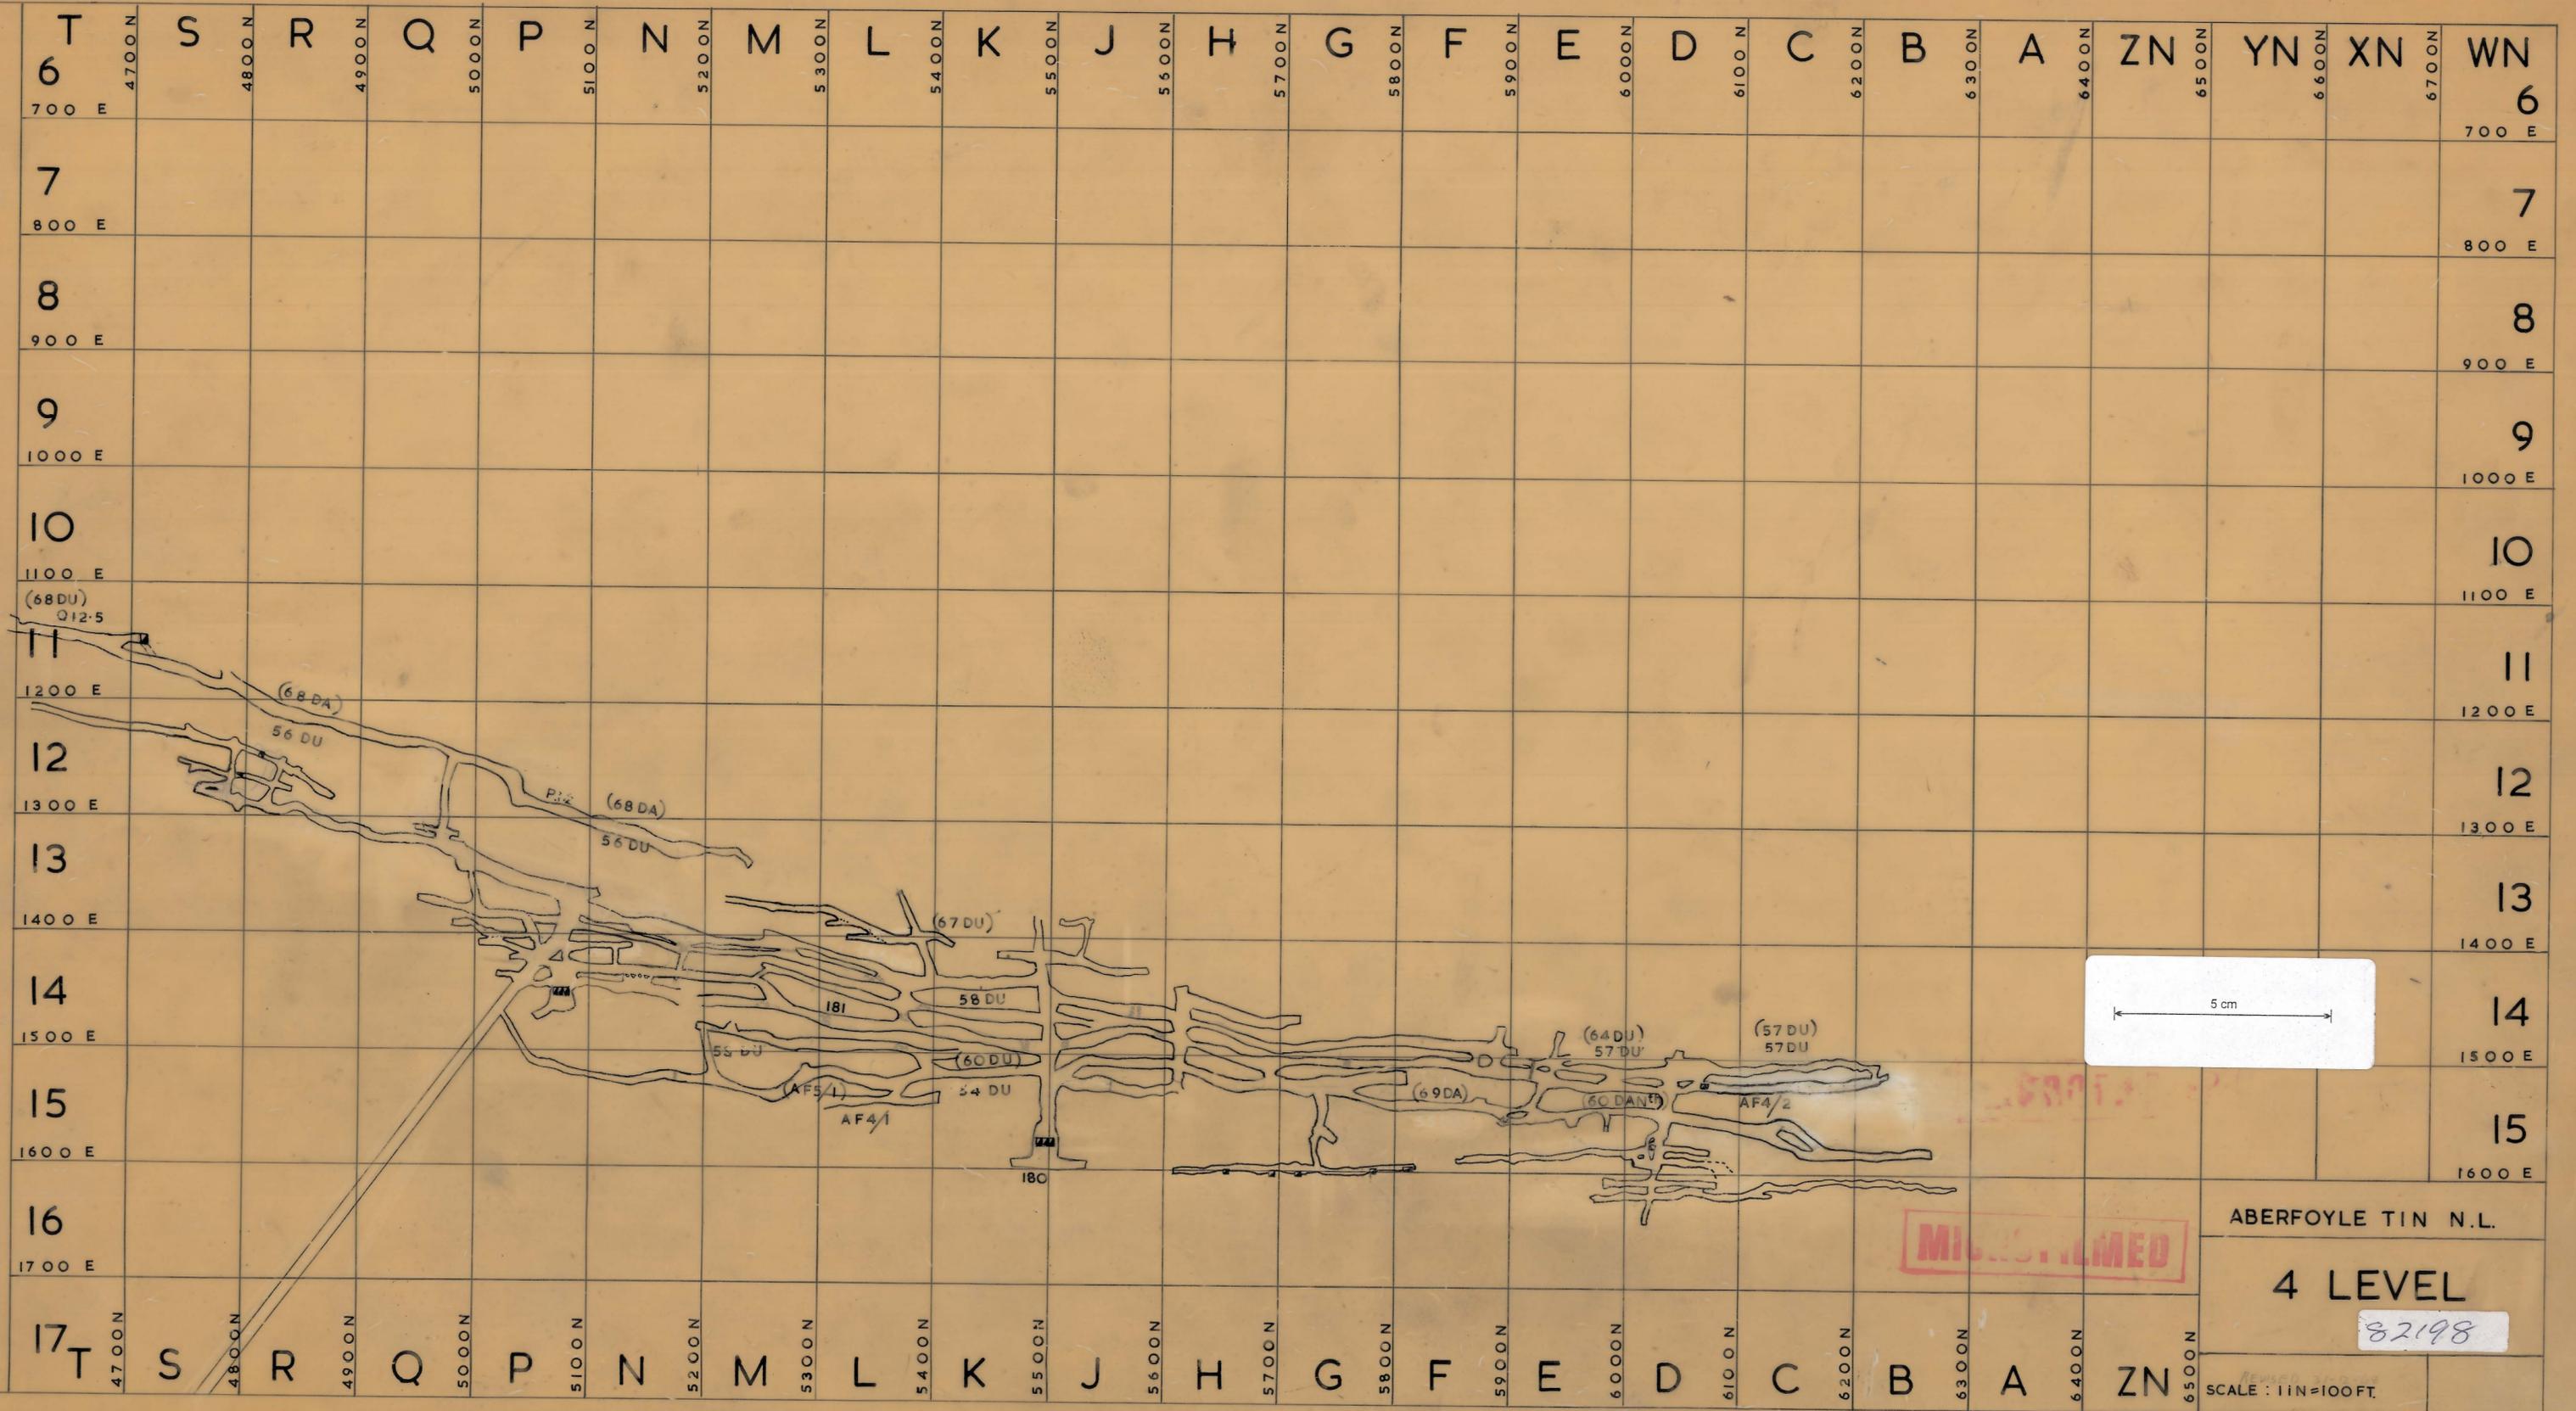

MICROFILMED

ABERFOYLE TIN N.L.

4 LEVEL

82198

SCALE: 1 IN = 100 FT.