


ABERF_731

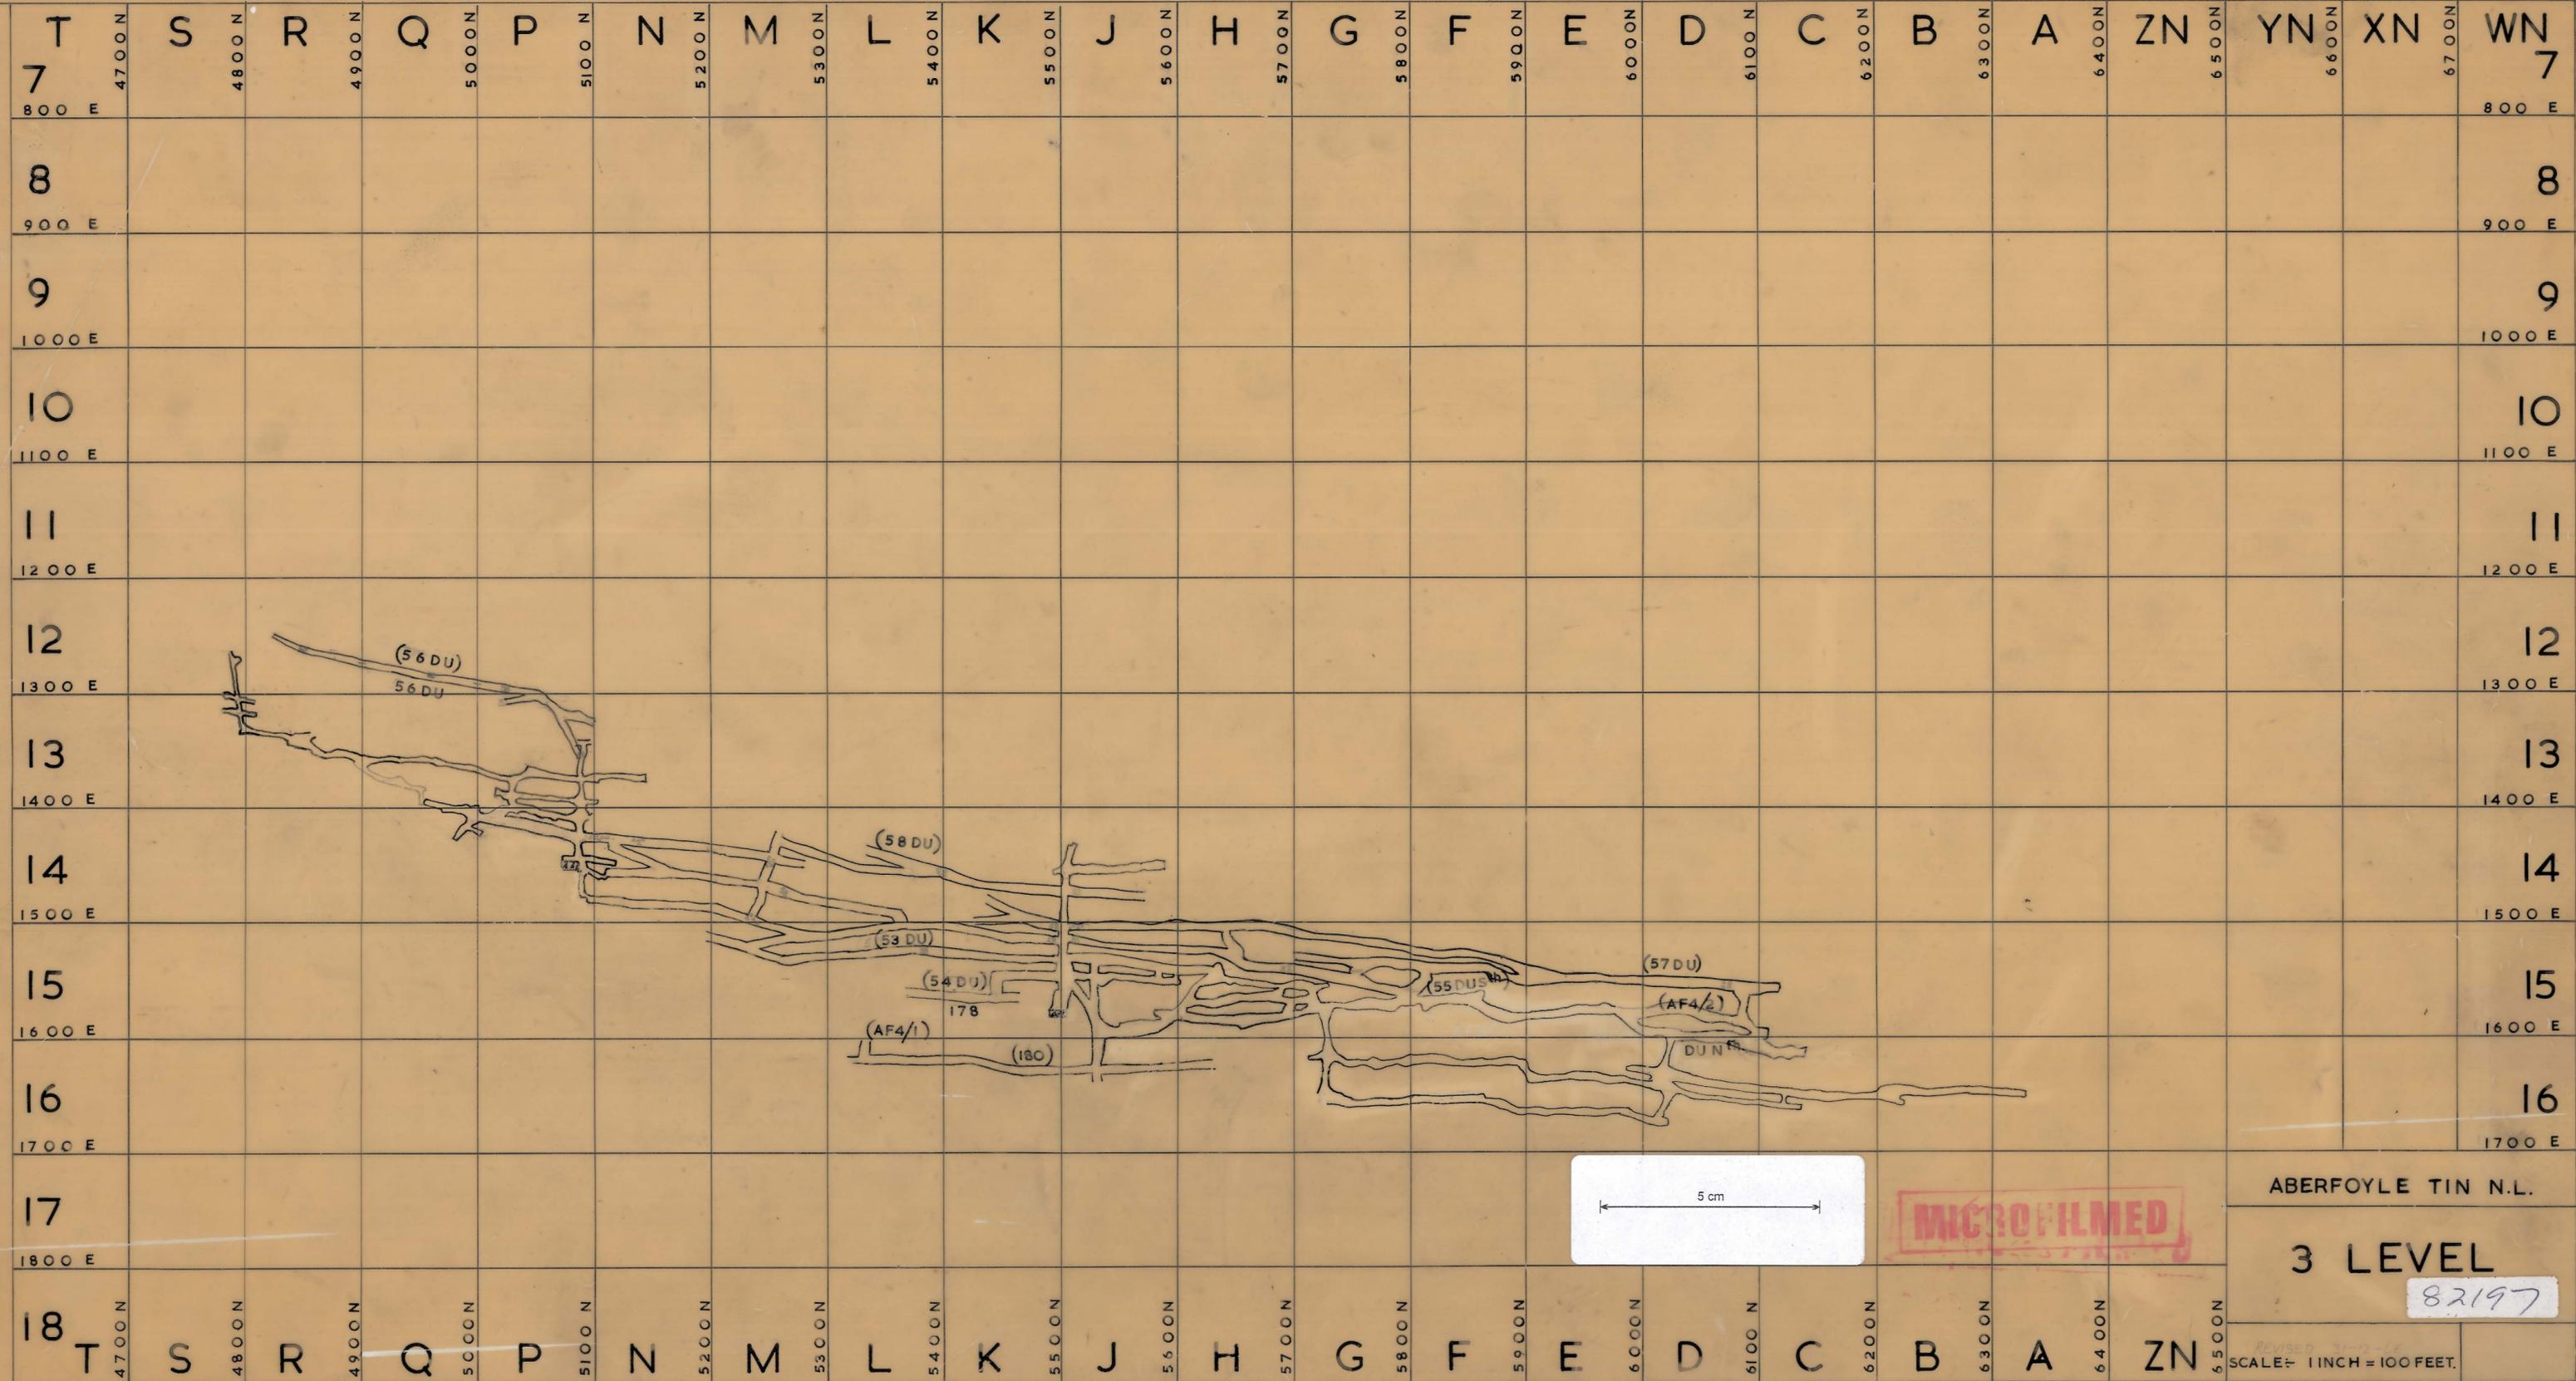

ABERFOYLE TIN N.L.

3 LEVEL

82197

SCALE: 1 INCH = 100 FEET.