


ABERF_734

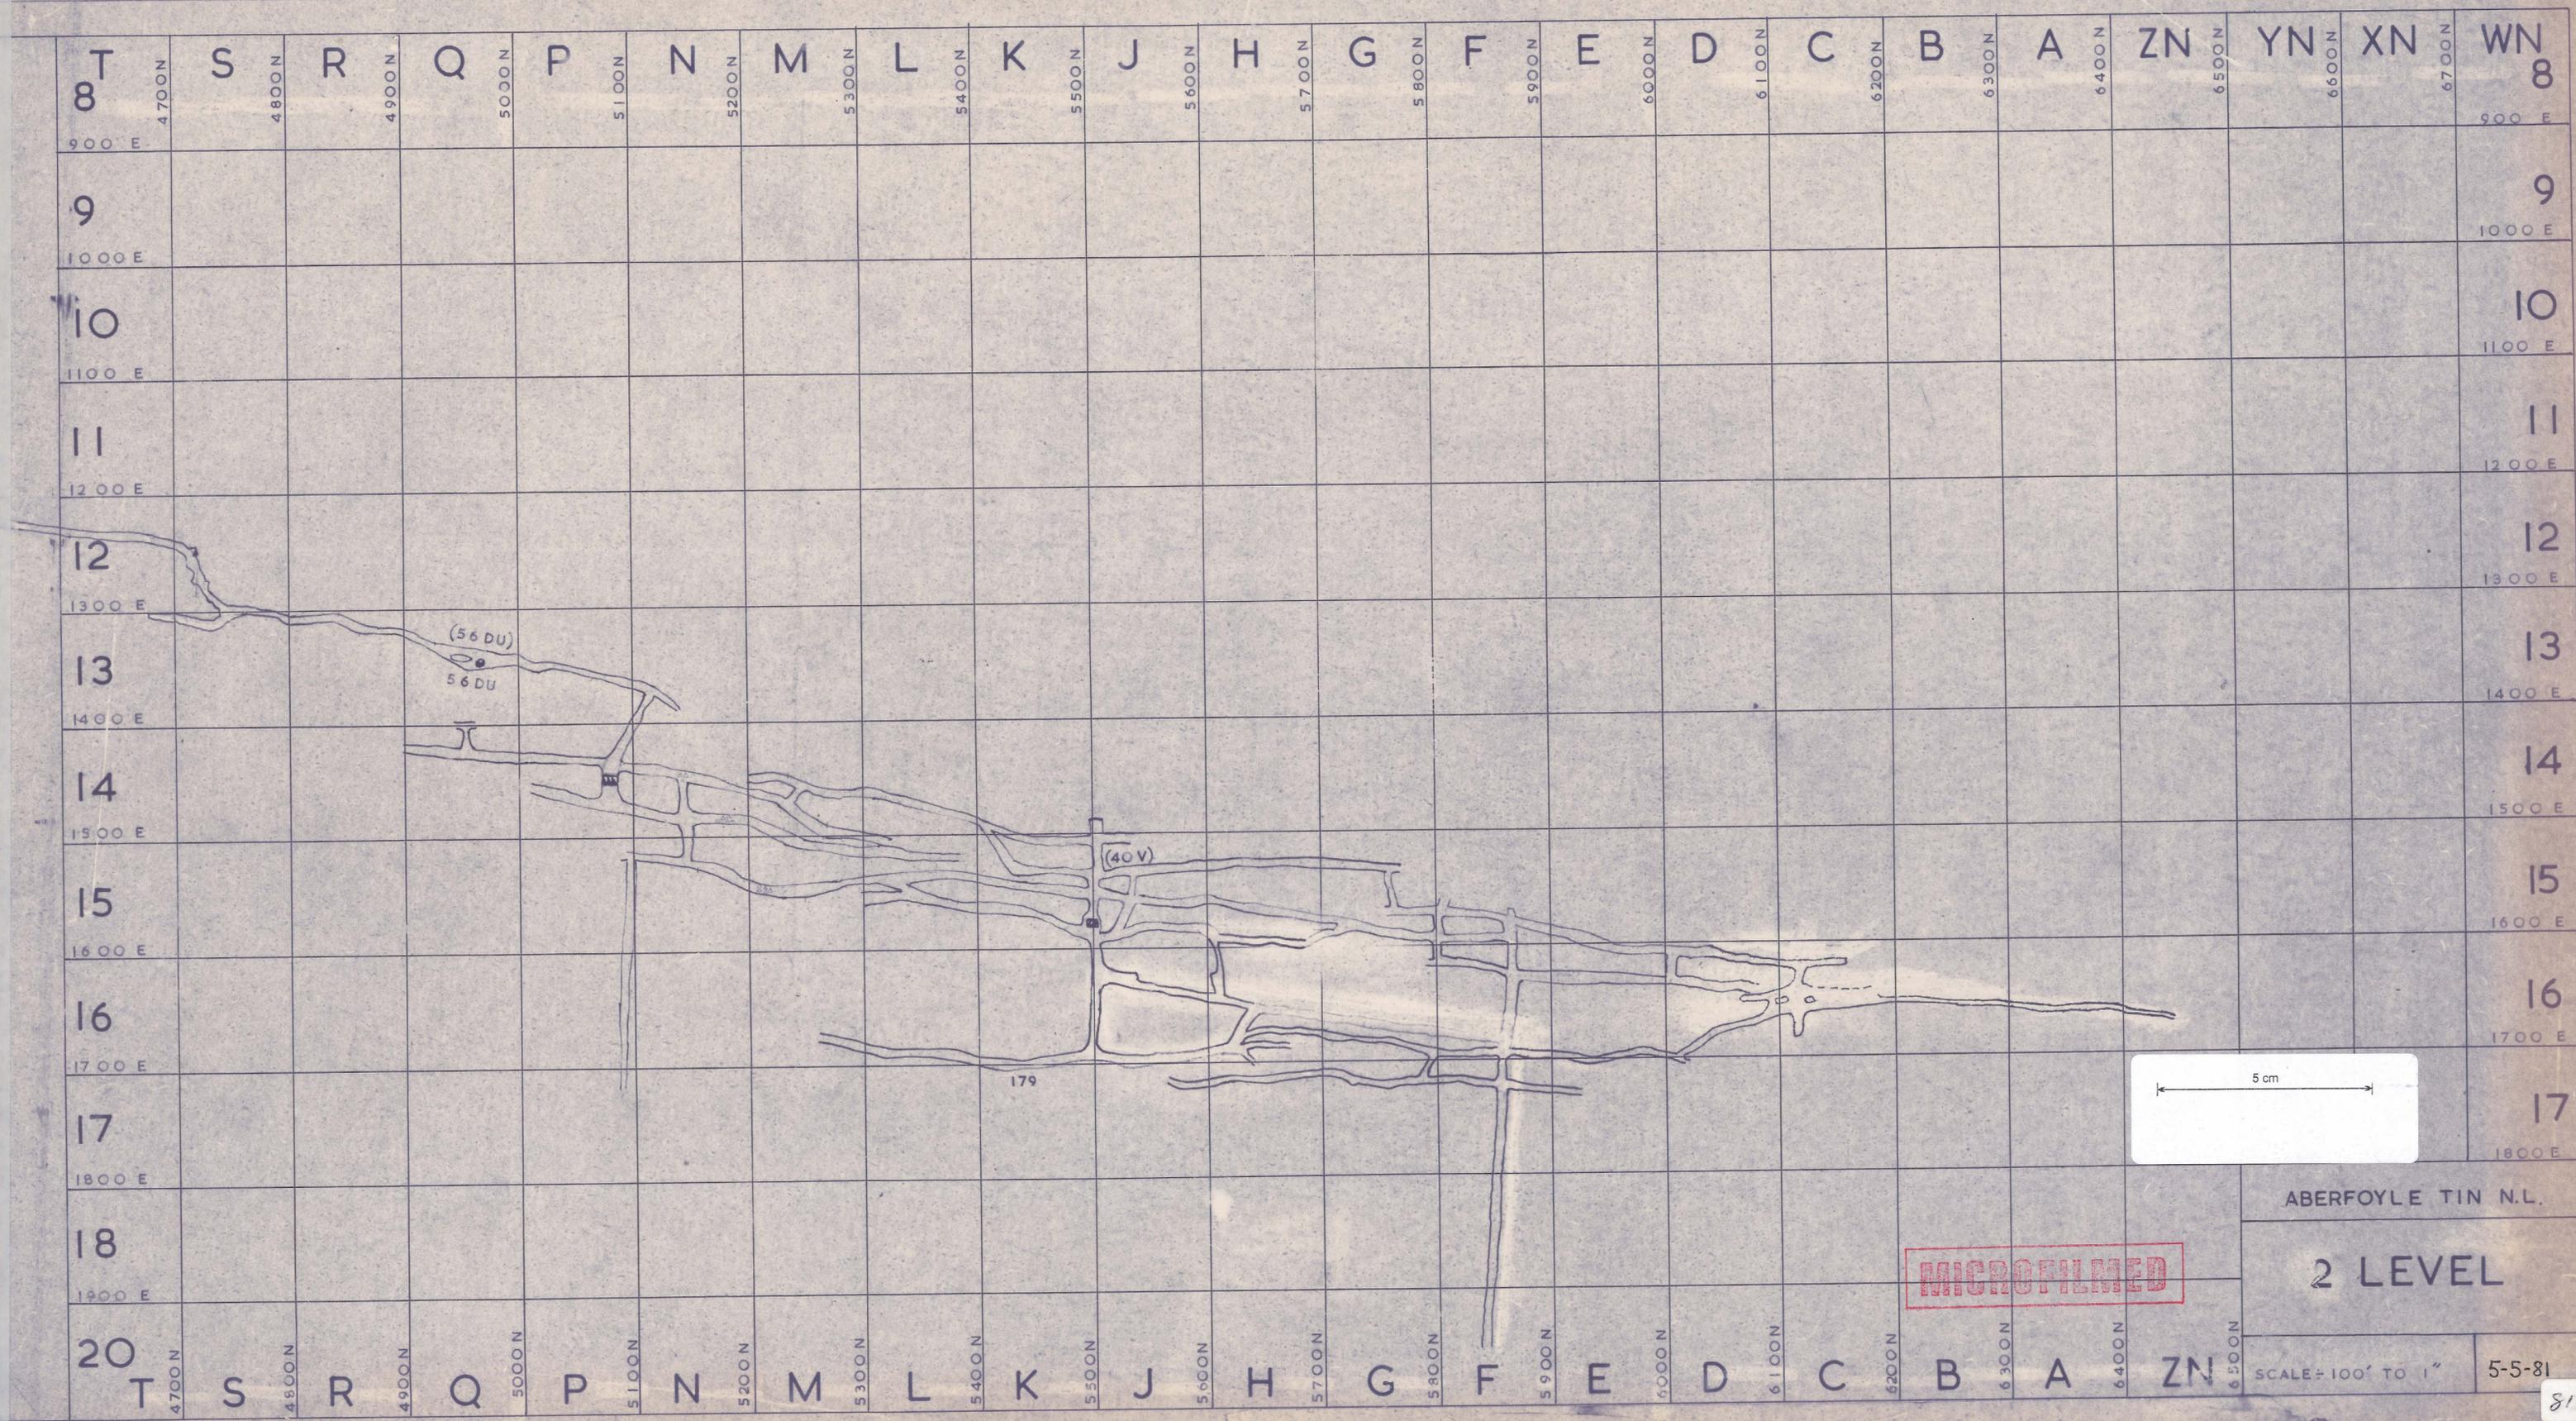

ABERFOYLE TIN N.L.

2 LEVEL

MICROFILMED

SCALE = 100' TO 1"

5-5-81

81021