


ABERF_735

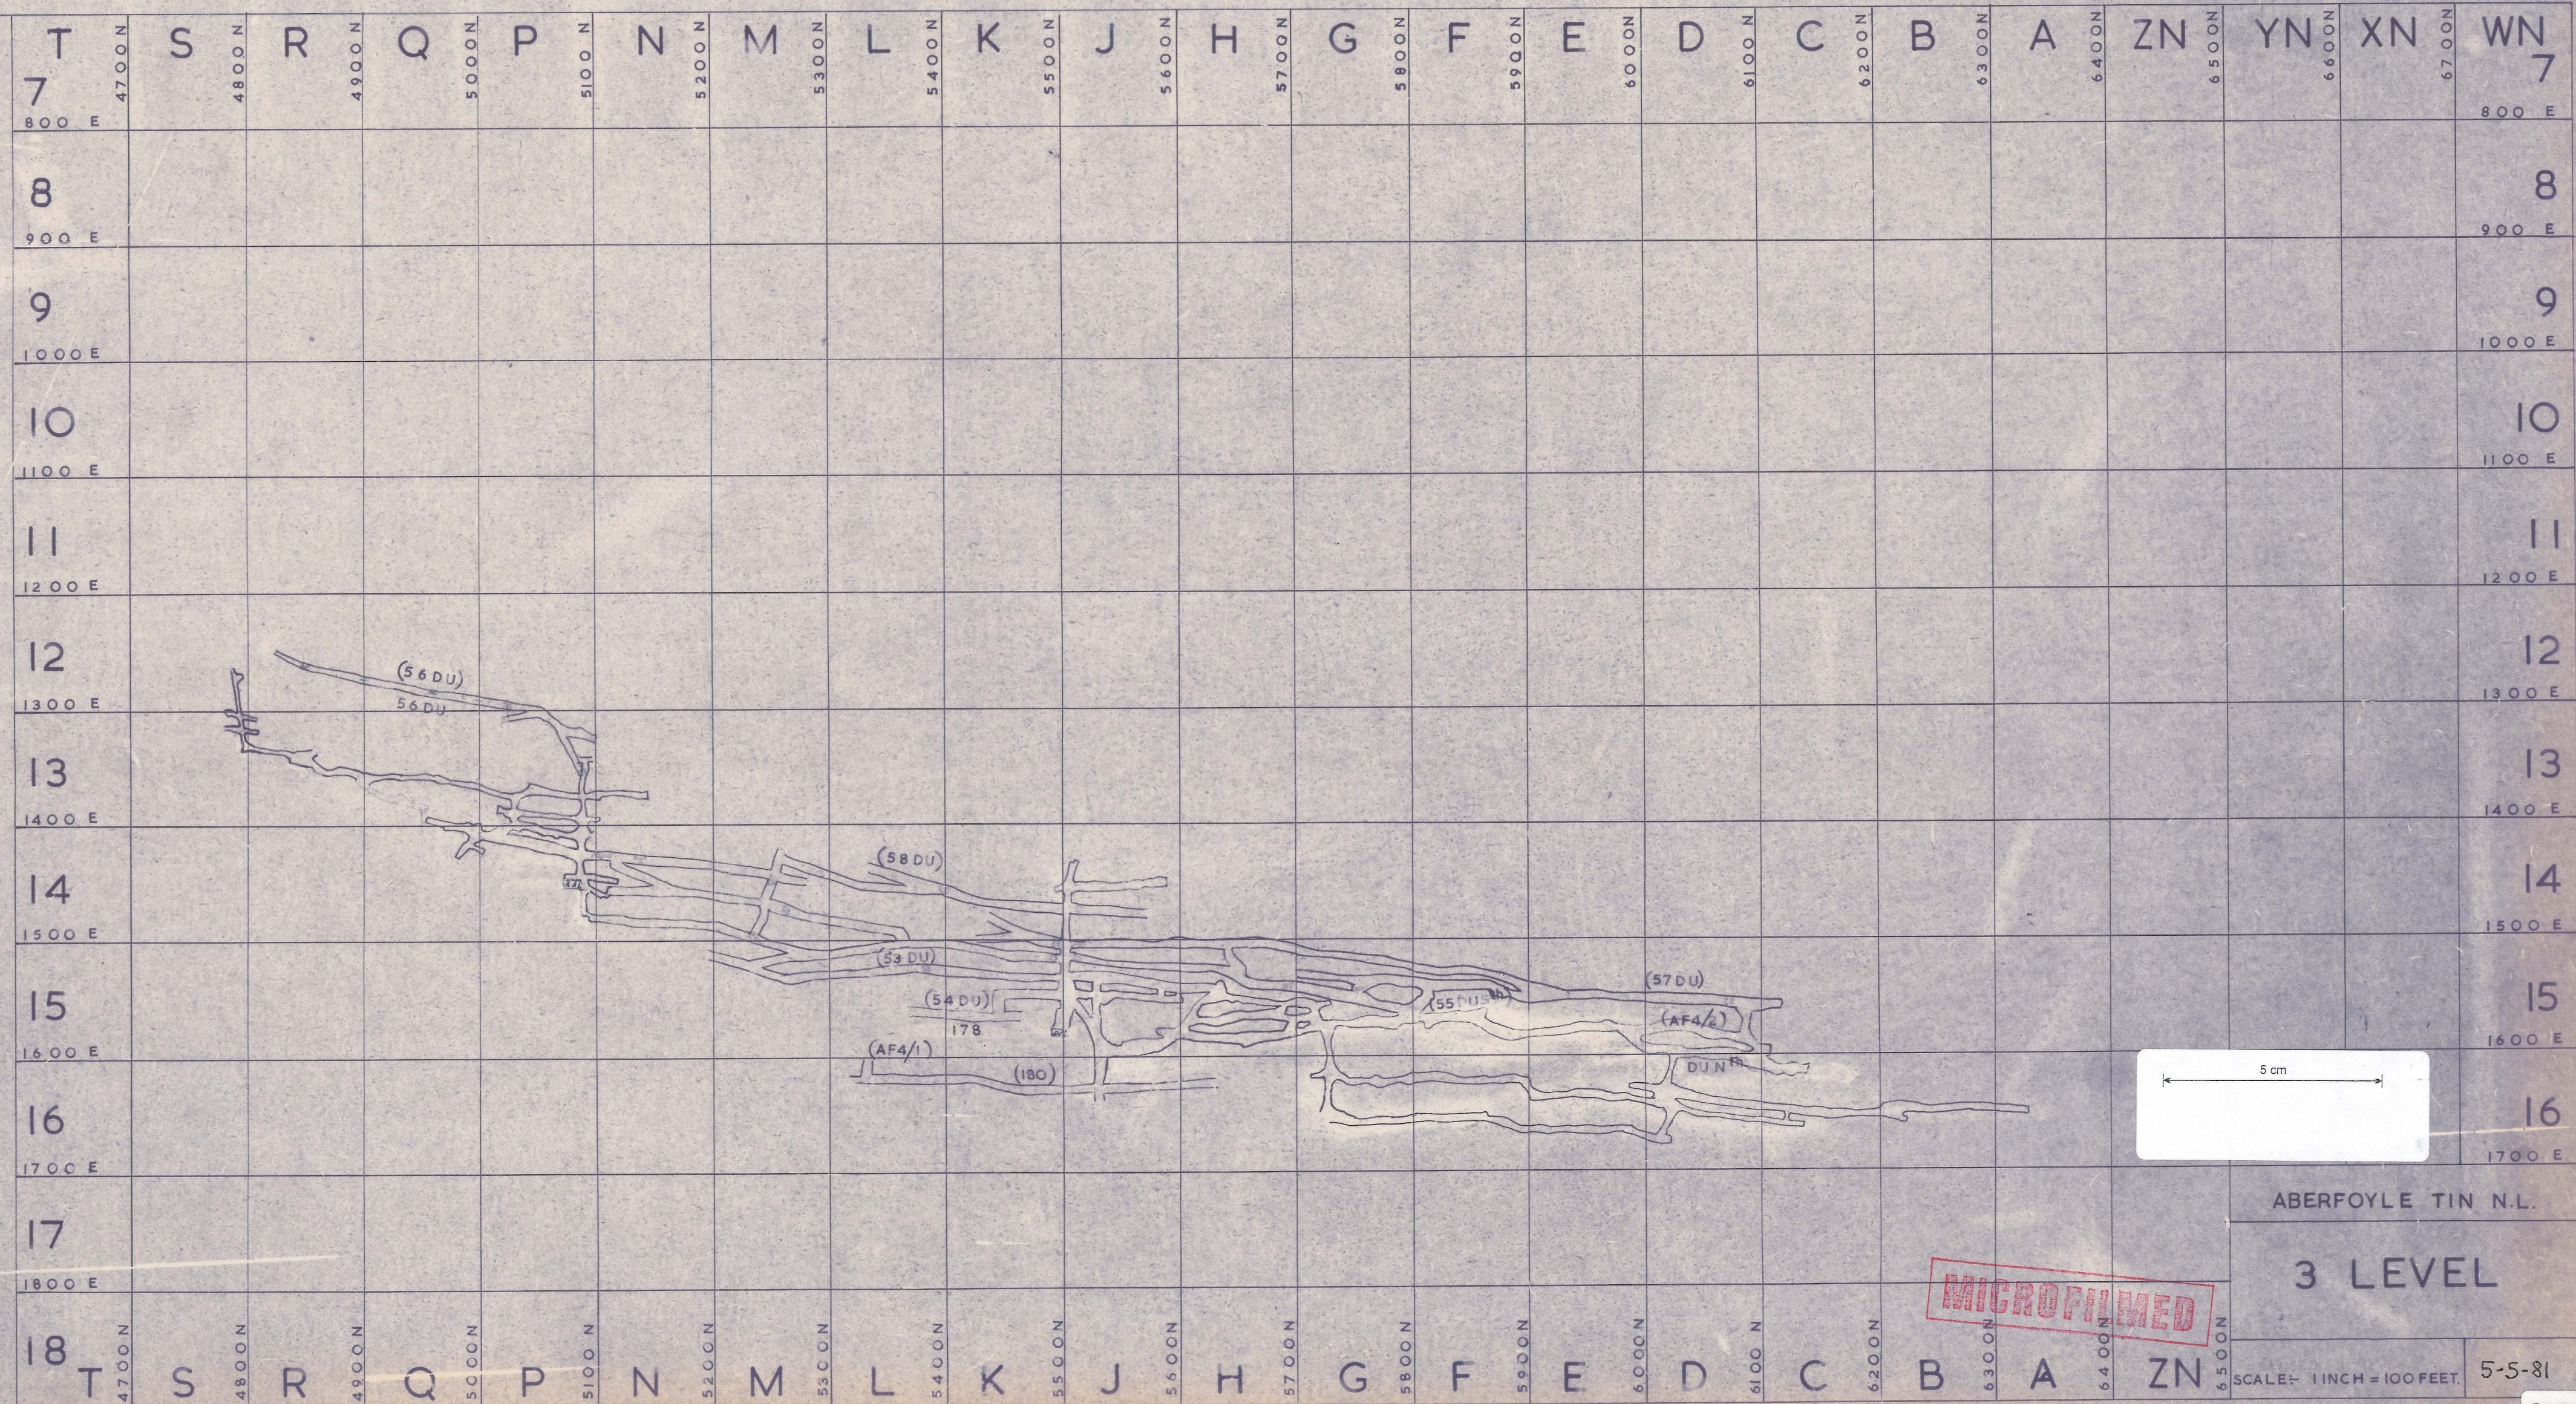

ABERFOYLE TIN N.L.

3 LEVEL

SCALE: 1 INCH = 100 FEET.

5-5-81

81022