


ABERF_736

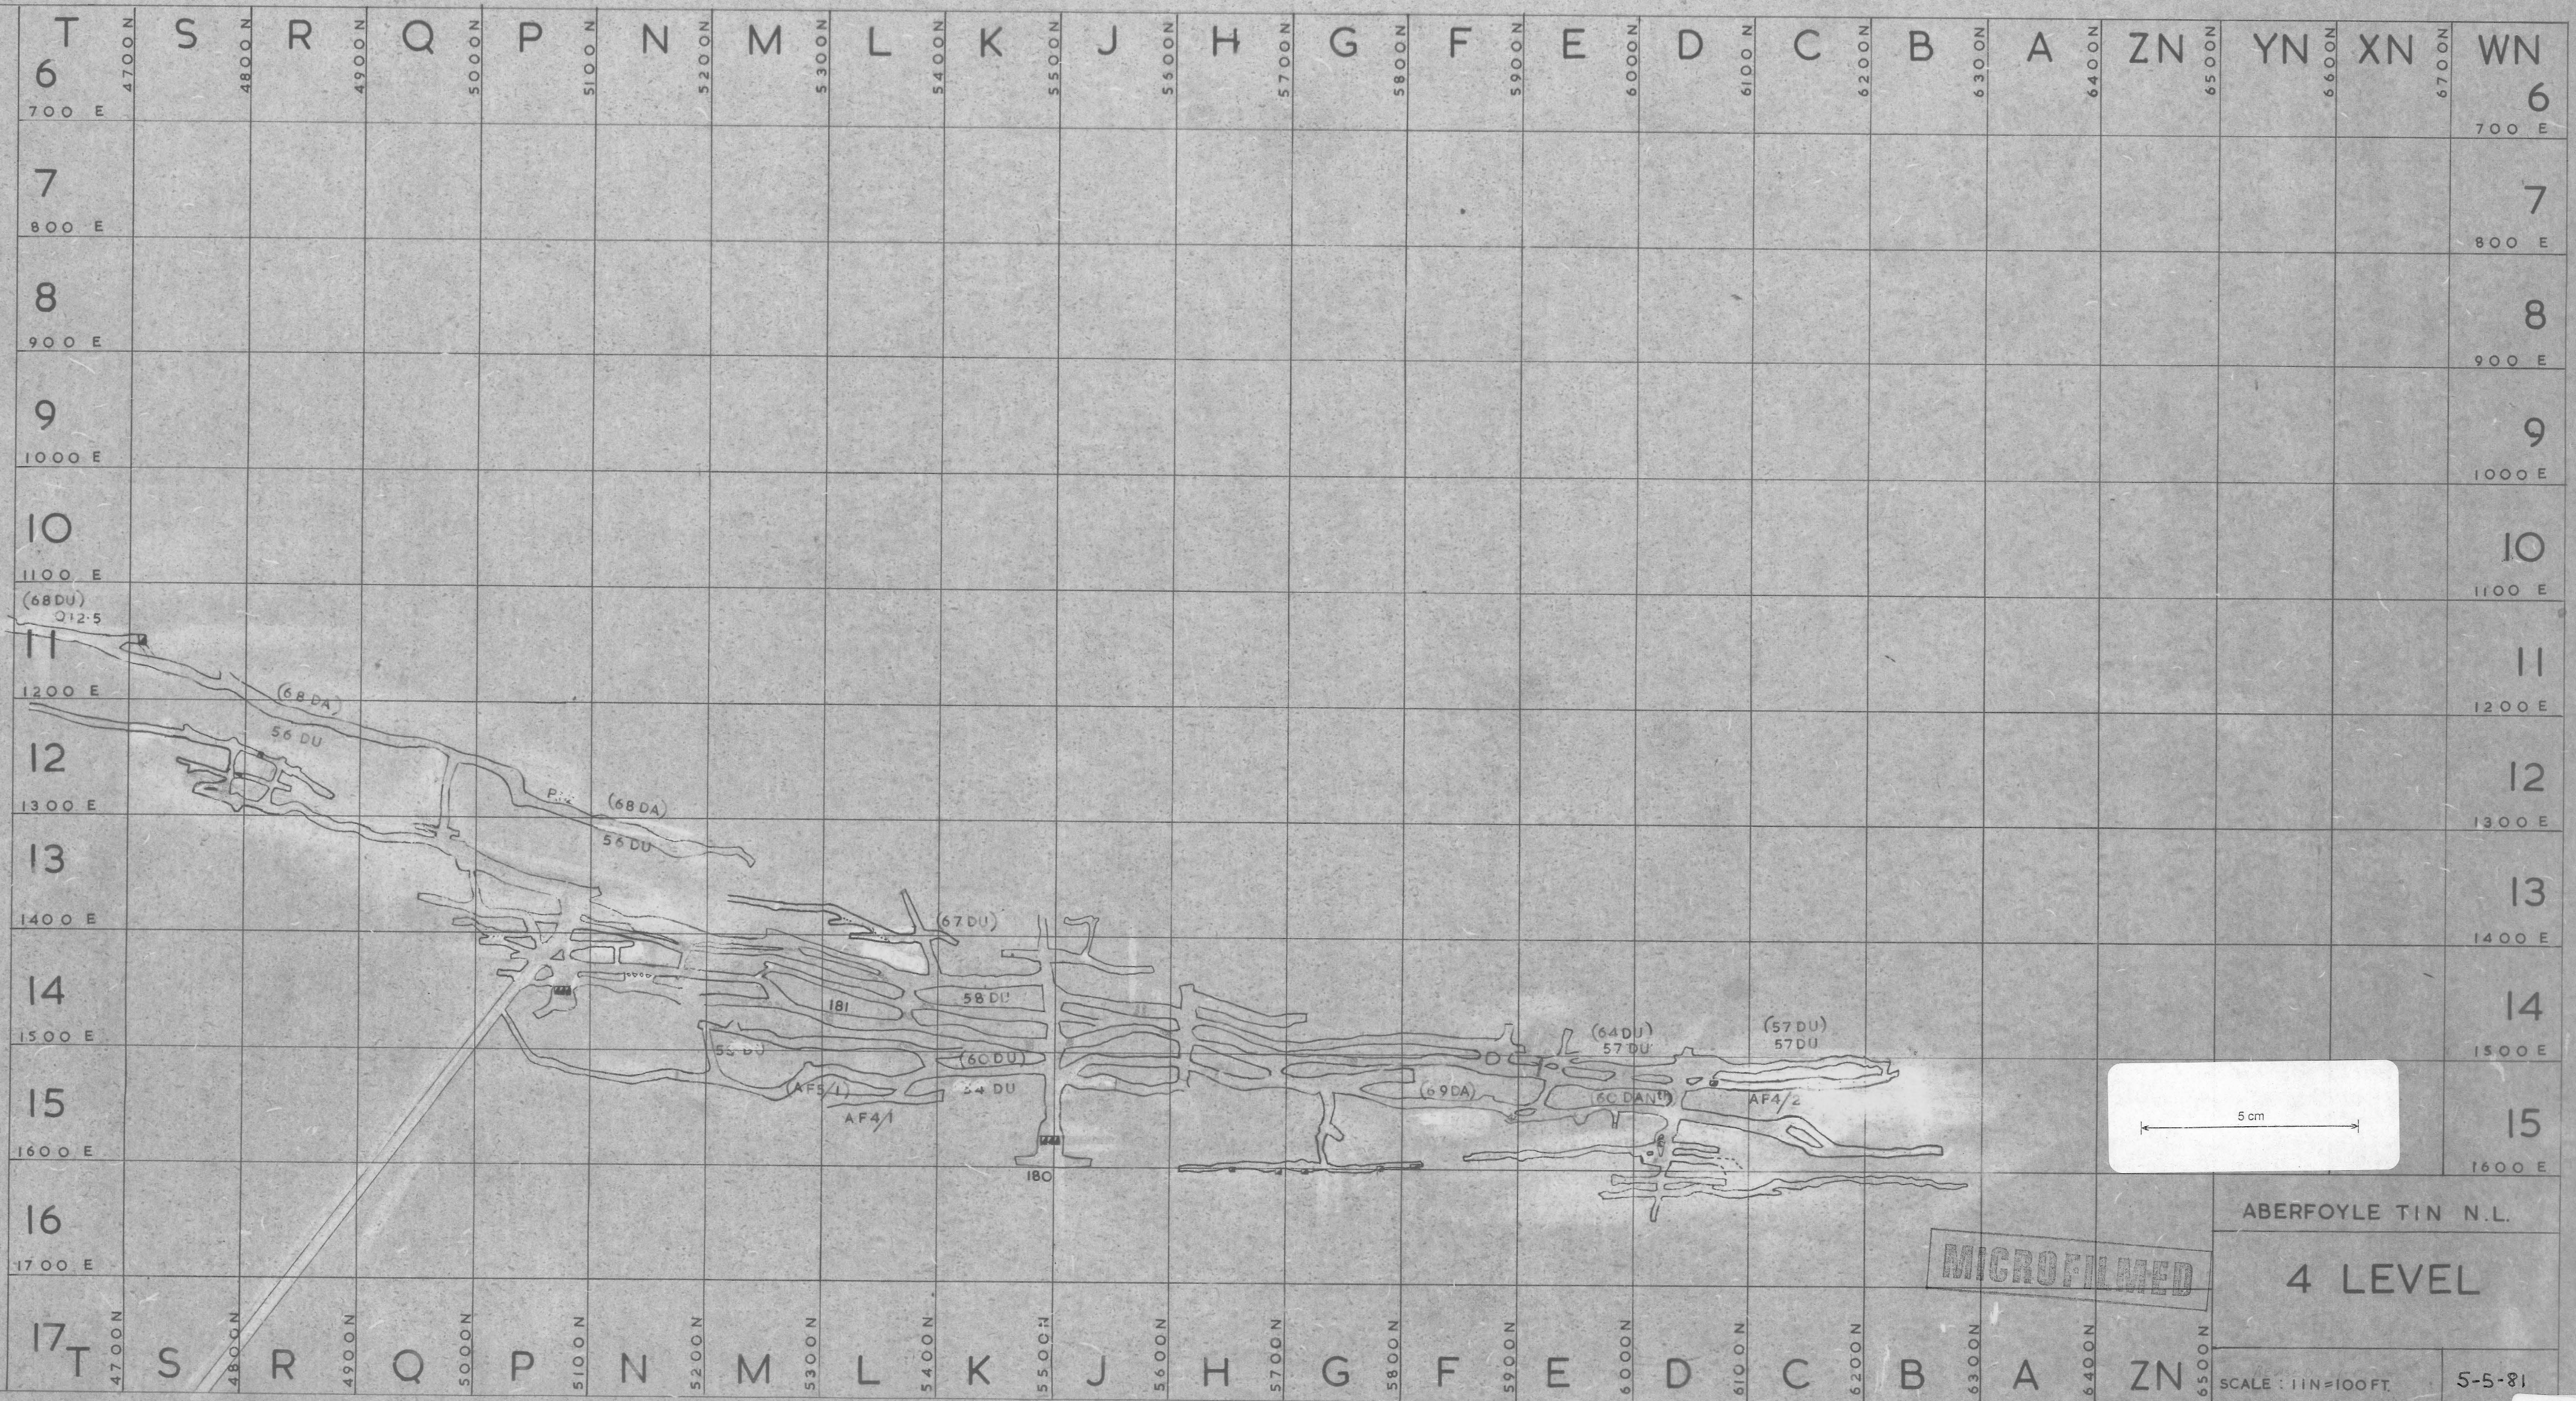

5 cm

MICROFILMED

ABERFOYLE TIN N.L.

4 LEVEL

SCALE: 1 IN = 100 FT.

5-5-81

81023