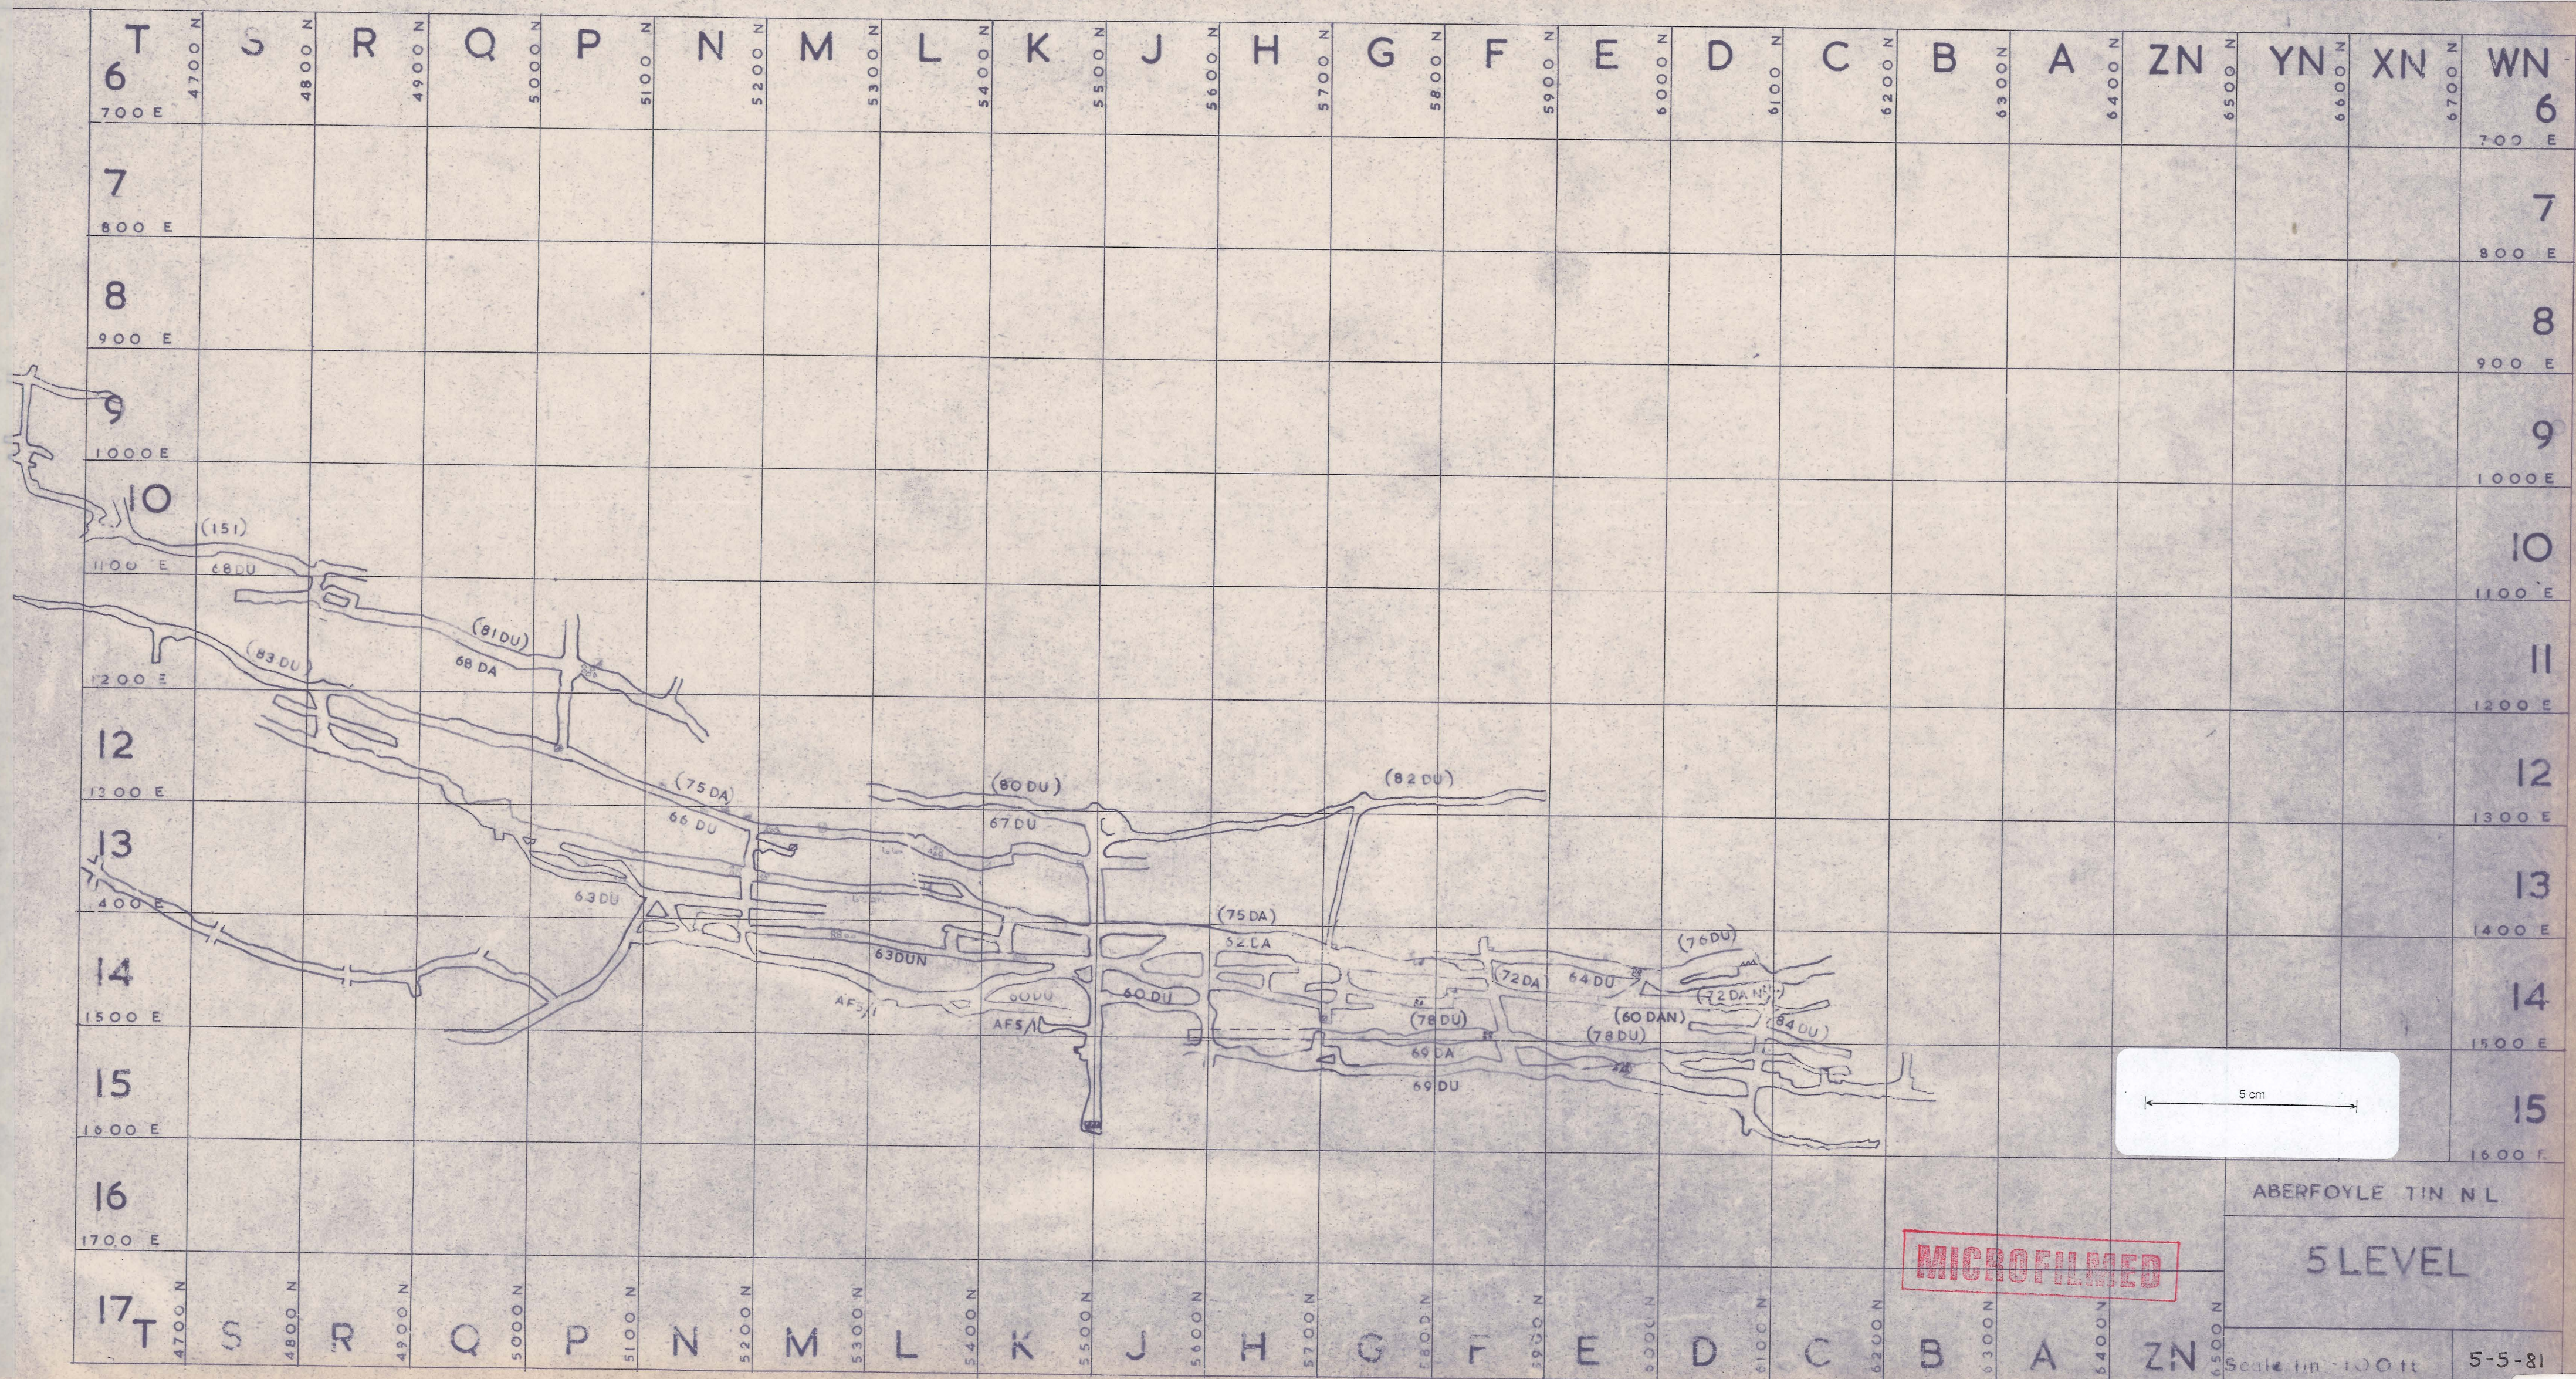


[illegible]

81025