ABERF_740

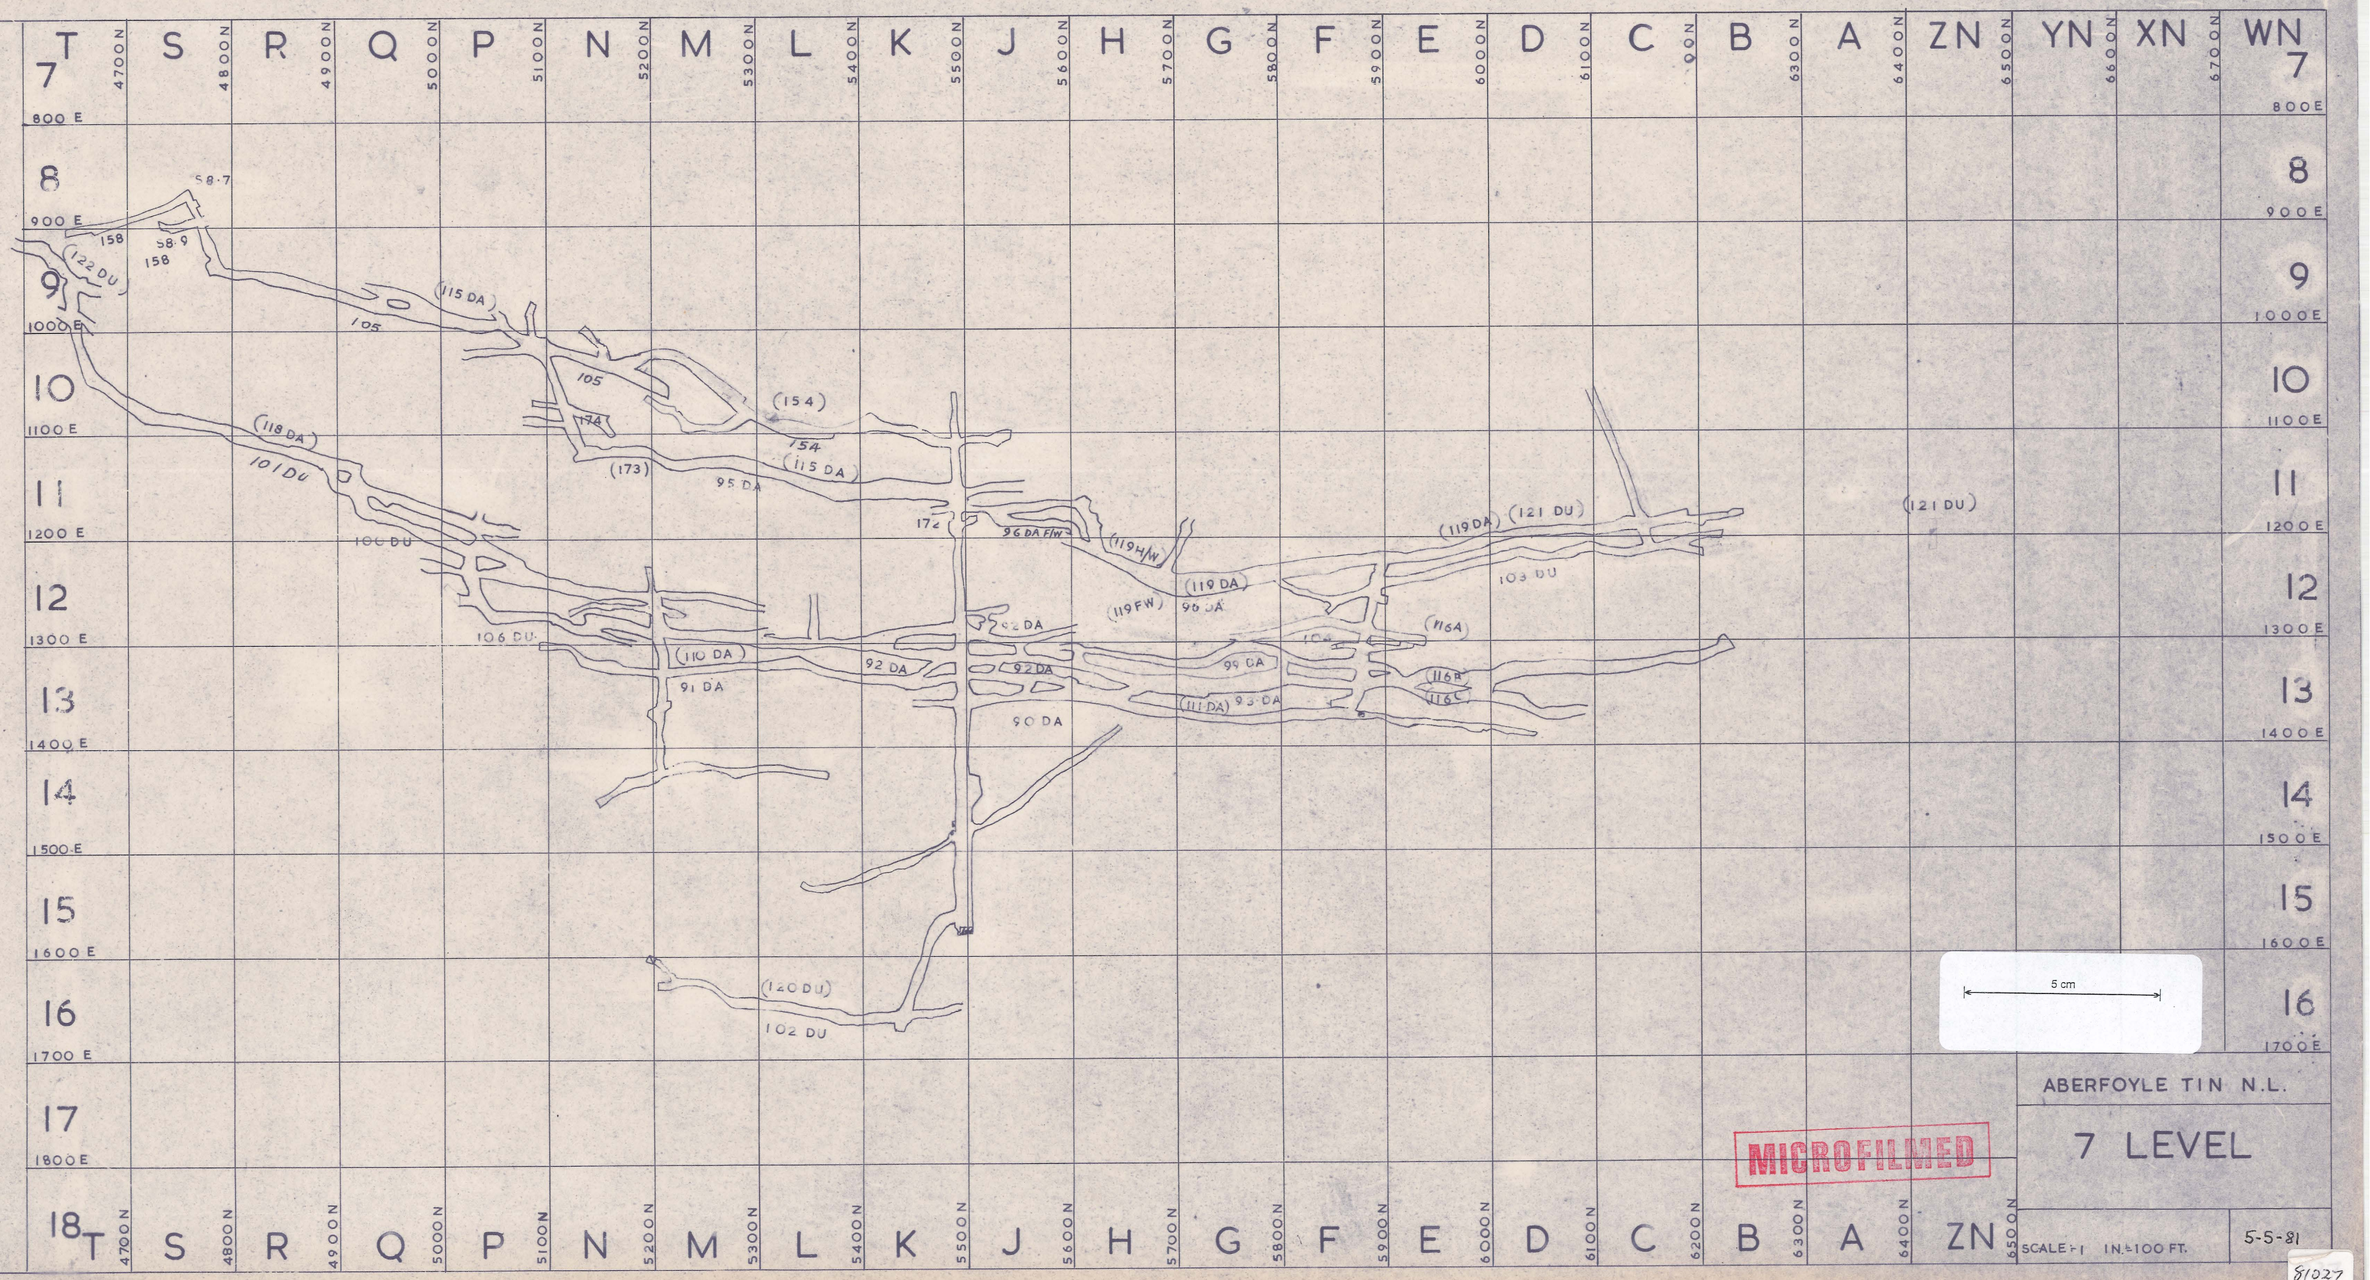
T S R Q P N M L K J H G F E D C B A ZN YN XN WN
4700N 4800N 4900N 5000N 5100N 5200N 5300N 5400N 5500N 5600N 5700N 5800N 5900N 6000N 6100N 6200N 6300N 6400N 6500N 6600N 6700N
7 800E
8 900E
9 1000E
10 1100E
11 1200E
12 1300E
13 1400E
14 1500E
15 1600E
16 1700E
17 1800E
18
58·7
158
58·9
158
(122 DU)
(115 DA)
105
105
174
(154)
154
(115 DA)
(118 DA)
101 DU
(173)
95 DA
106 DU
172
96 DA F/W
(119 H/W)
(119 DA)
(121 DU)
(121 DU)
103 DU
(119 DA)
(119 FW)
95 DA
92 DA
(116A)
106 DU
(110 DA)
92 DA
92 DA
99 DA
(116B)
(116C)
91 DA
(111 DA)
93 DA
90 DA
(120 DU)
102 DU
5 cm
ABERFOYLE TIN N.L.
7 LEVEL
SCALE 1 IN. = 100 FT.
5-5-81
MICROFILMED
81027