


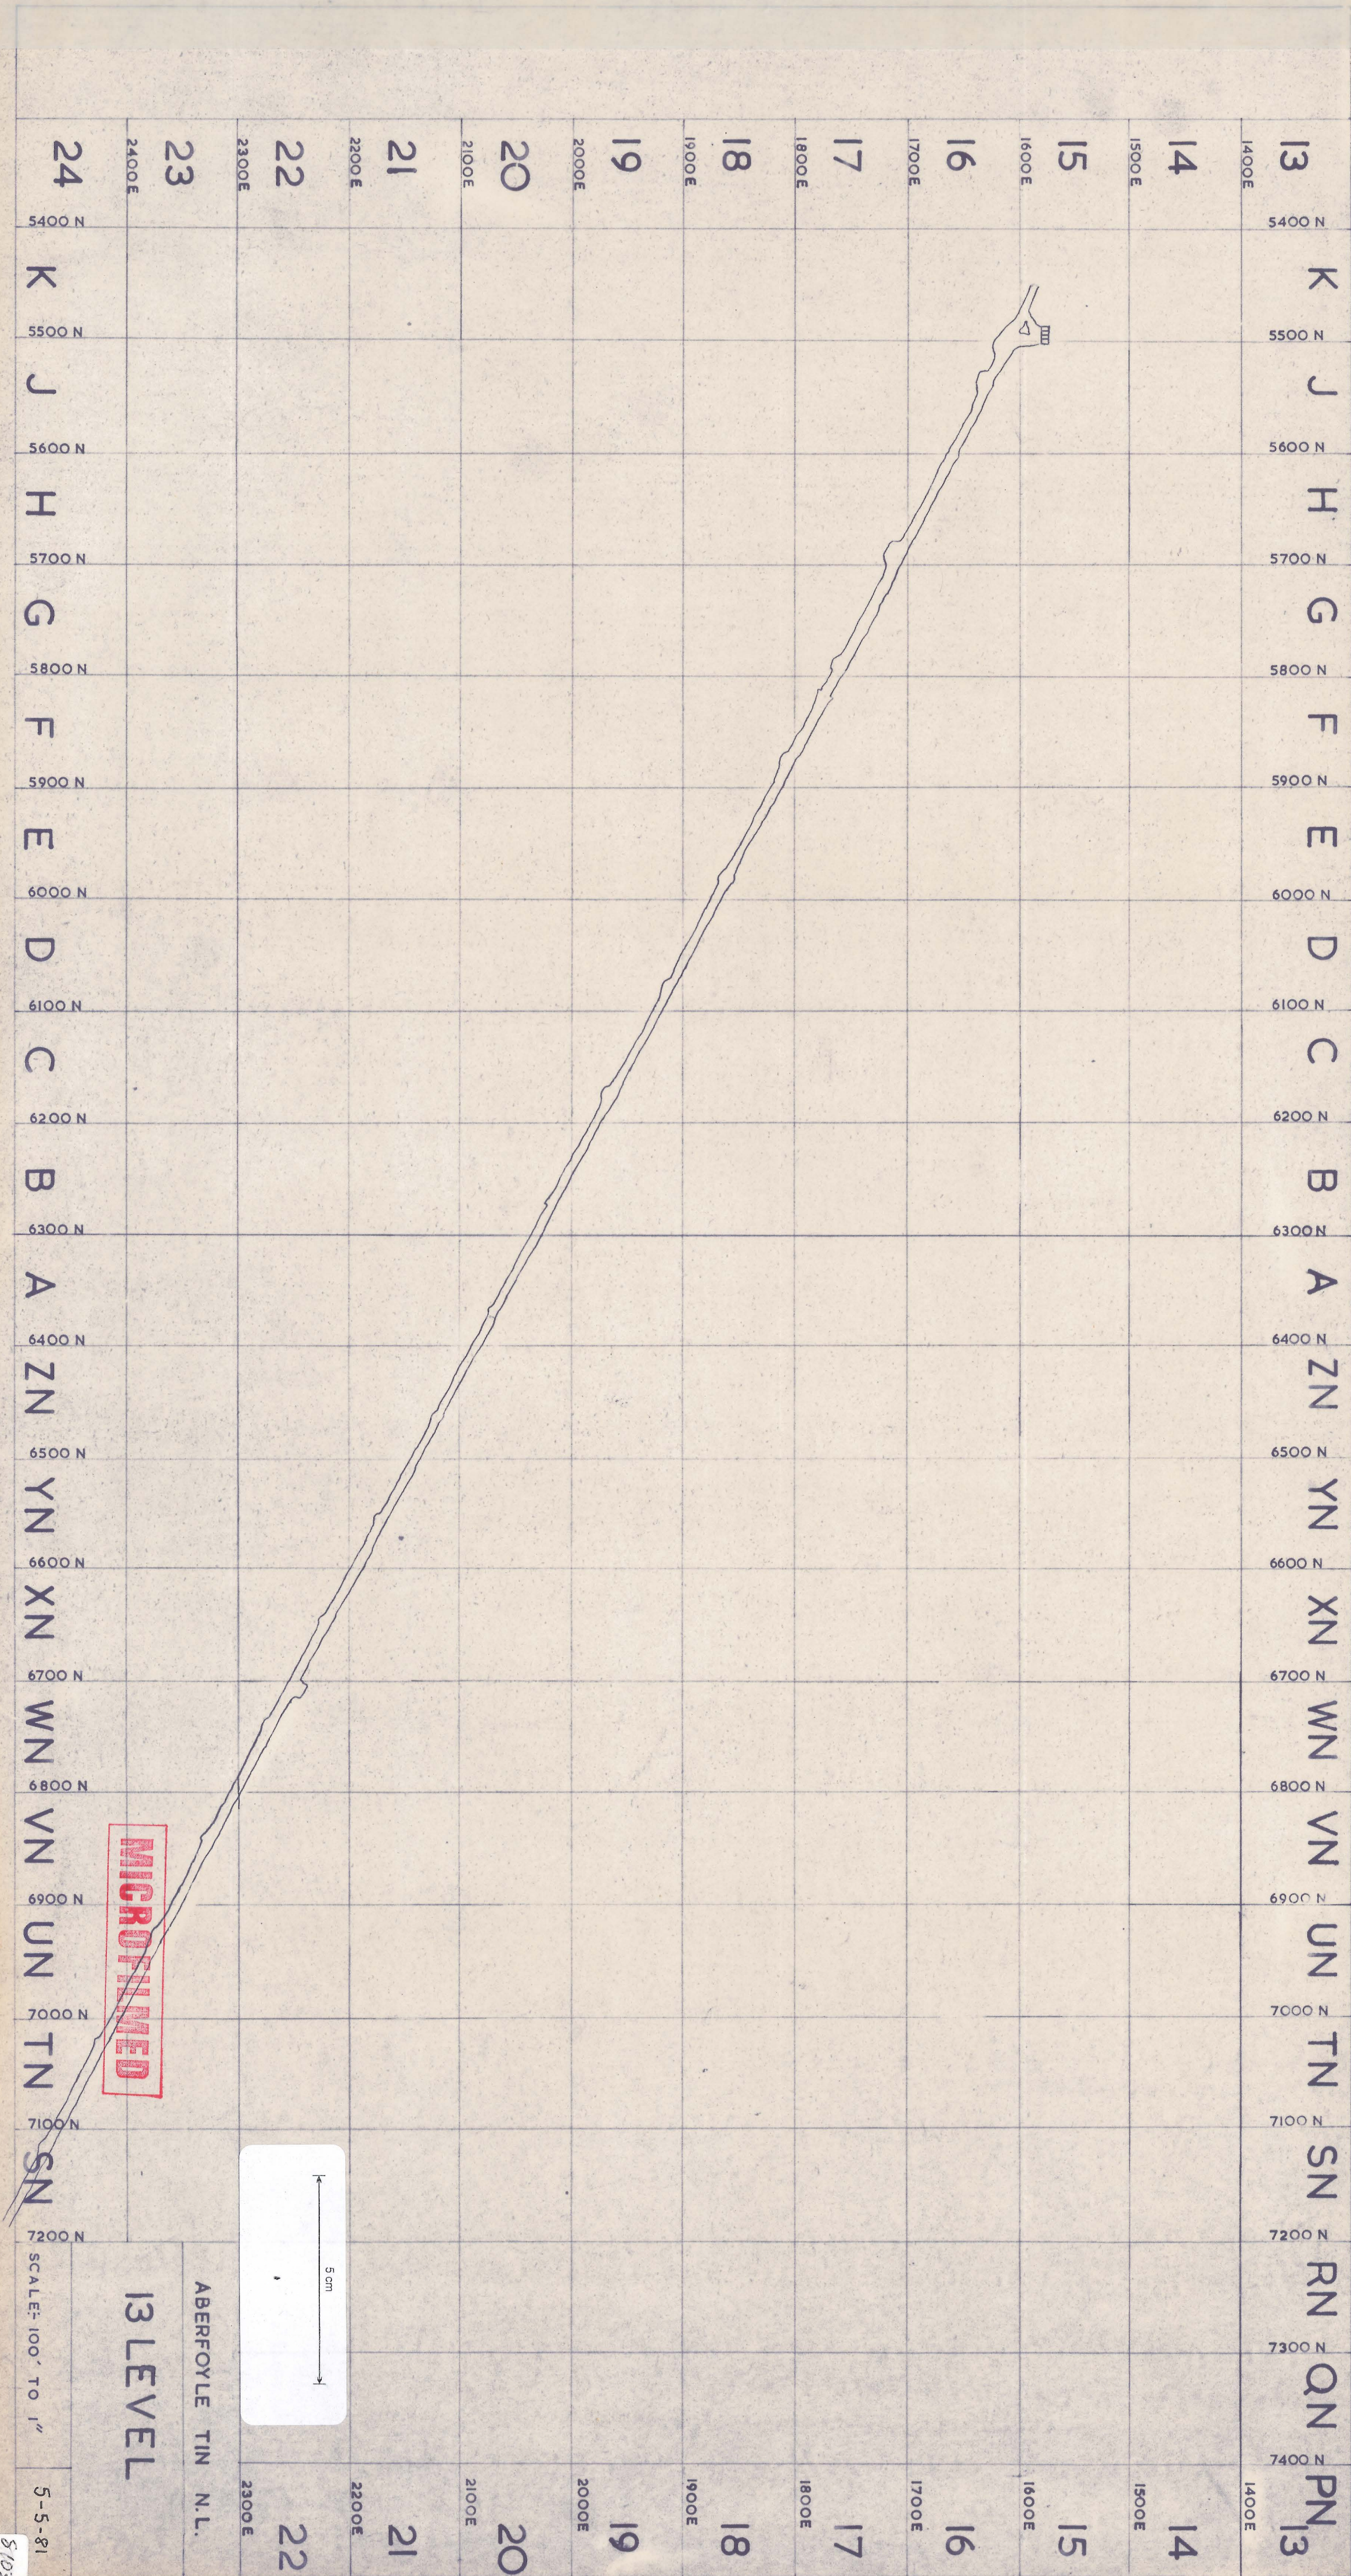

MICROFILMED

13 LEVEL

ABERFOYLE TIN N.L.

SCALE: 100' TO 1"

5-5-81

51032