
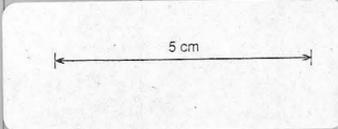


ABERF_748

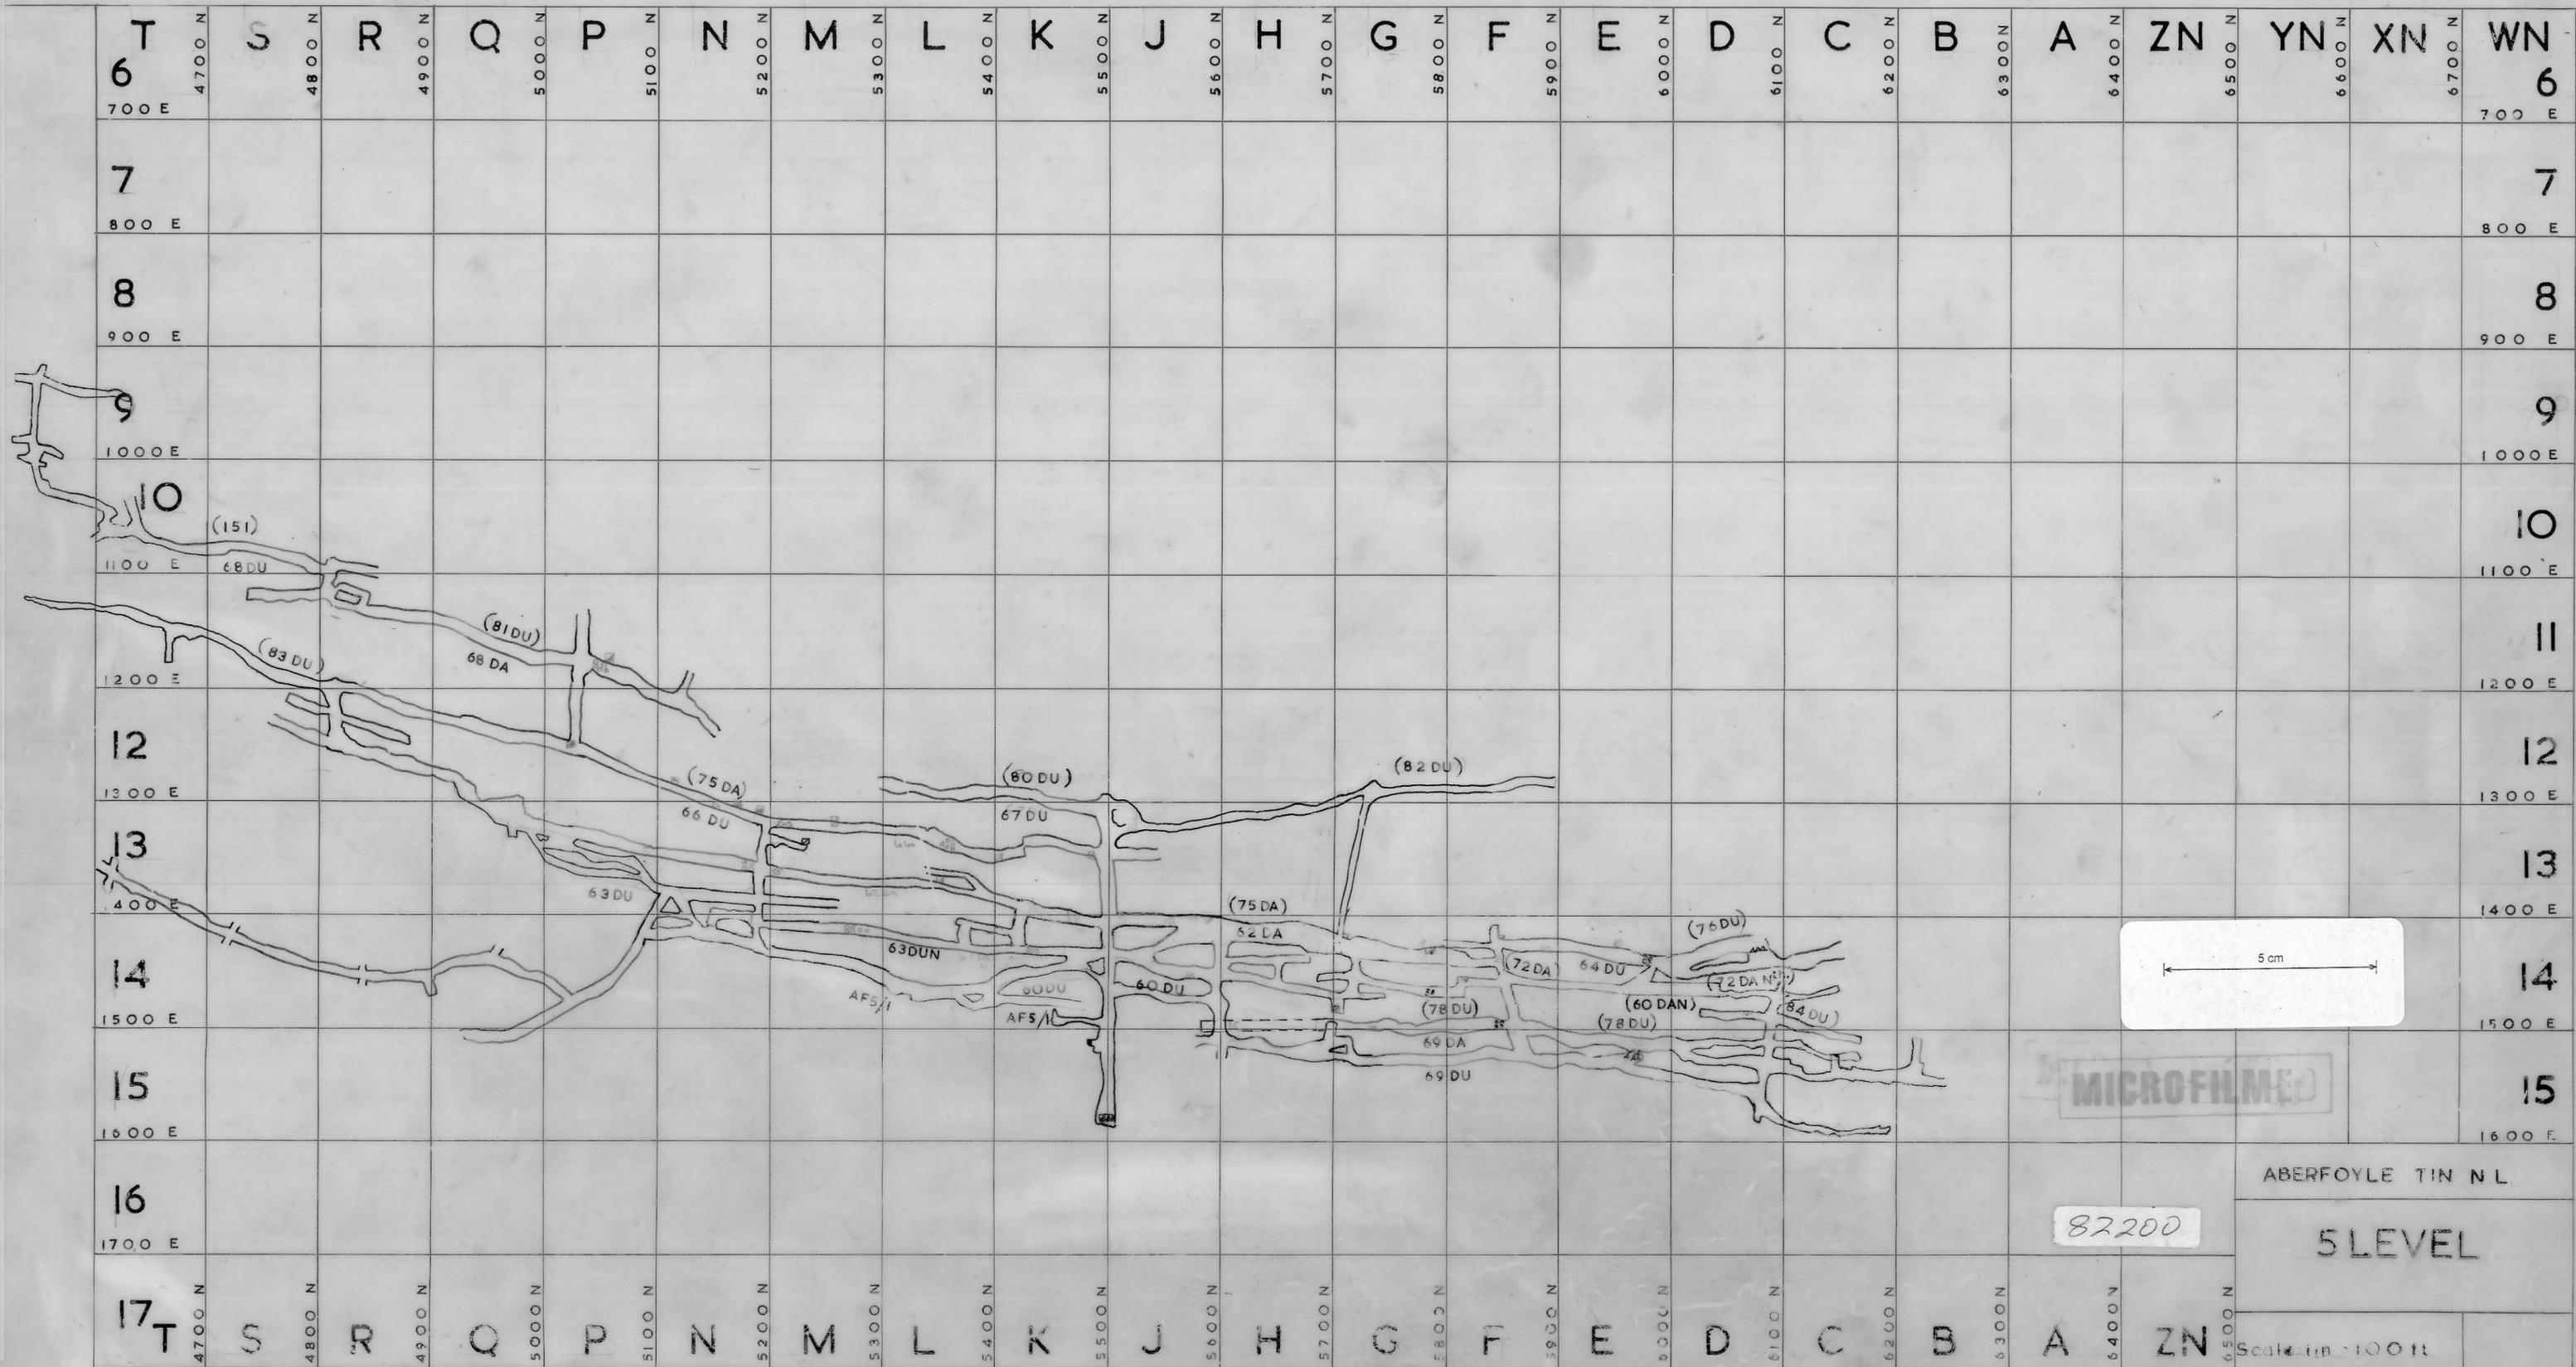

MICROFILMED

ABERFOYLE TIN N L

82200

5 LEVEL

Scale 1 in = 100 ft