


ABERF_757

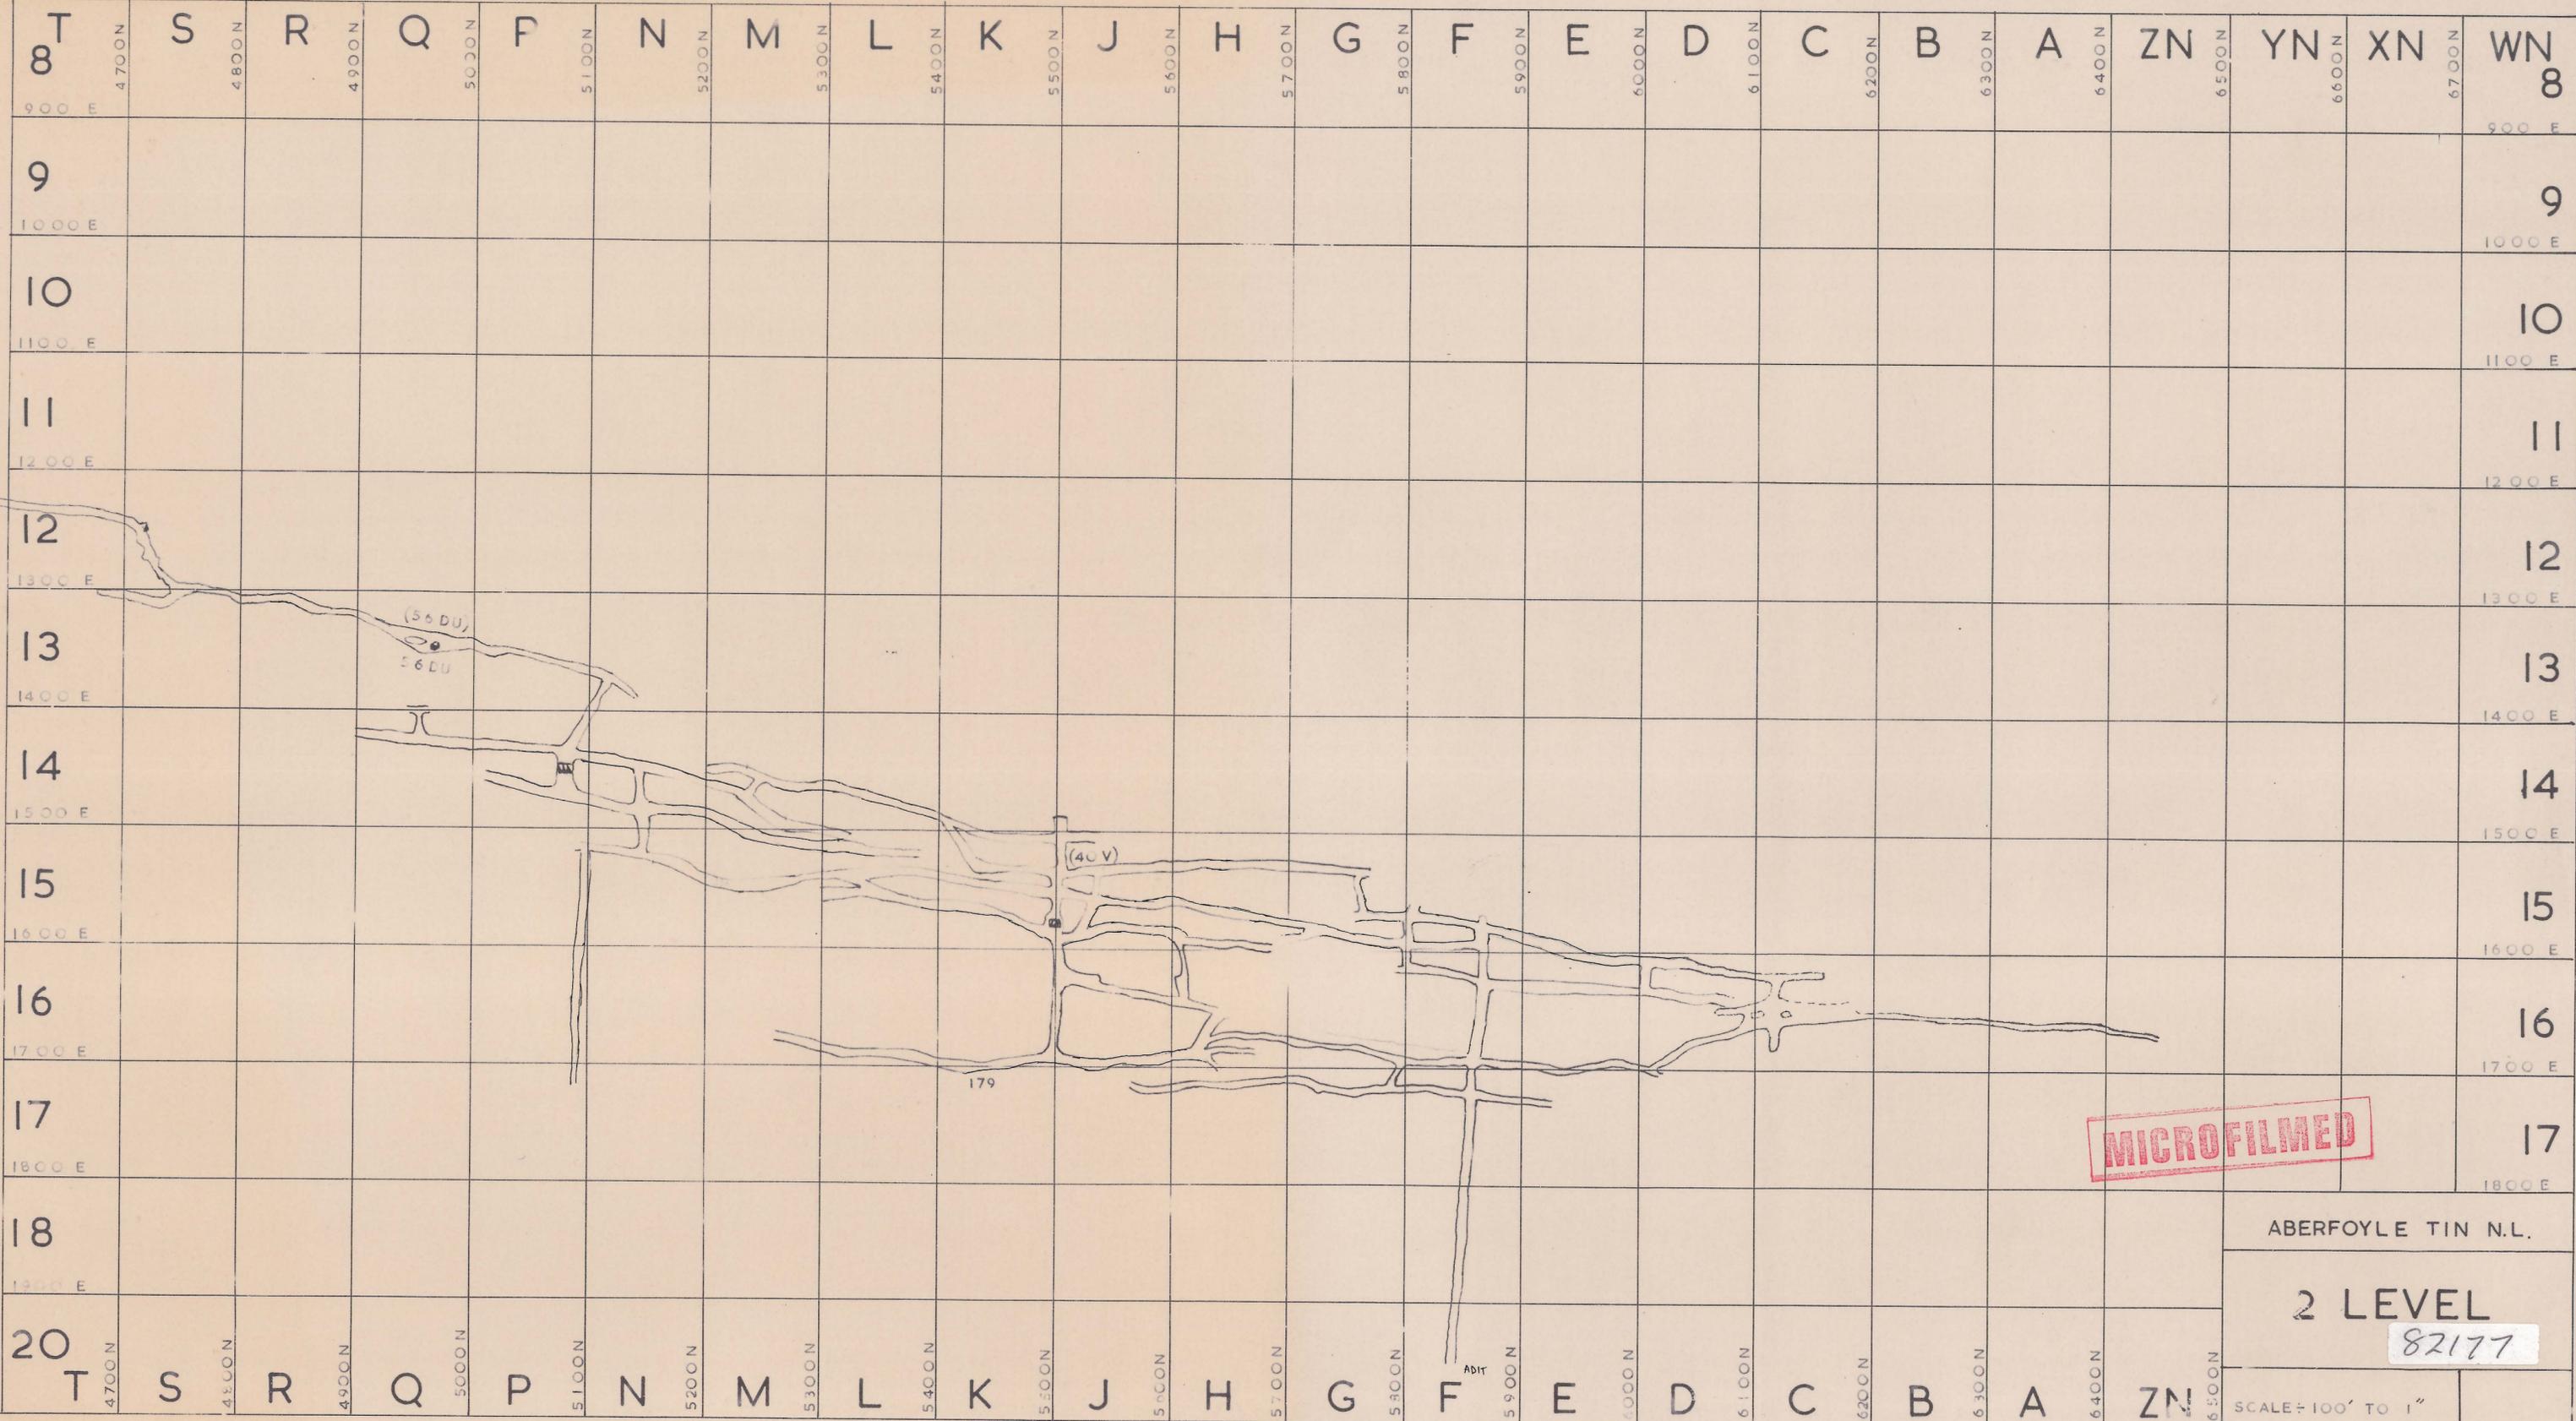

MICROFILMED

ABERFOYLE TIN N.L.

2 LEVEL

82177

SCALE = 100' TO 1"