


ABERF_758

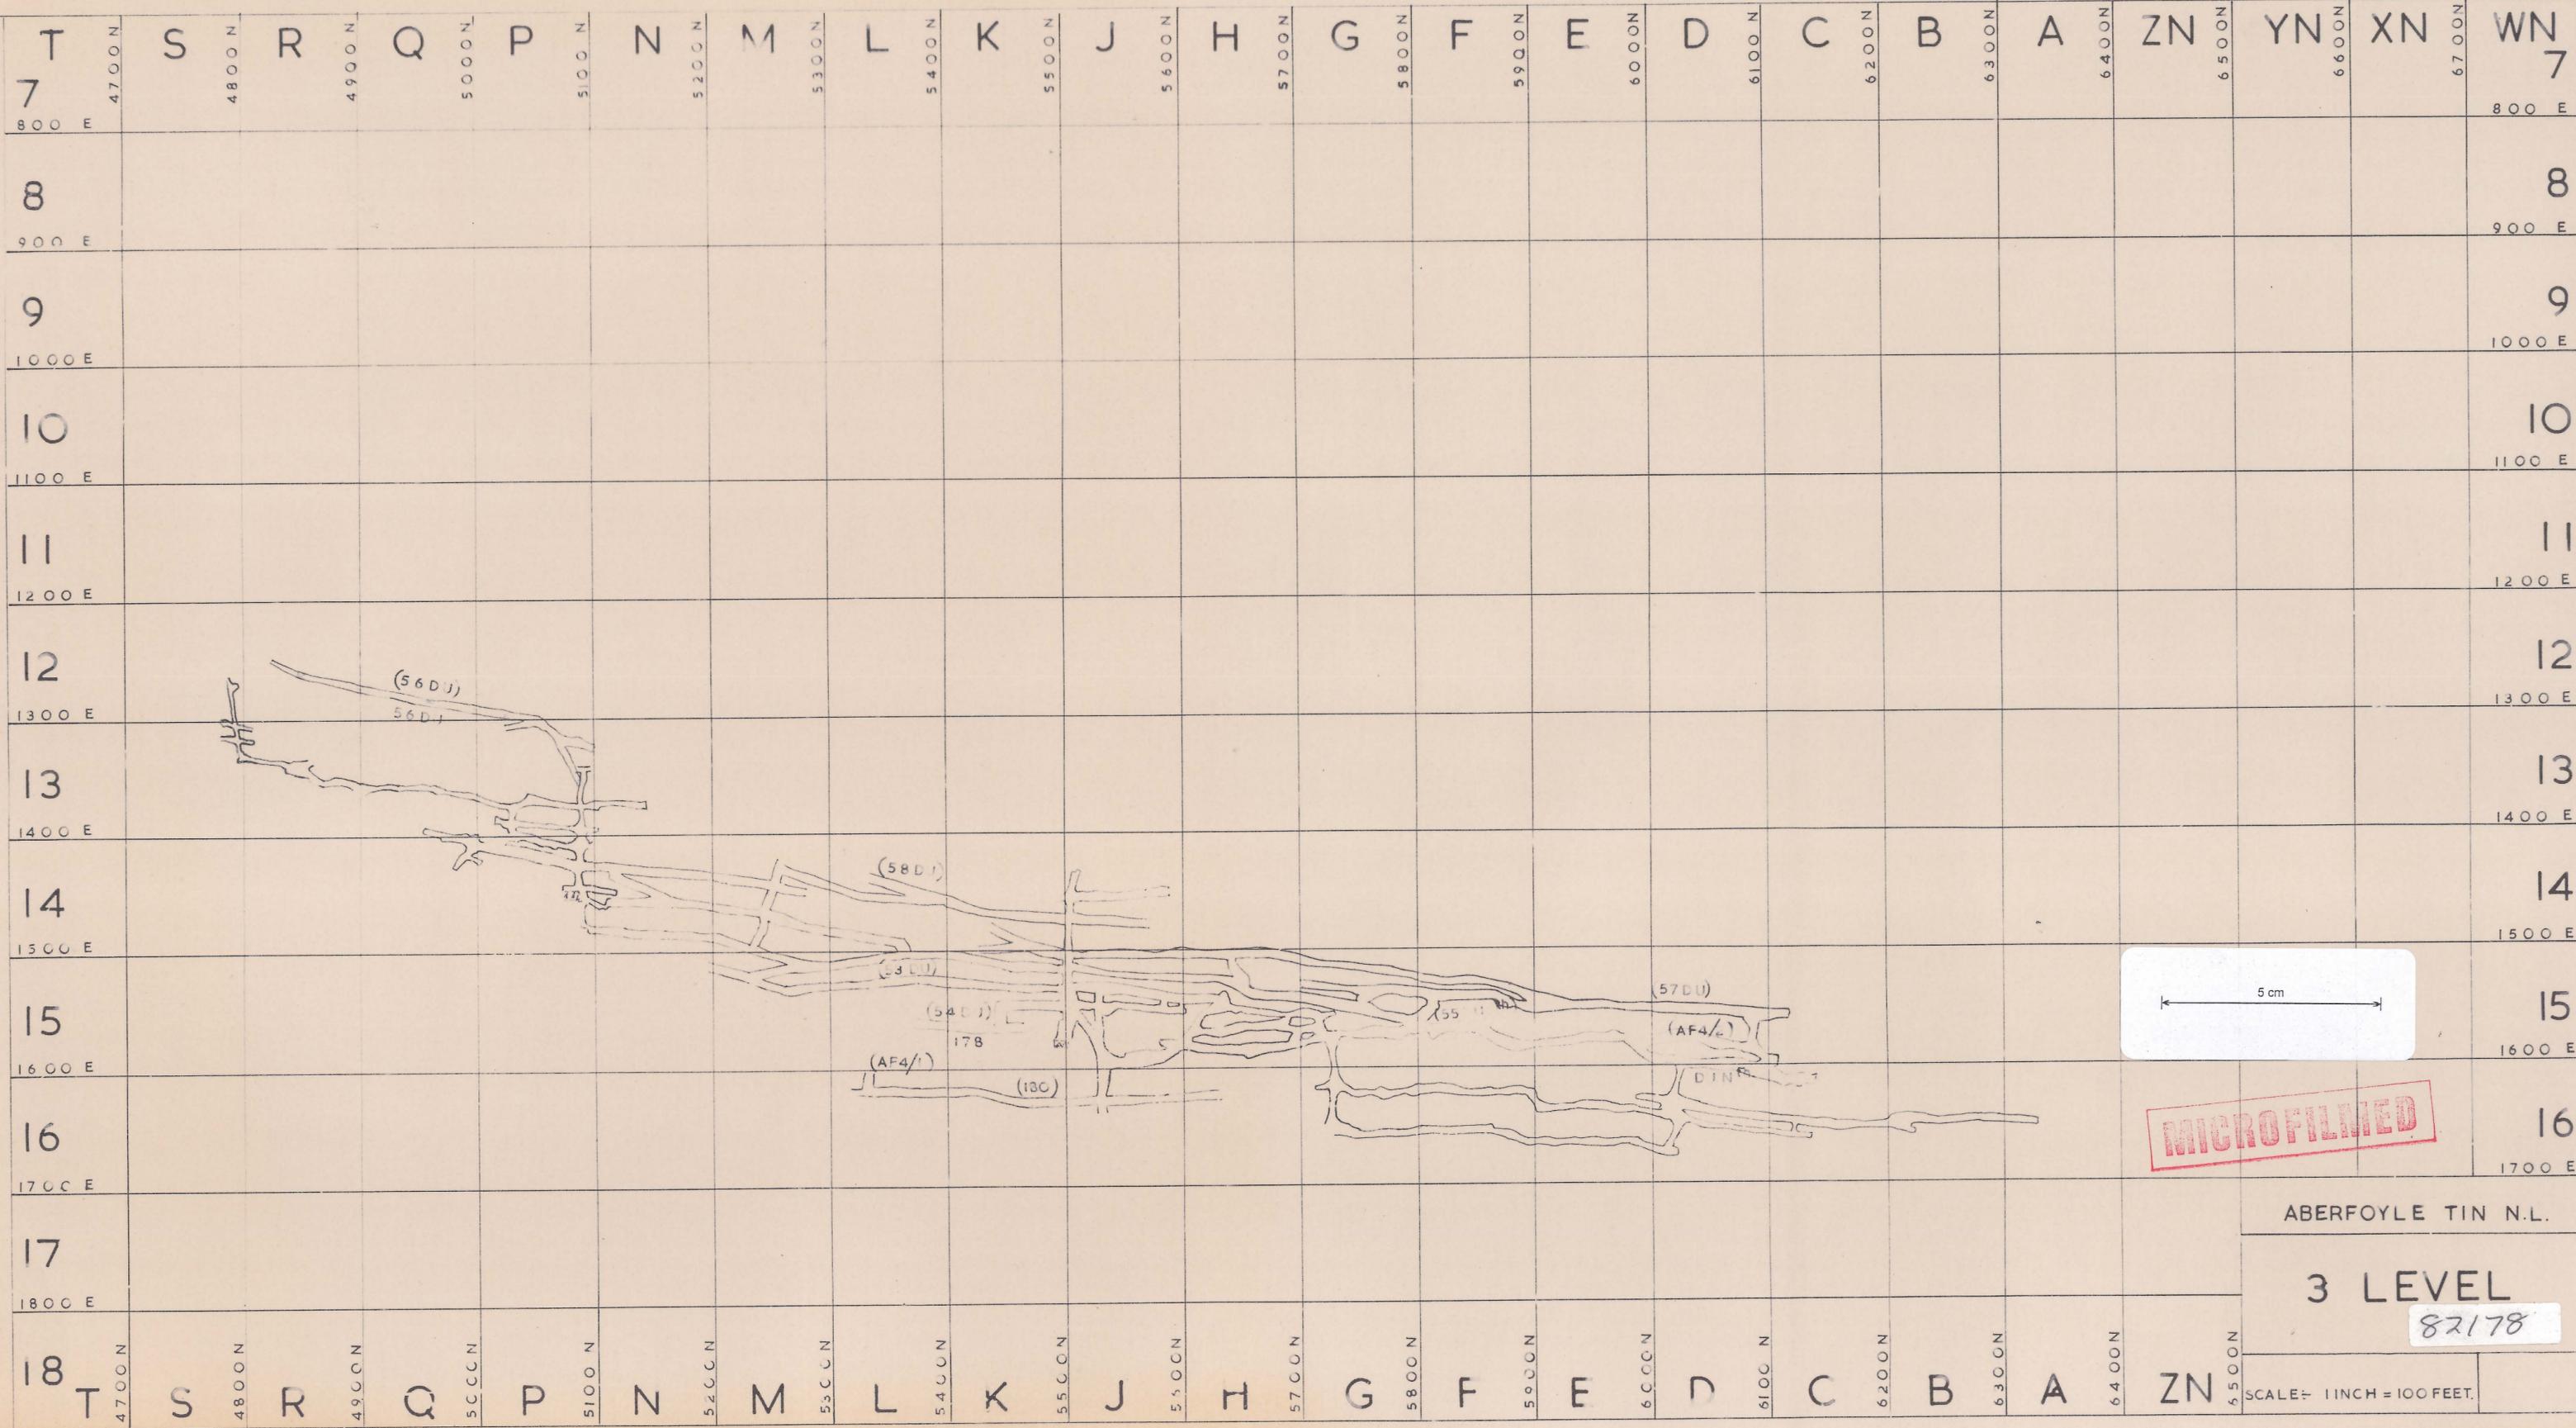

ABERFOYLE TIN N.L.

3 LEVEL

82178

SCALE: 1 INCH = 100 FEET.