
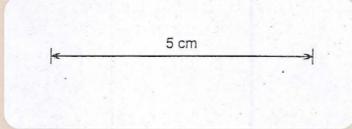


ABERF_759

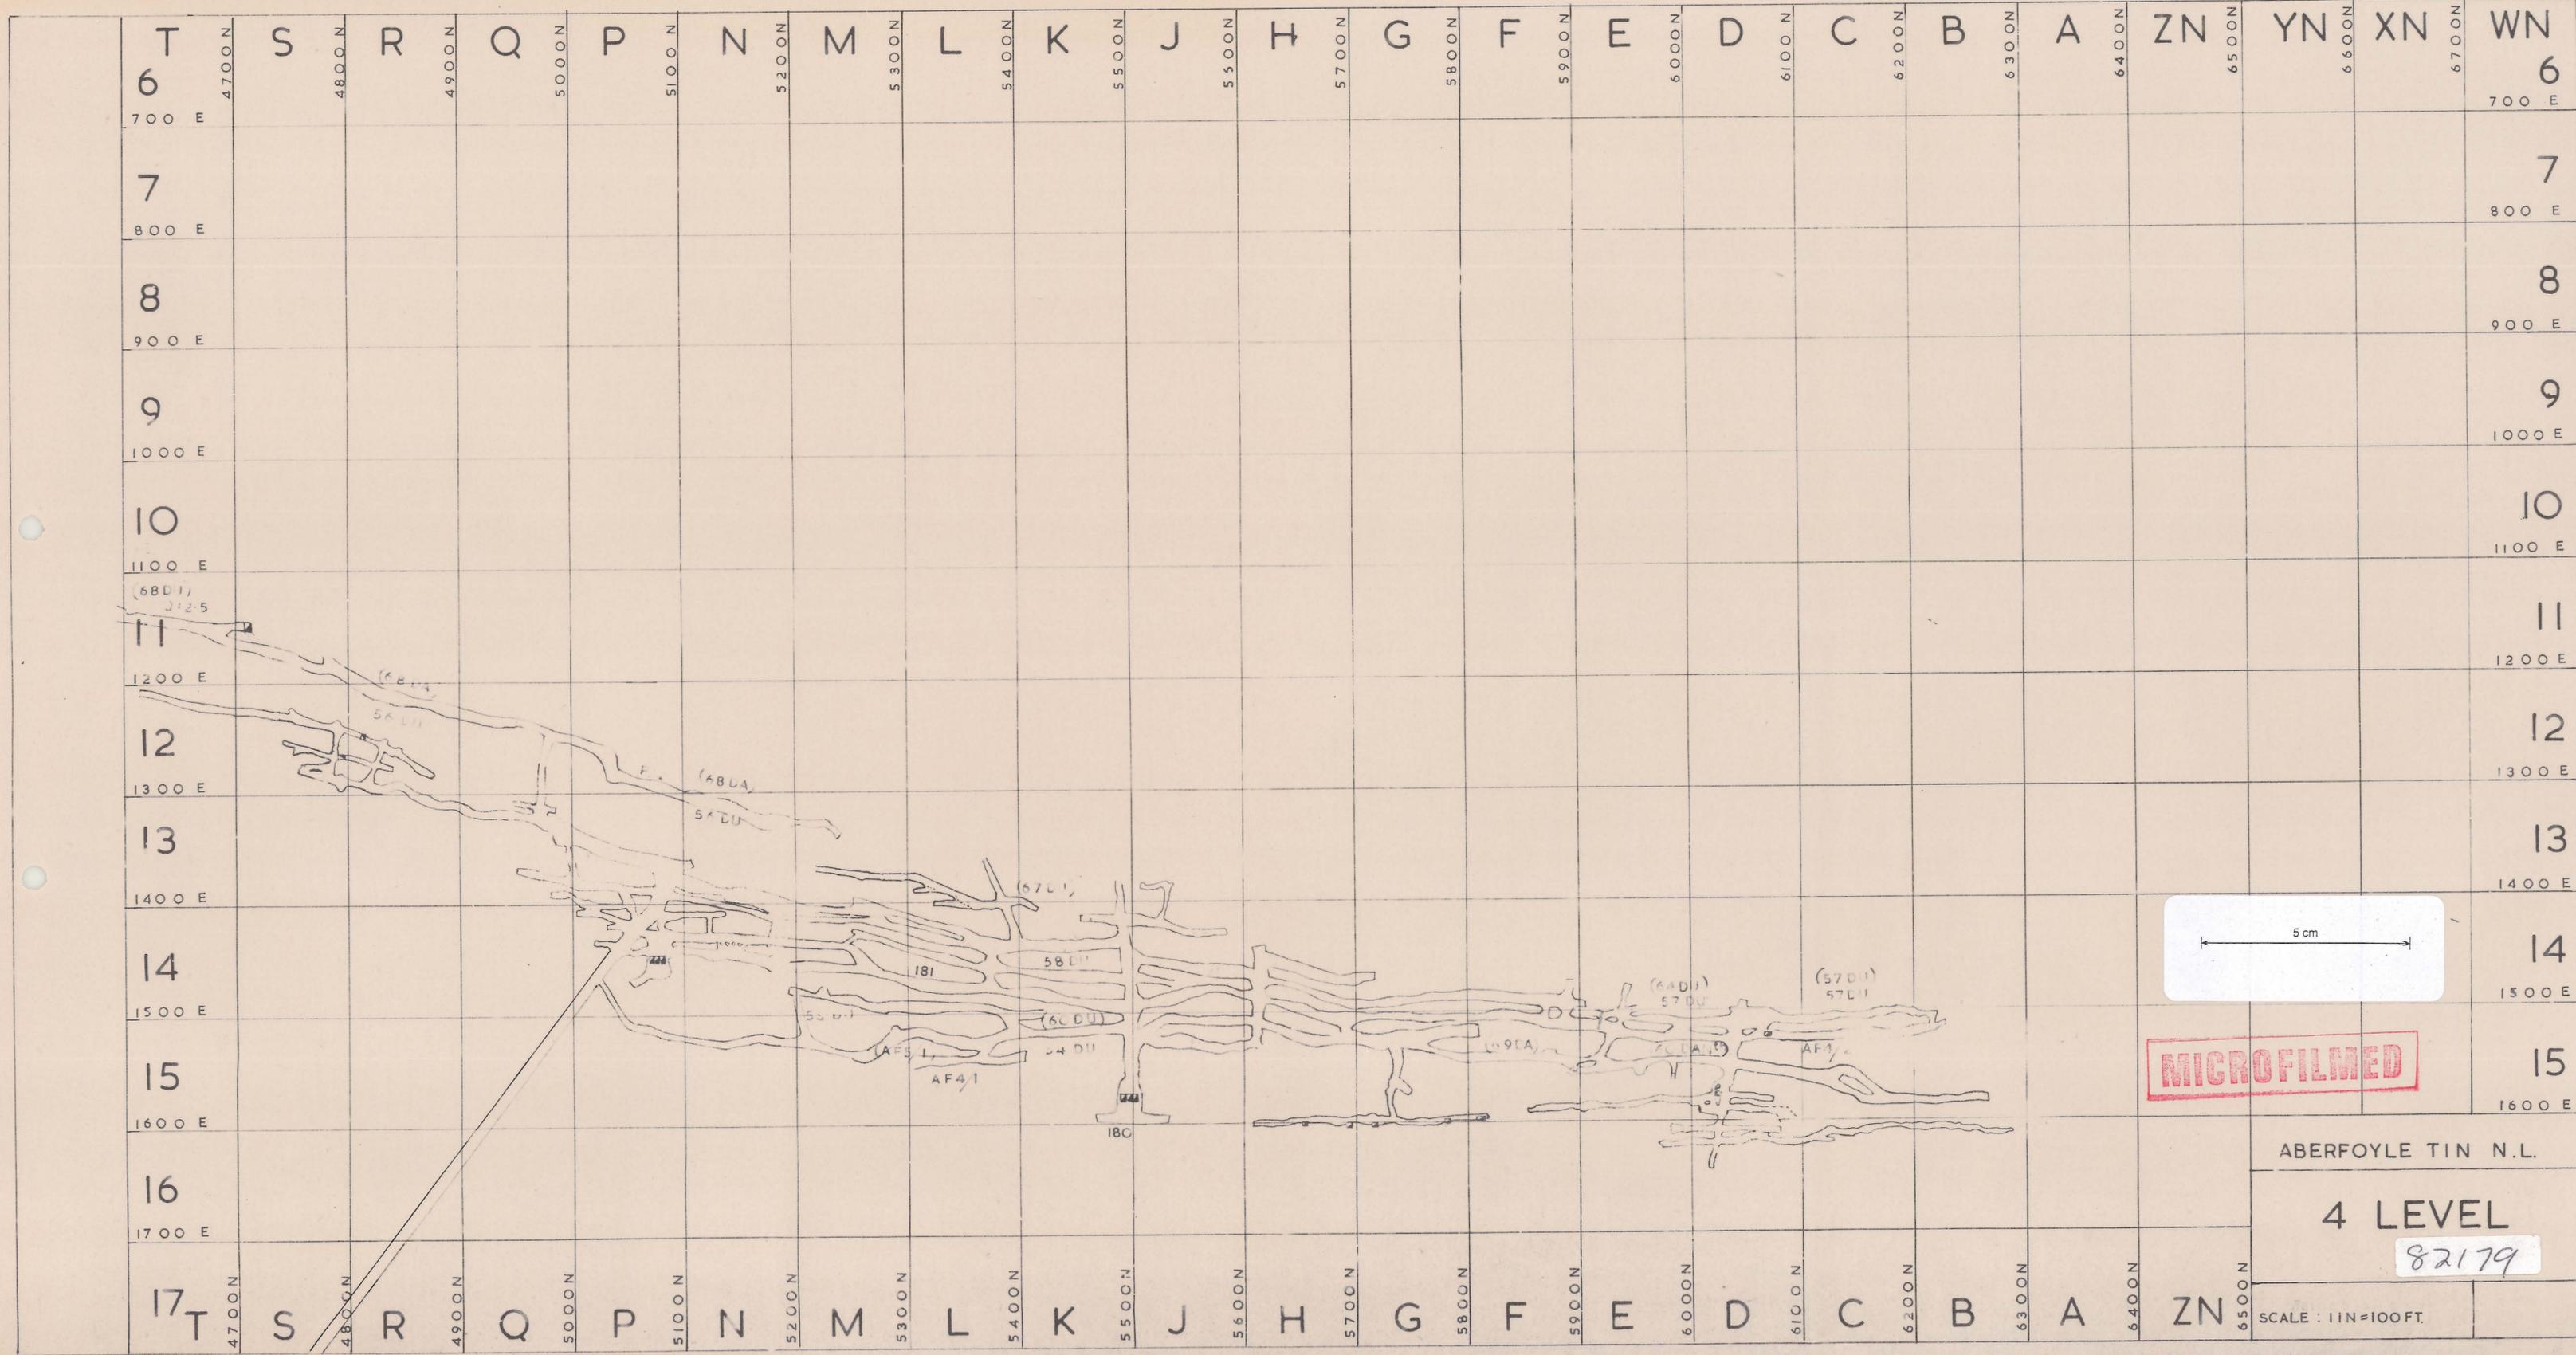

MICROFILMED