


ABERF_760

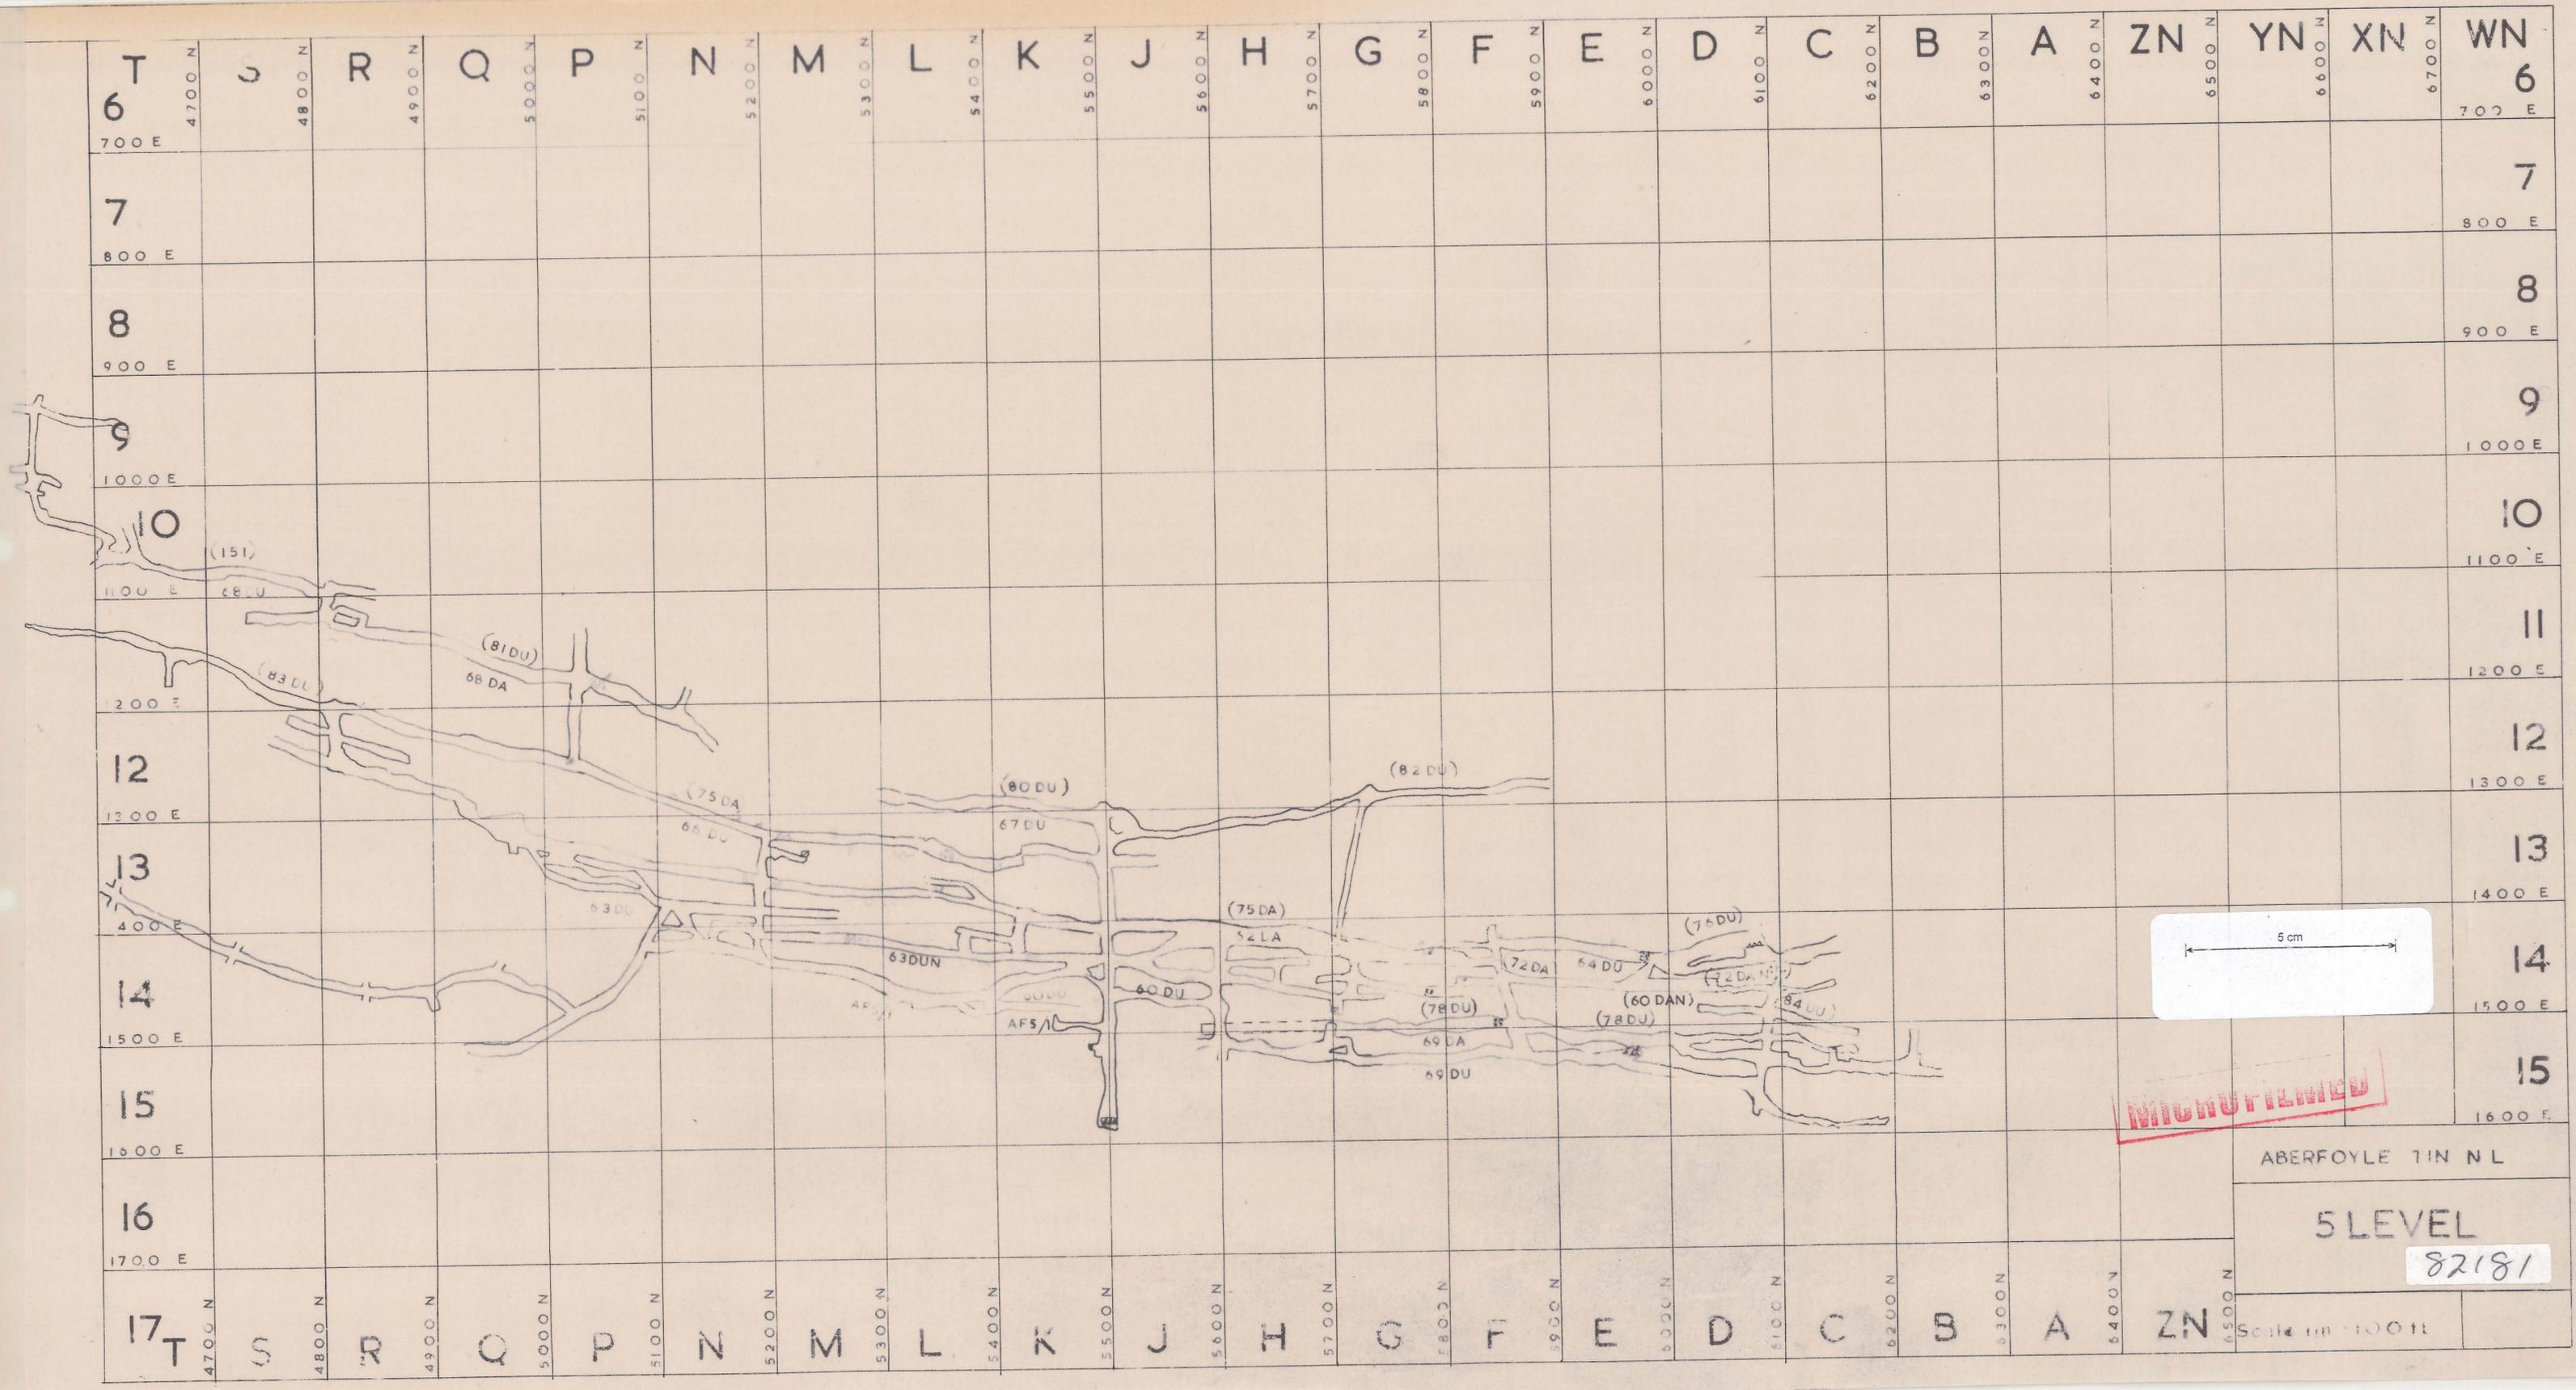

MICROFILMED

ABERFOYLE TIN N L

5 LEVEL

82181

Scale 1:100 ft